




SULA S1.1. 1:20

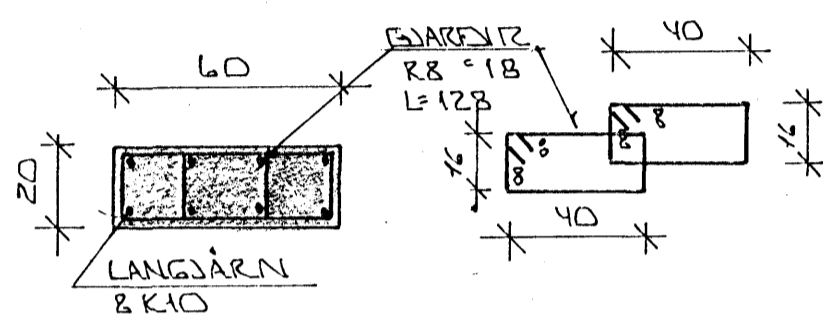


SULA S2.1. 1:20

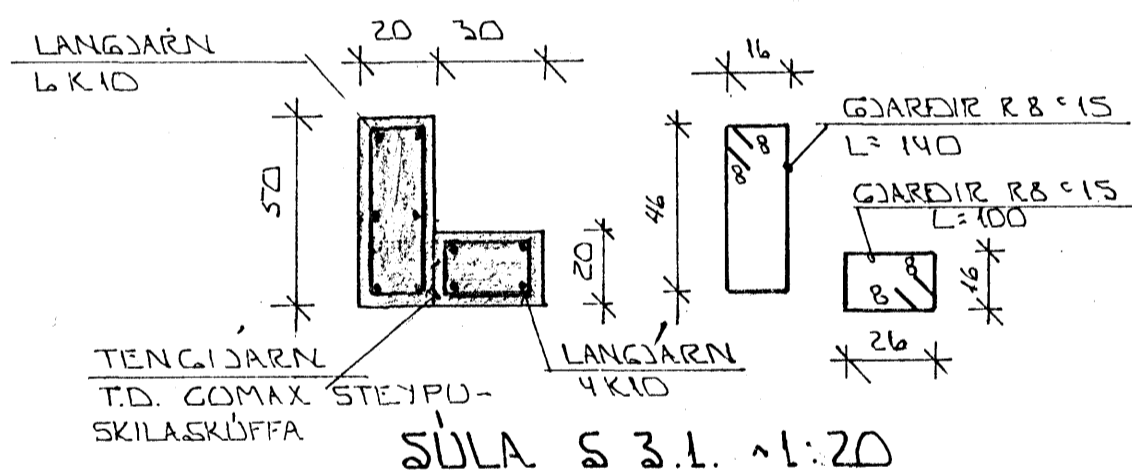


SULA S3.1. 1:20

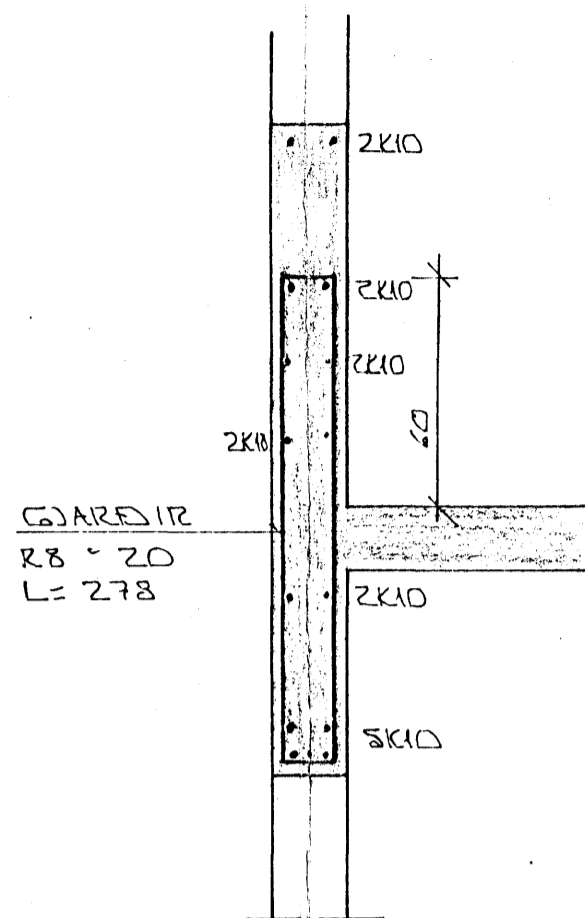

SNID 4 1:20

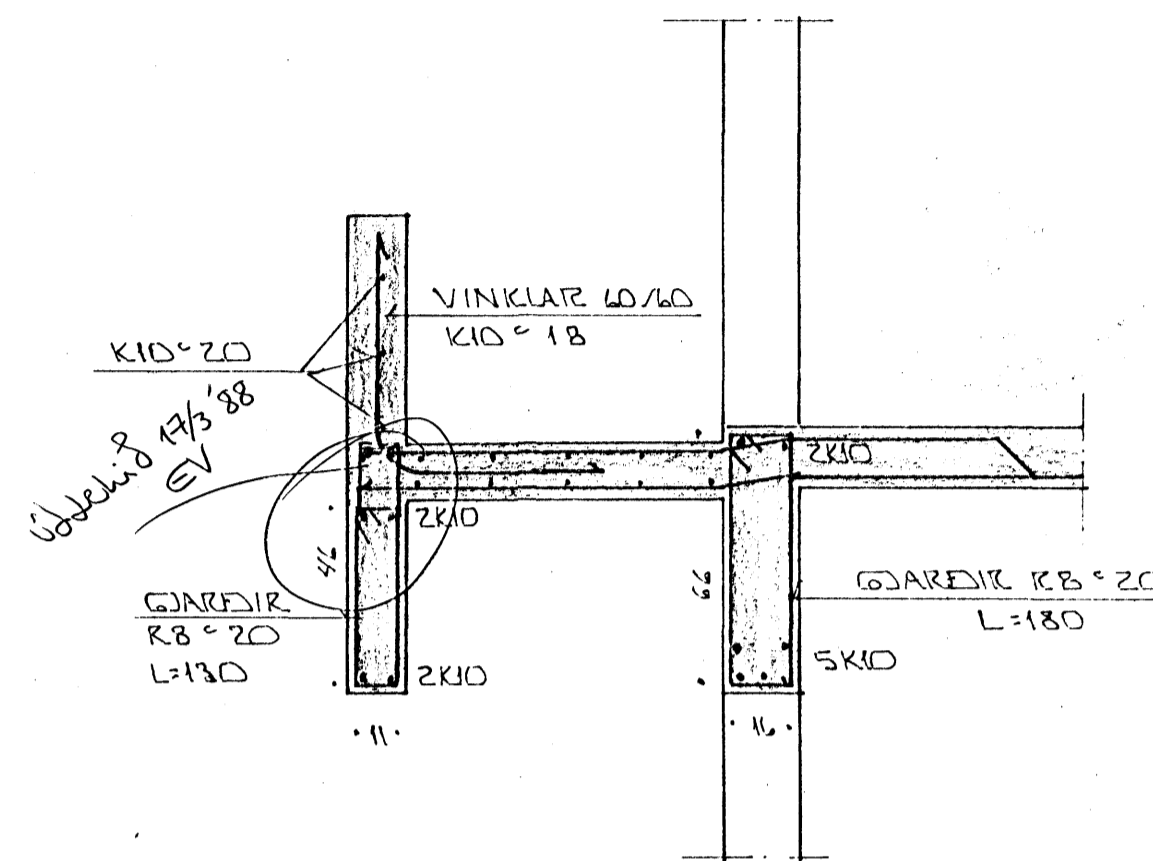

SNID 6 1:20 (SVALIR)

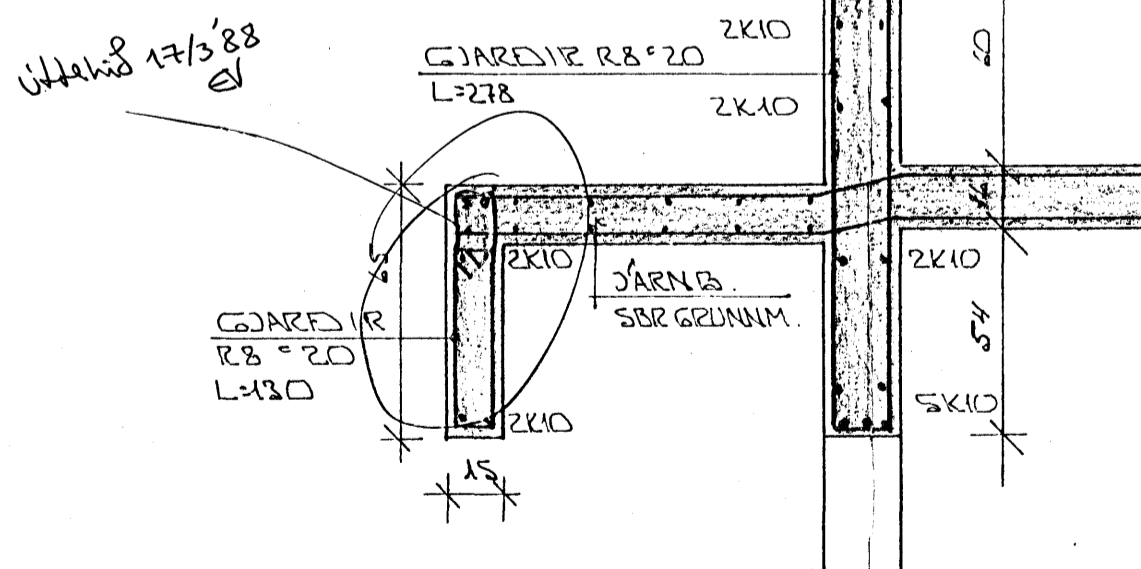

SNID 5 1:20

ATH.



BR.NR.	DAGS	EDLI BREVTINGAR	SIGN.
BÆJARHRAUN 12 HAFNARFIRÐI			DAGS. JAN' 88
BURDARVIK 1. HÆÐ			HANNAÐ
SNID OG BÆRMYNDIR.			TEIKNAD 10
MÆLIKV. 1:20			VERK NR. 8741
SIGURÐUR ÞORLEIFSSON TEKNIFRÆÐINGUR F.T.F.I.			BLADNR.
STRANDGÖTU 11 HAFNARFIRÐI SÍMI 54751			L-06