
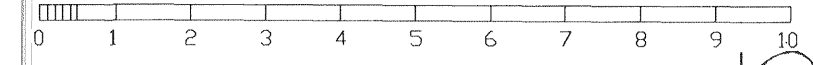
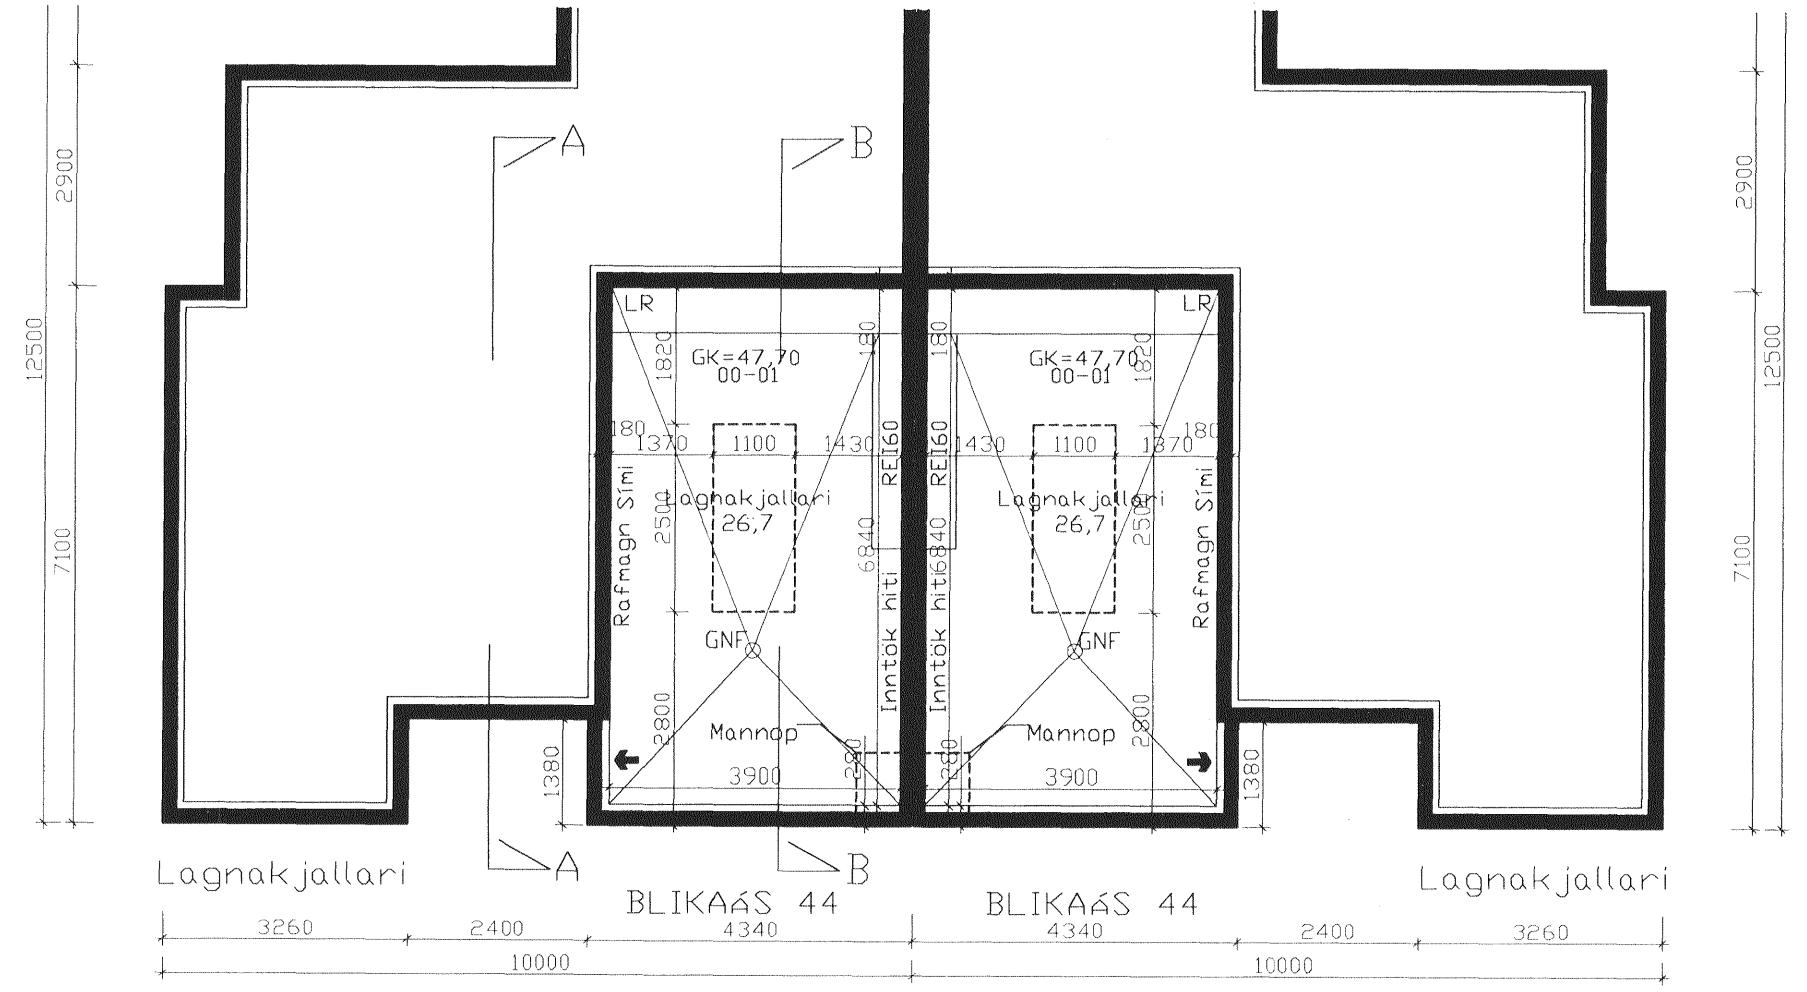
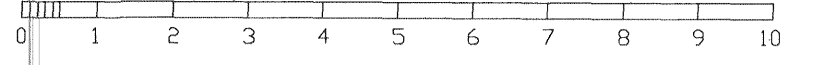
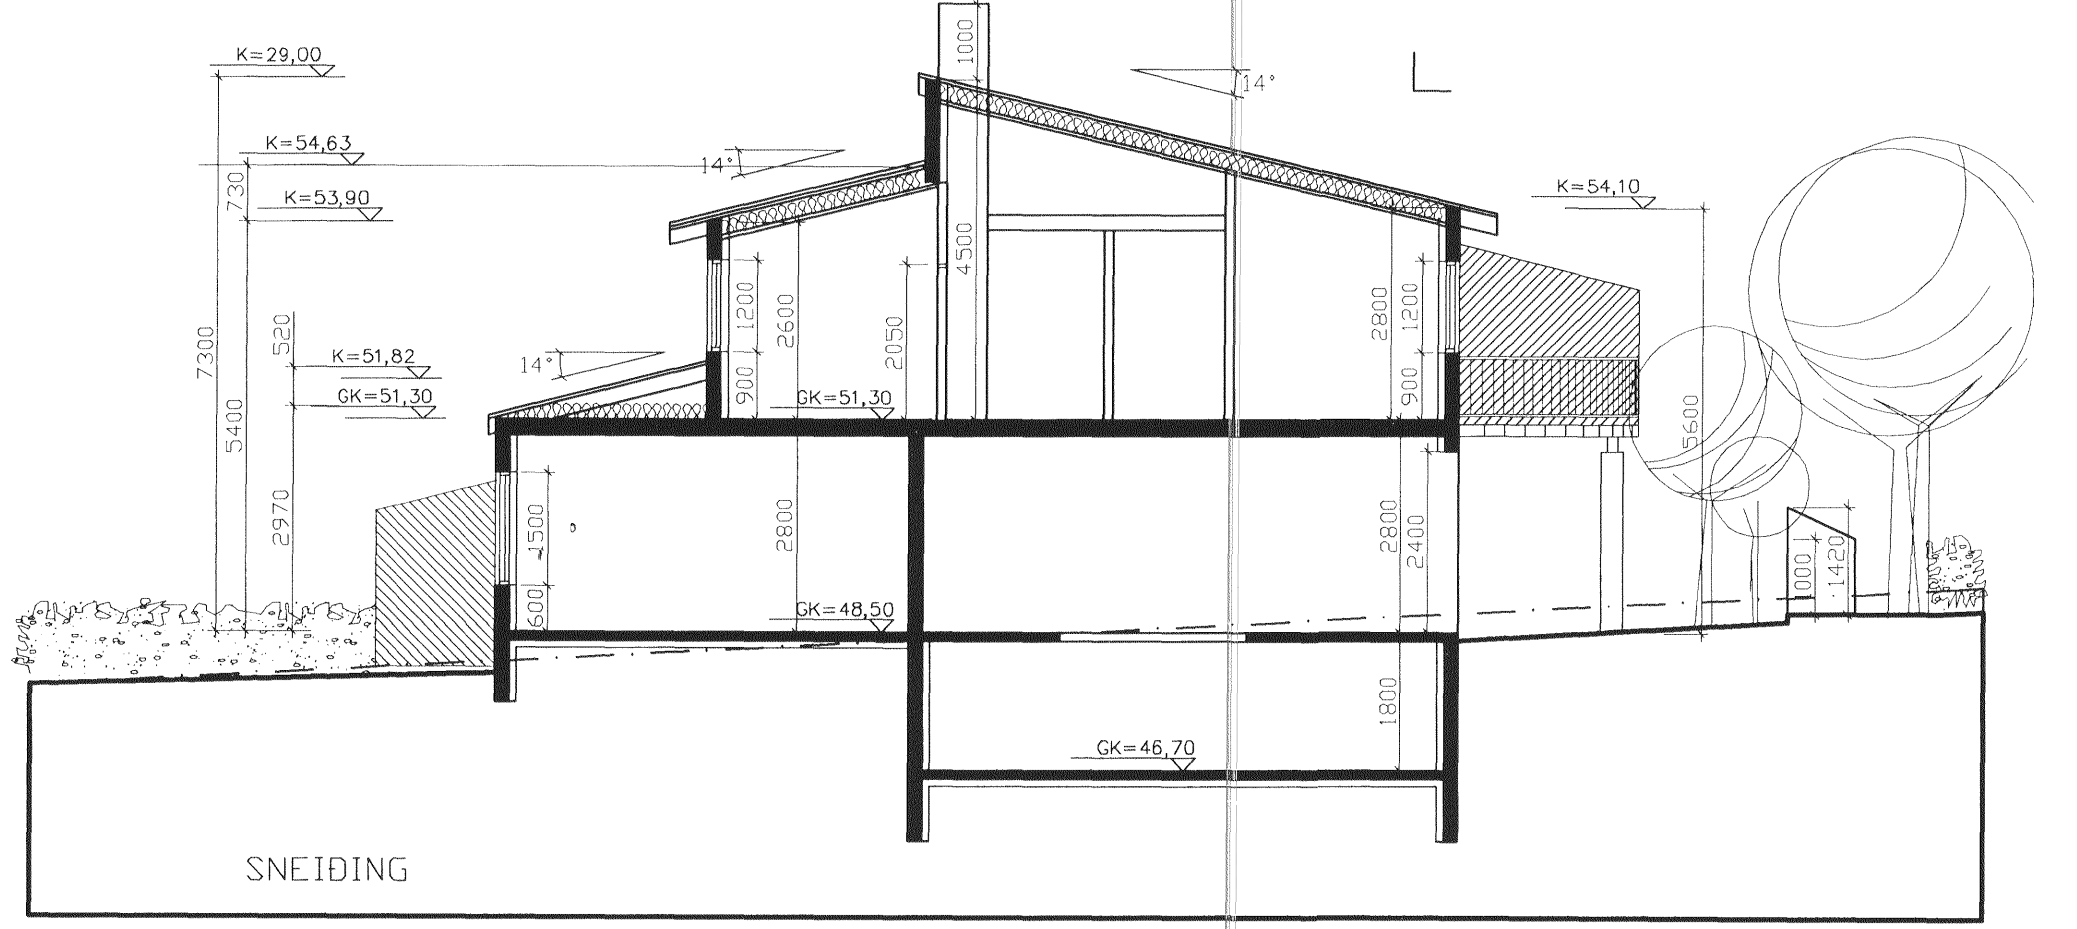


Samþykkt þann

27 APR 2011

Byggingarlausnir  
F.h. S. Þorsteinsson

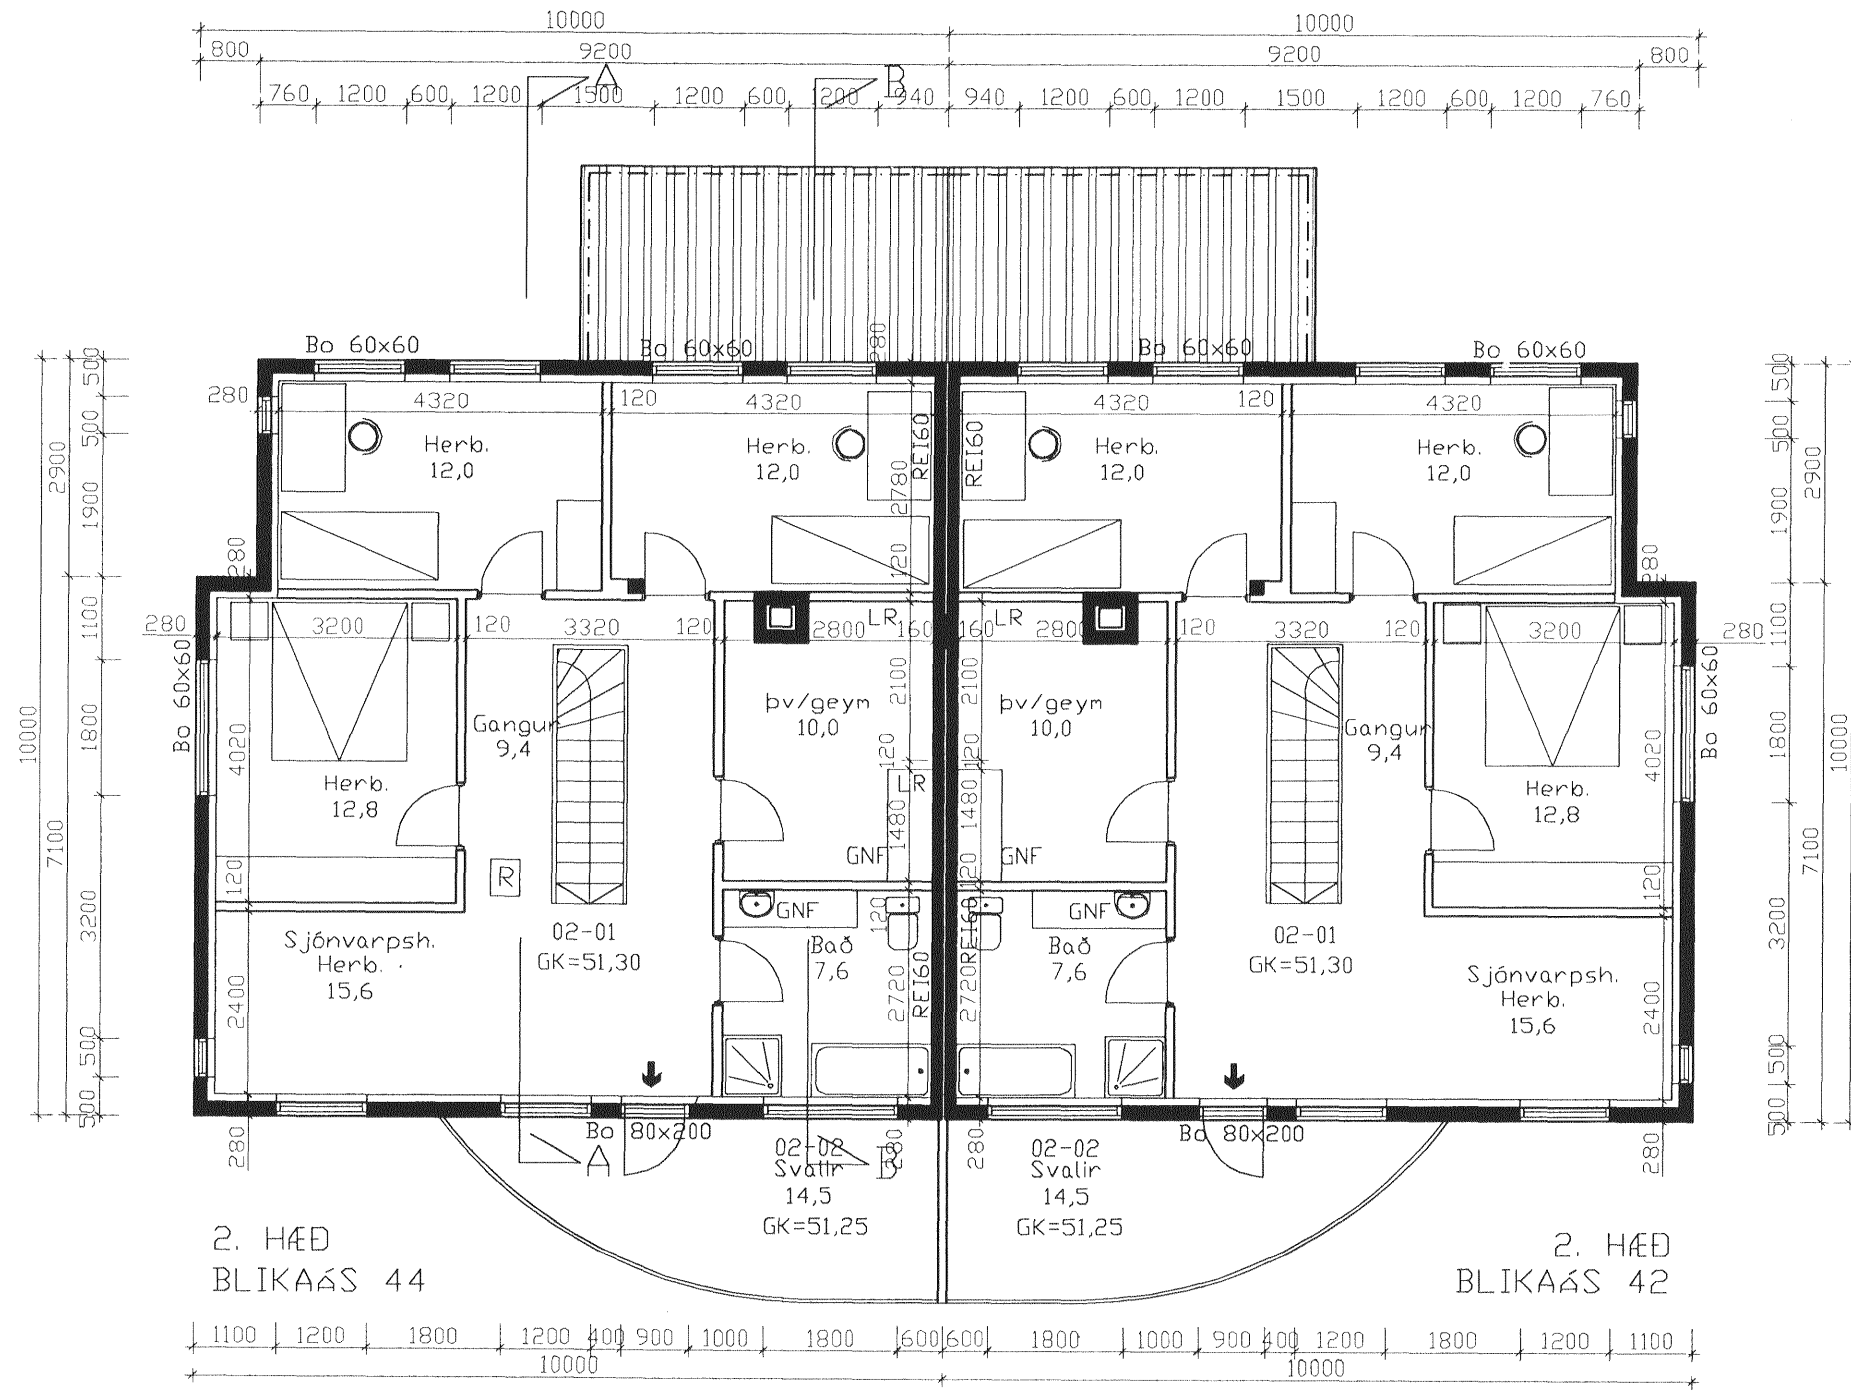

B 26.3.11 ff Þvottah. og geyn lagfærð, olfusklja f Jarlægð.  
A 28.3.00 ff Lagnakjallari settur undir bílageymslu  
breytt dags. teikna? lýsing

teiknistofan Studio F

102B  
BLIKAÁS 42-44  
GRUNNMÝND EFRÍ HÆÐ 1/100  
mkv: 1/100 dags: 30.11.99  
fríðrik fríðriksson arkitekt faf 211256-4519 sími 864 96 10  
keiduhvammur 6 220 hafnarfjörður ffark@siandia.is