


ÖLDUGATA 6 HAFNARFIRÐI


Skráningartala: Öldugata 6				Skráningur: Erlendur Arni Hjálmarsson														
Landnúmer: 123018				Kennitala: 100355-5239														
Málhlutnúmer: 02				Útgáfa: 4.010														
Úpphafingur: 01				Dagur: 24.2.2010														
Upphafingur	Örn	D2	D3	D4	D5	DSM	D6	D7	D8	D9	D10a	D10b	D11	D12	D18	D17		
Litun	Ryng	Nokkur	100%	Cipar	opinn	úthútur	hópur	Op	Stöðvotur	Stöðvotur	Stöðvotur	Stöðvotur	Stöðvotur	Stöðvotur	Stöðvotur	Stöðvotur		
Málhlutur					41,8	0,0	0,0	0,0	41,8	0,0			138,8	33,2	41,8	102,588		
Botn													8,3					
	01	1. hæð			41,8	0,0	0,0	0,0	41,8	0,0			128,5	33,2	41,8			
A	0101	Bilgevmsla	B	0101	41,8				41,8			2,75	3,44	128,5	33,2	41,8	3,09	102,588
Alþágamendir																		
Samtögnir summa																		
Eignarhald																		
	0101	Bilgevmsla			41,8	102,588	102,588											
	Allt				41,8	102,588	102,588											

Sambýkkt þann
27 JAN 2010
Byggingafultrúinn / Hafnarfirði
F.h. Sigurður Steinar Jónsson


Úr Gildi

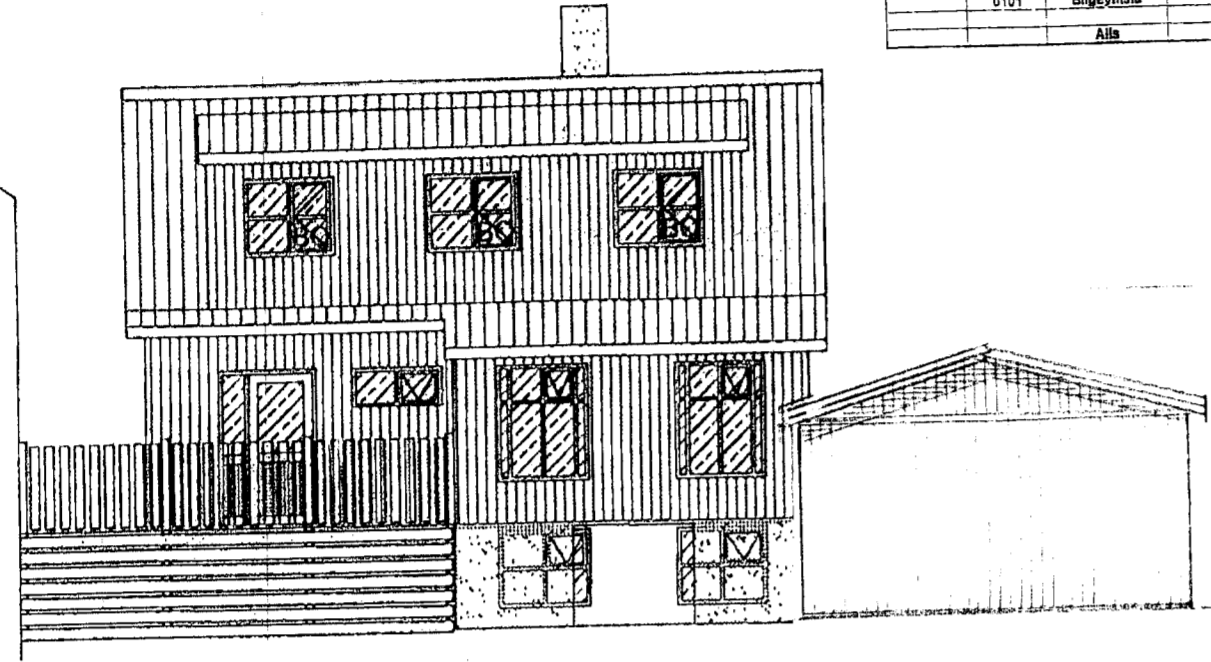


SUÐUR

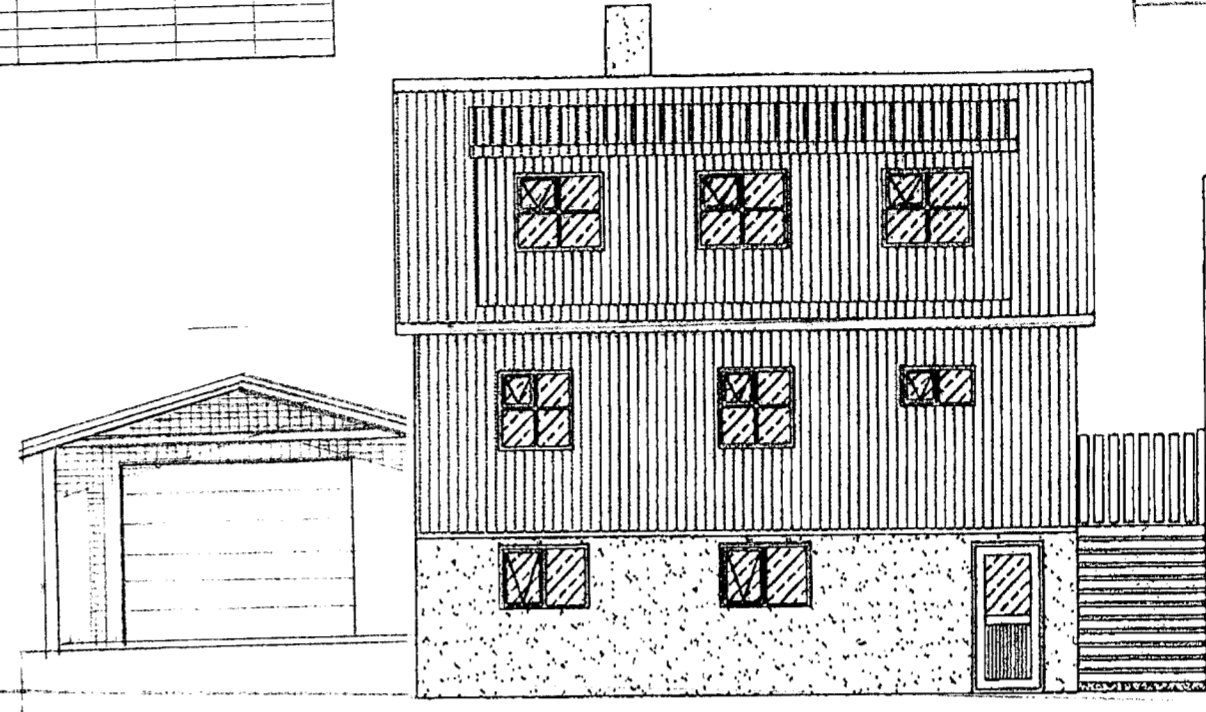


NORÐUR

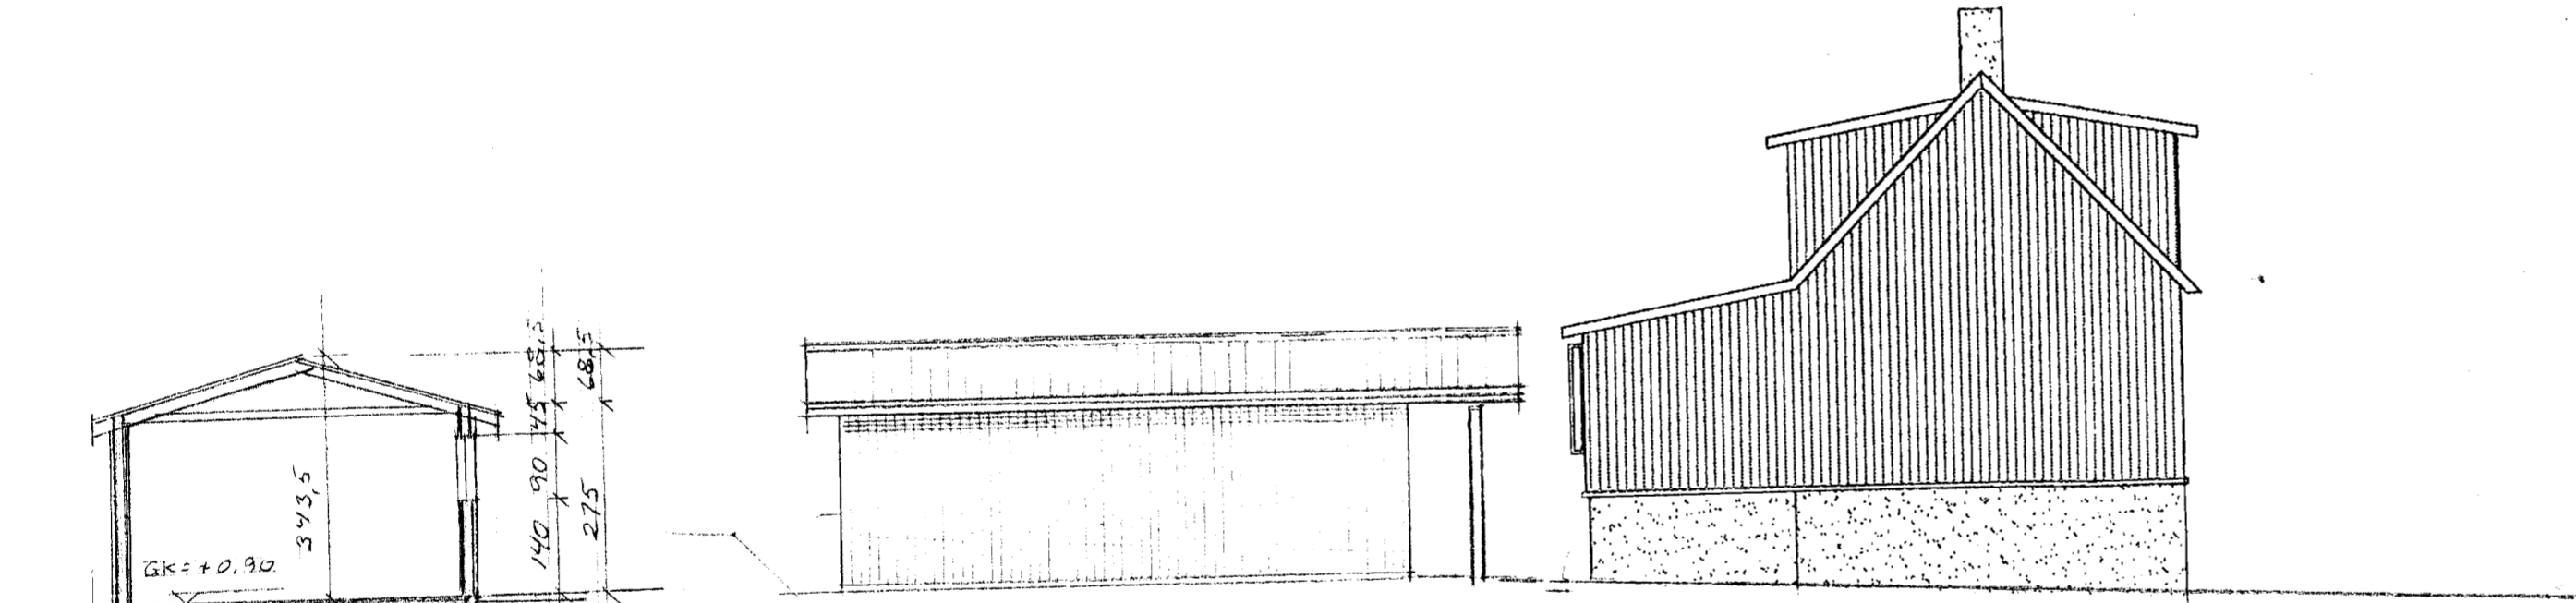

AUSTUR

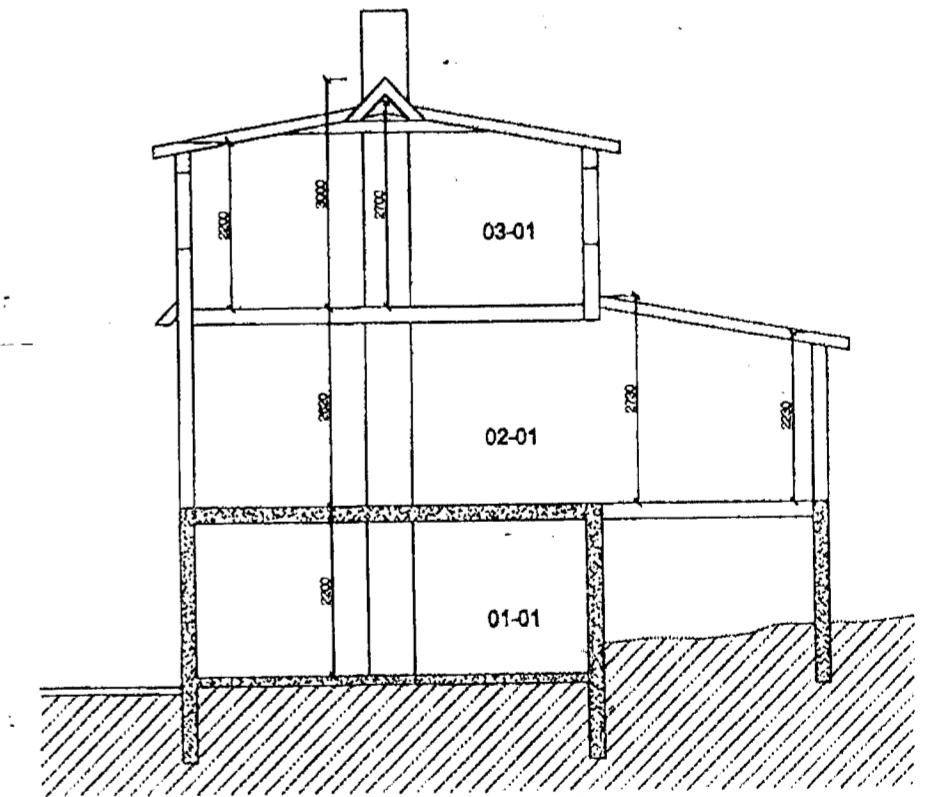

SNEIDING A-A

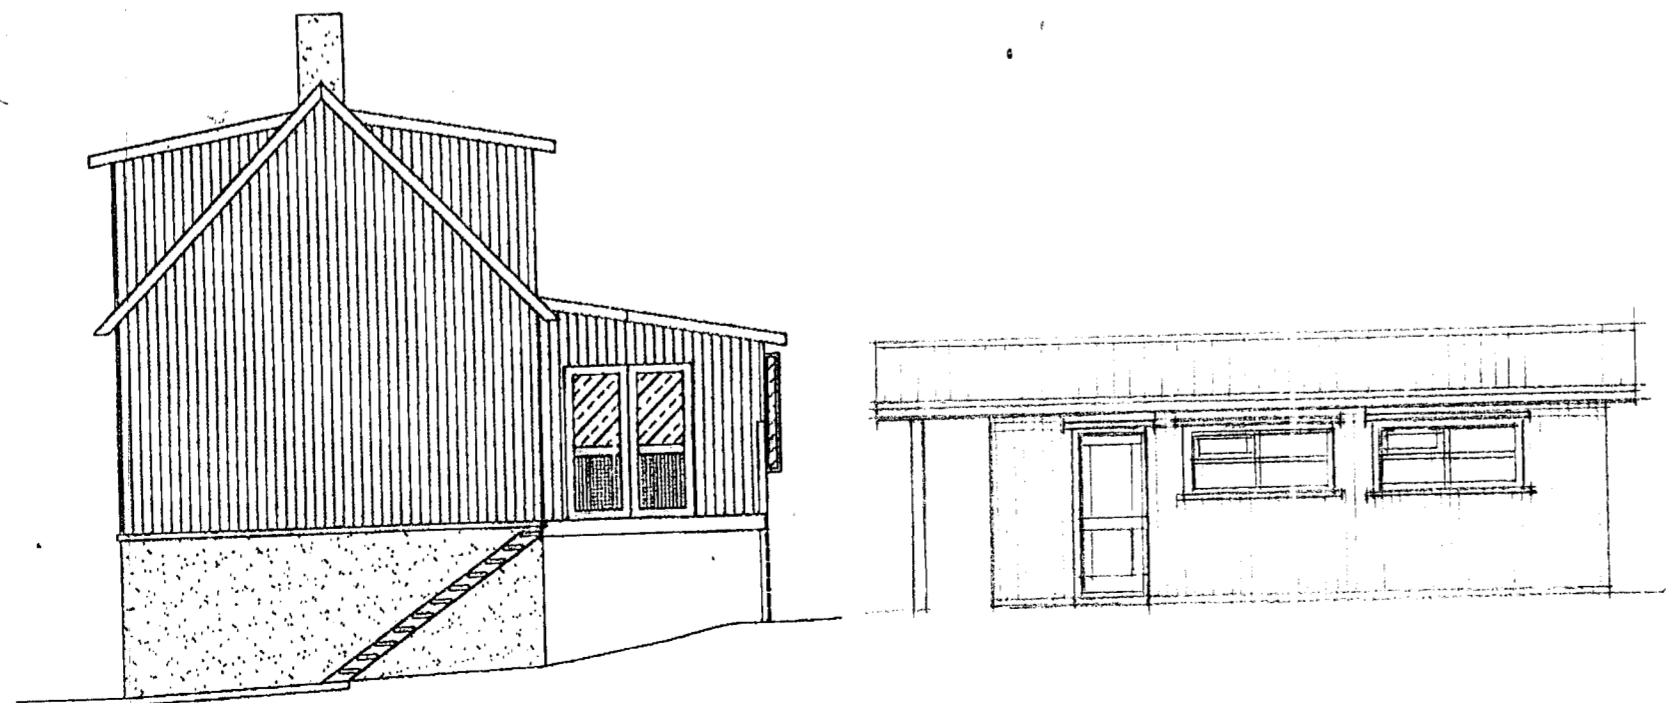

VESTUR

13.01.2010 STAÐSETNING BÍLG. BÆYTT.

LANDNÚM 123018 - MHA 02

ÖLDUGATA 6 HAFNARFIRÐI

EFTI
LIT, SNID

ERLENDUR ARNI HJÁLMARSSON BFI ENEBERG & HAF
KT. 100355-5239 627.5634

002

DAGS 25.02.08

MÁL 1:100

EH