




Sambýkkt þann
28 APR 2010
 Byggingáfulltrúinn / Hafnarfróði
 F.h. Sigurður Steinar Jónsson

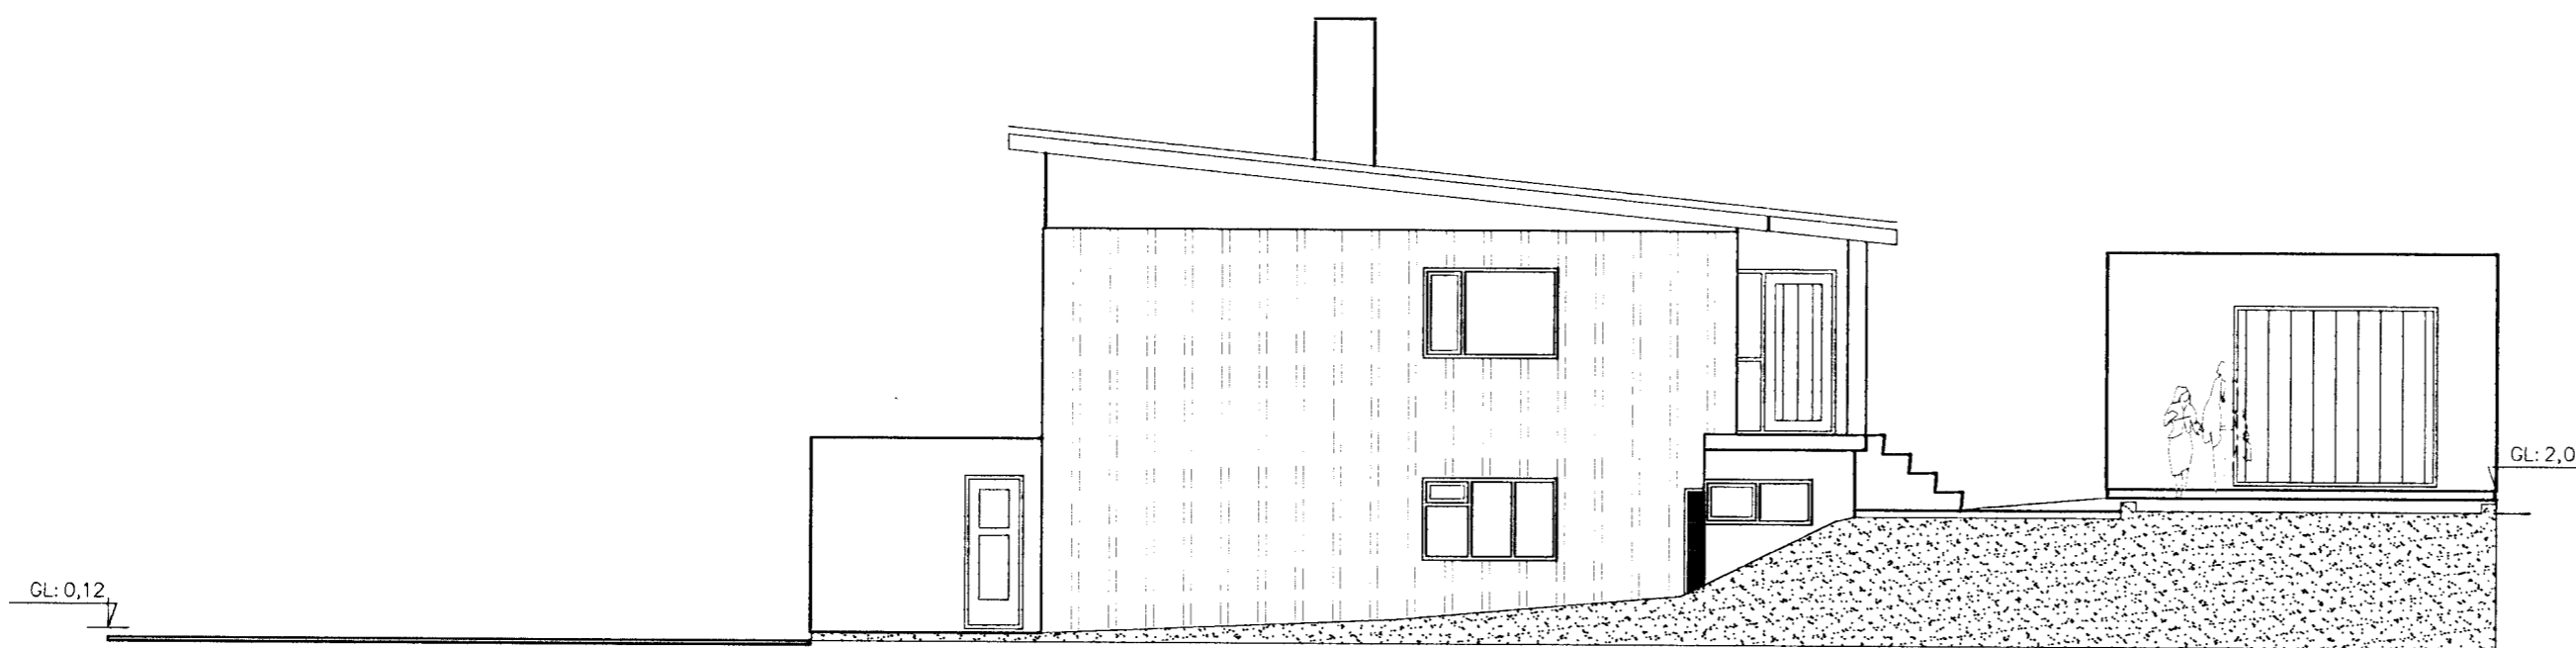


SÚÐVESTUR 1:100

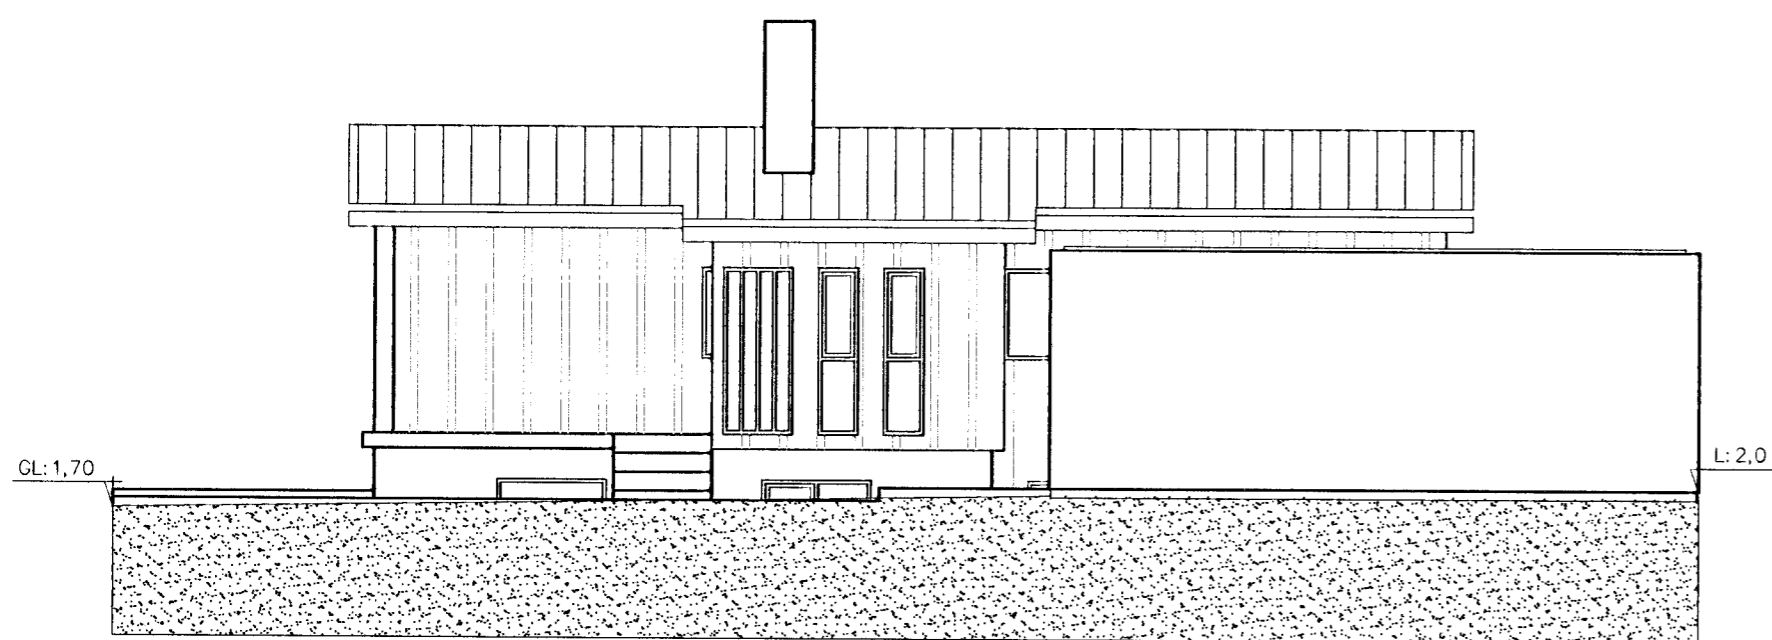


SÚÐAUSTUR 1:100

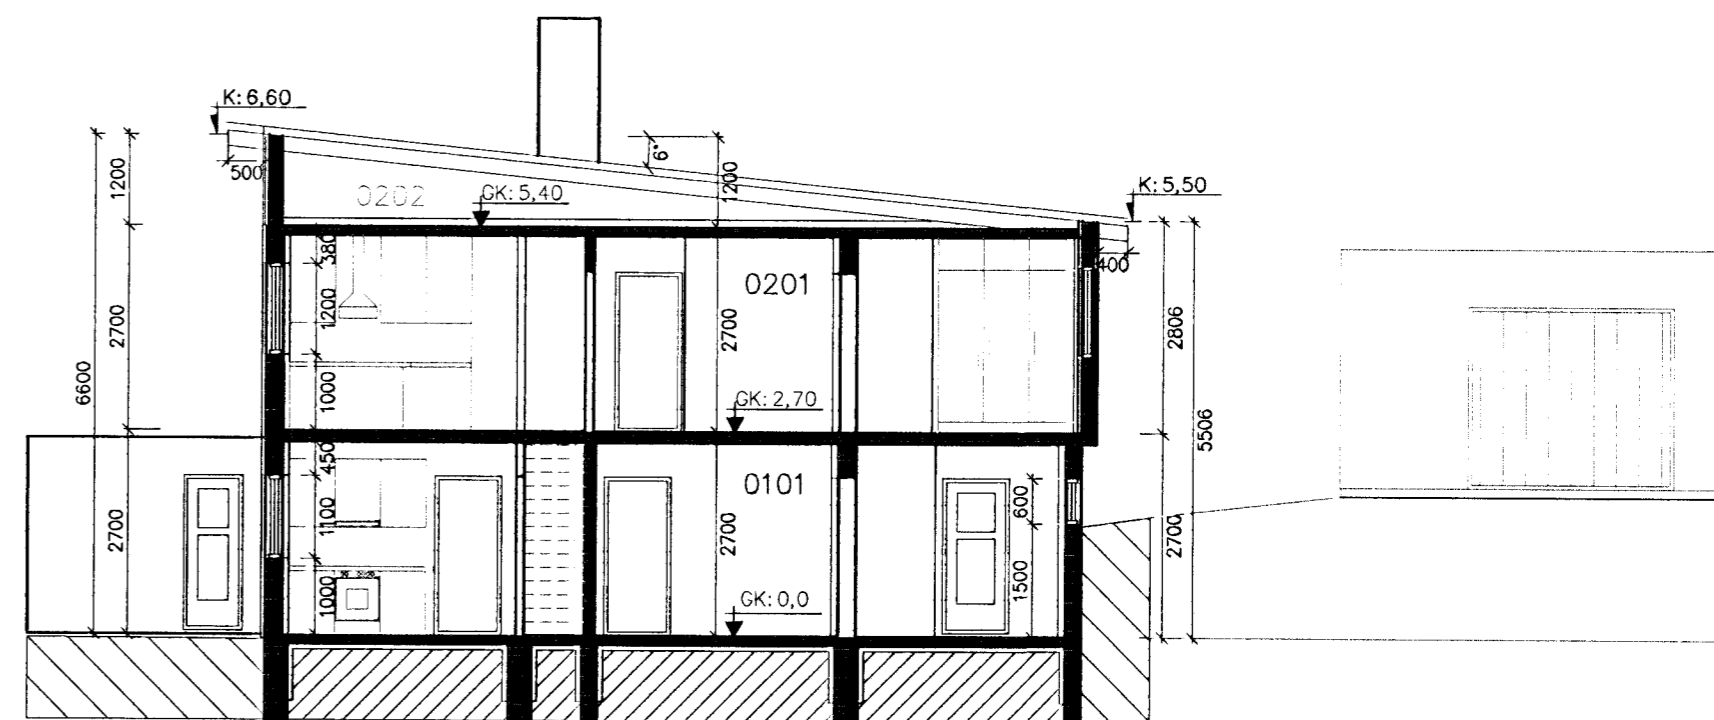

SNID A 1:100

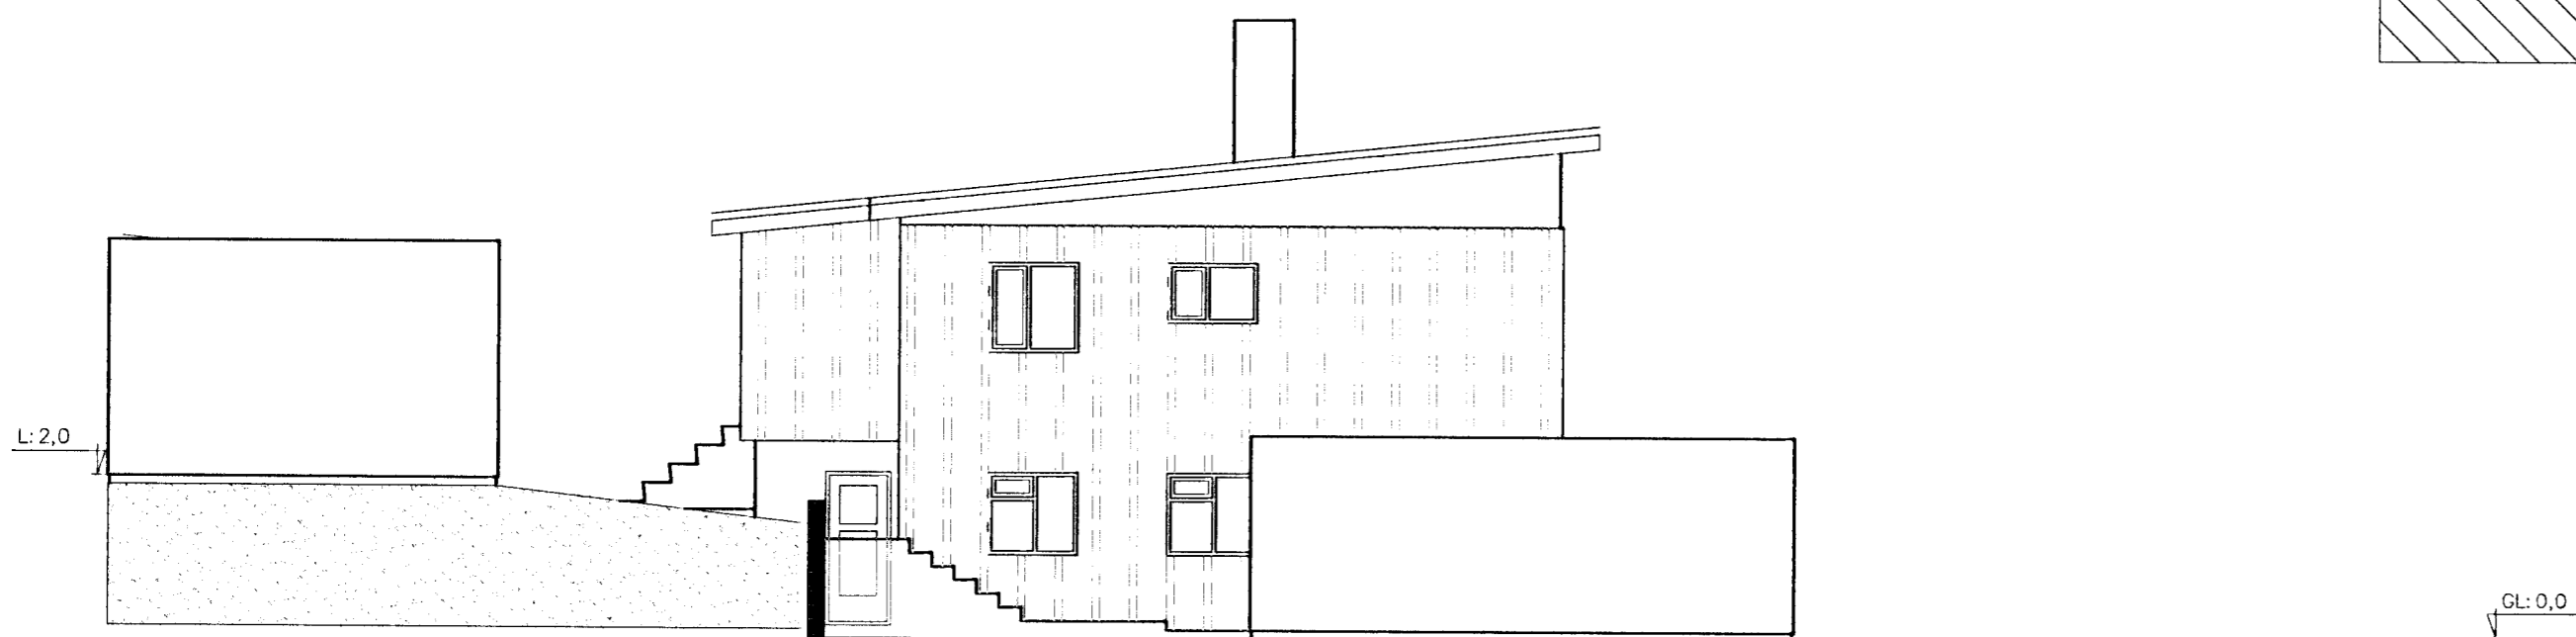

NORÐAUSTUR 1:100

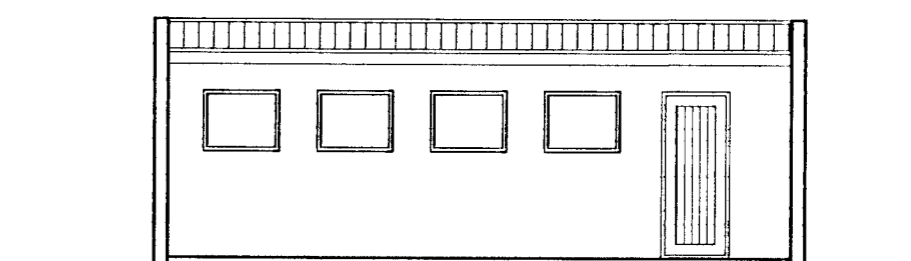

NORÐVESTUR, BÍLGEYMSLA 1:100



NORÐVESTUR 1:100

Dags.	Breytingar	Nr.	Nafn
16.11.2009	Breyting á skráningu: Stækkun á brúttórúmmáli 11,8m ³ og á birtu flatarmáli 28m ² .	1.	FÓ
16.11.2009	Anddyri stækkar um 1,5m ² .	2.	FÓ
16.11.2009	Gluggar eru settir á kjallaraeymslu.	3.	FÓ

meter Verkfræðistofa ehf
 Síðumúli 1, 108 Reykjavík

Sími: 5678922, Fax: 8940059
 meter@meter.is, www.meter.is

MÓABARÐ 8B, 220 HAFNARFJÖRÐUR

HANNAÐ
 Óli G.H. Þórðarsson 2106367069

ÚTLIT OG SNID A

TÖLVUSKRA	HANNAÐ	TEIKNAD	YFIRFARIÐ	ÚTGÁFA
350-220-MÓABARÐ 8B	Ó.G.H.Þ	FÓ/VG	FÓ	1
SAMBÝKKT	TEIKNING NR.	MKV.	BLAD NR.	
Fríðrik Ólafsson 2303592459	350-A03	1:100	A-03	
	DAGS.	VERK NR.		
	16.11.2009	350		