
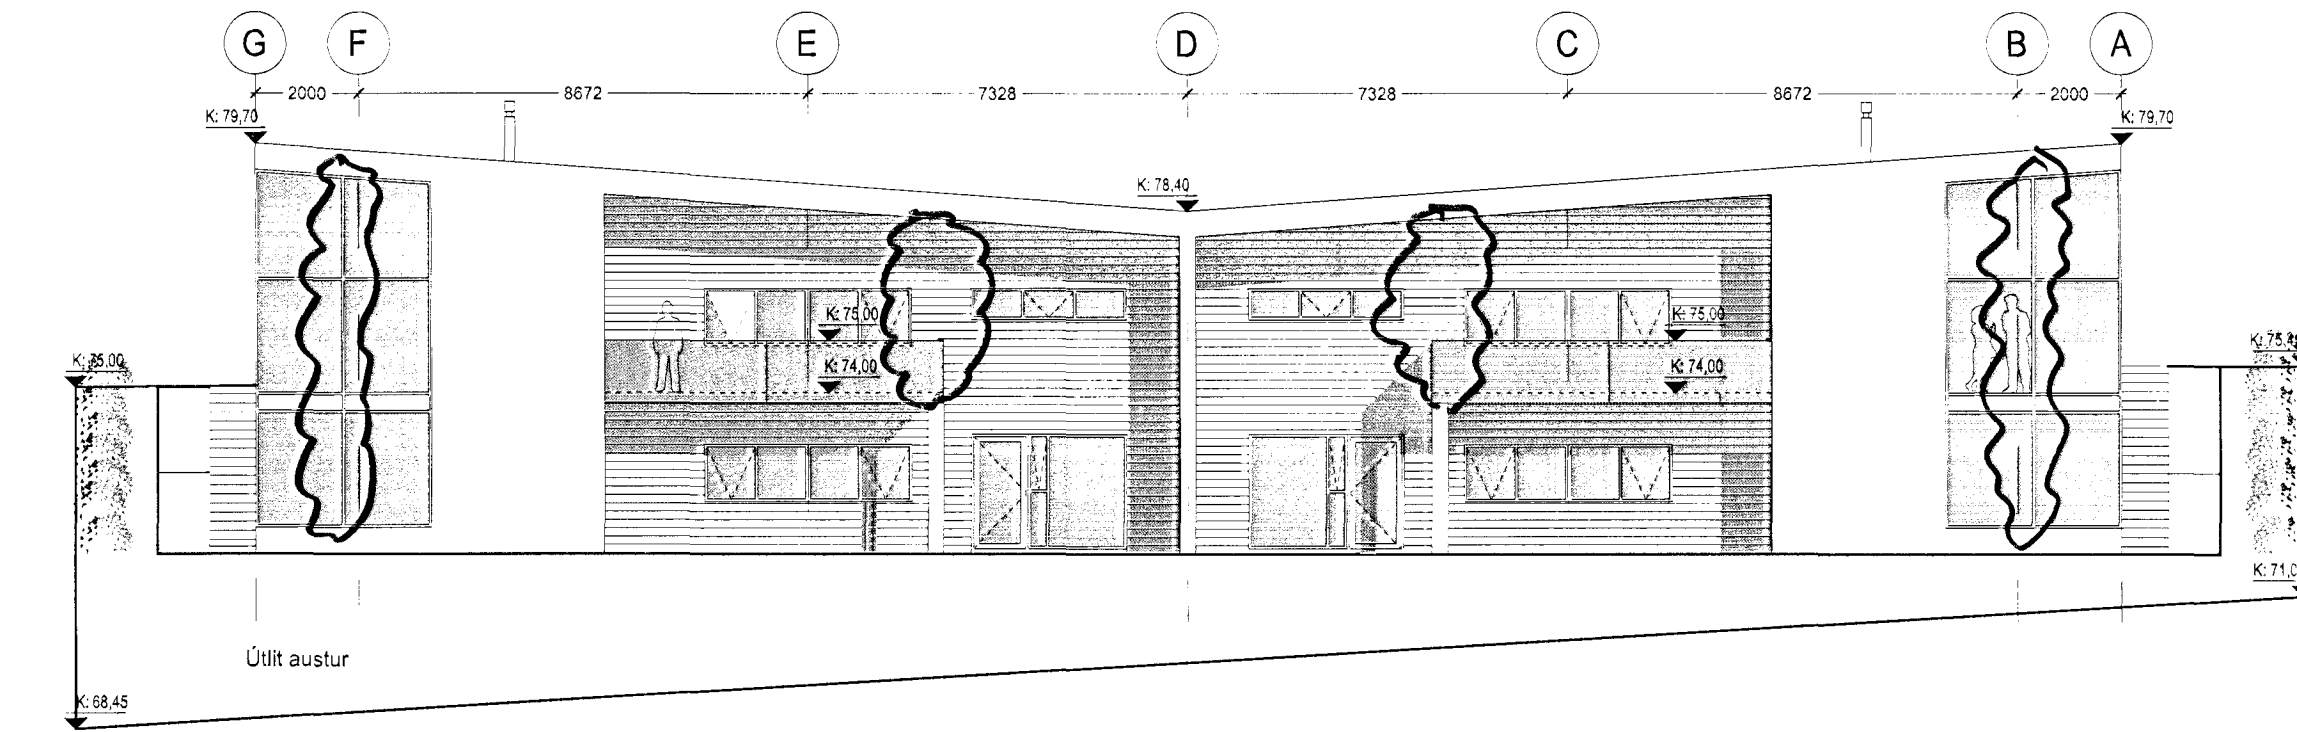
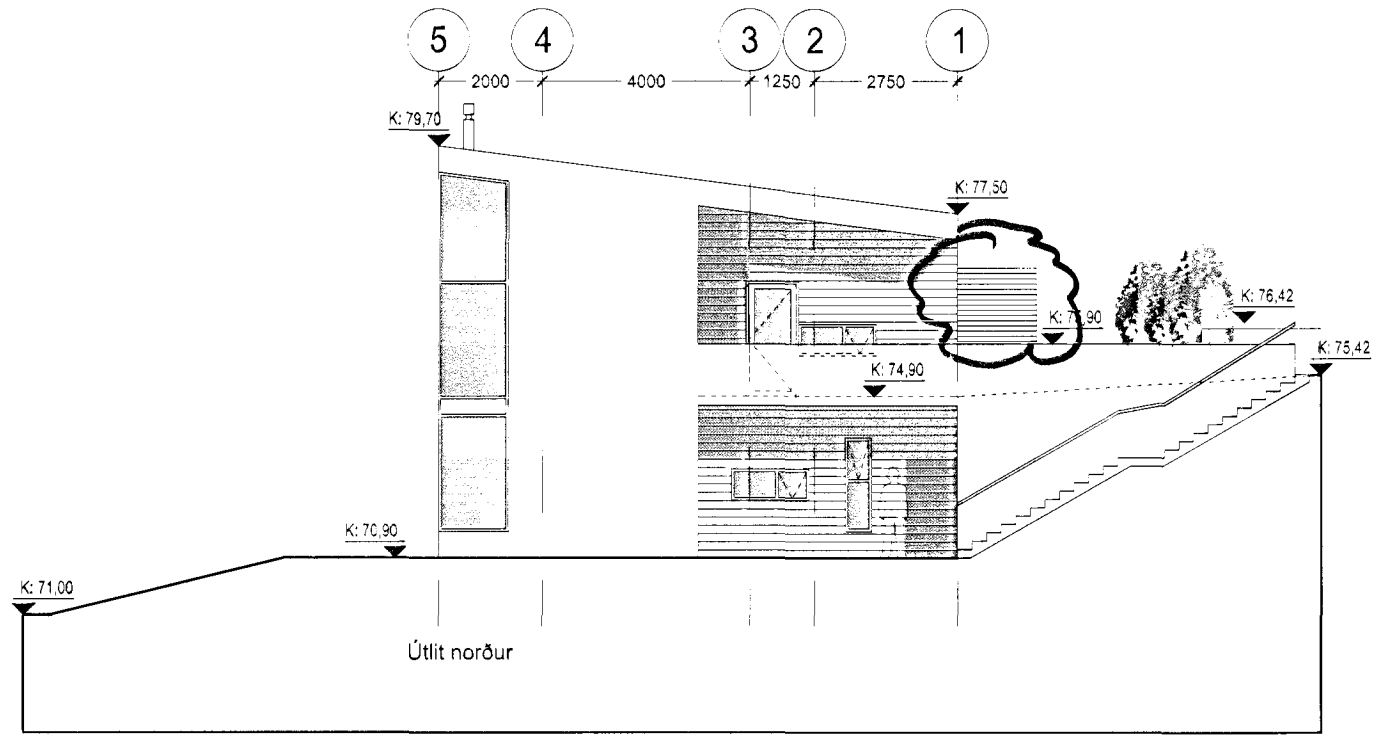


Upphaflegur höfundur: Batteríð ehf.

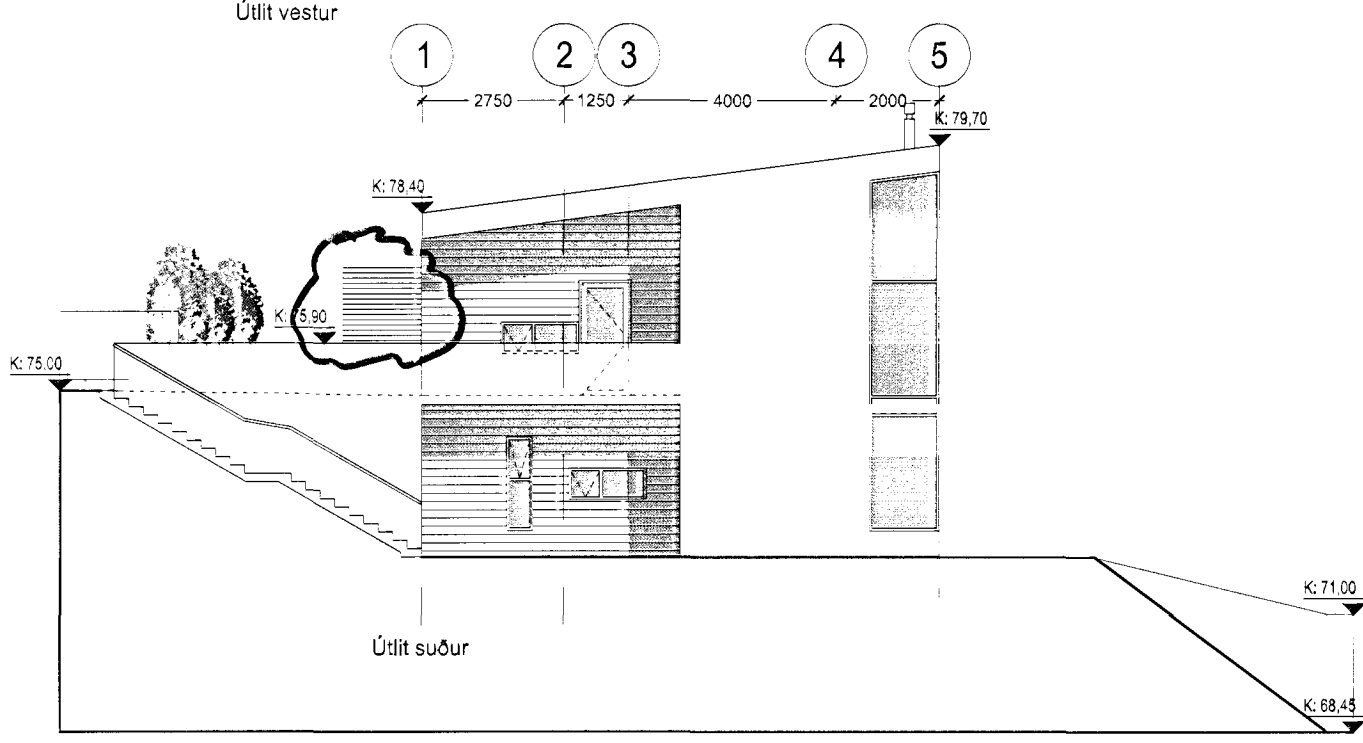

02.20.04.10	SE	gluggar, inngr. sula	
Vlg. Dags.	Telkg.	Bræying	Samb. af Dags. verkkaupa

Sturla Þorvaldsson, Þorvaldur Ásgeirsson

PARHÚS

FURUÁS 19 - 21

0710

Landnúmer: 207222 og 207224
Stgr. 25800190 og 25800210, MNL 01

ADALUPPDRA'TTUR

ÚTLIT

0710-0-(99)-A-305

ÚTGÁFA 02

MKV.: 1:100
TEIKNAD: PH
ÚTGÁFA DAGS: 12.06.2007
STOFN. DAGS: 02.05.2007

BATTERIÐ
ARKITEKTAR

Jón Ólafur Ólafsson FAI
kt: 090658-4099

Sigurður Einarsson FAI
kt: 110457-2789

Sigurður Harðarson FAI
kt: 030446-3999

kt: 521291-1259
Trénuhvauní 1
220 Hafnarfirði

S: 54 54 700 F: 54 54 701
Netfang: batteri@arkitekt.is
Heimasíða: www.arkitekt.is

© BATTERIÐ EHF
ÖLL AFRÖG OG AFRITUN TEIKNINGAR AÐ HLUTA EÐA Í HEILD ER HÁÐ SKRIFLEGGU LEYFI - ÖFUNDA