
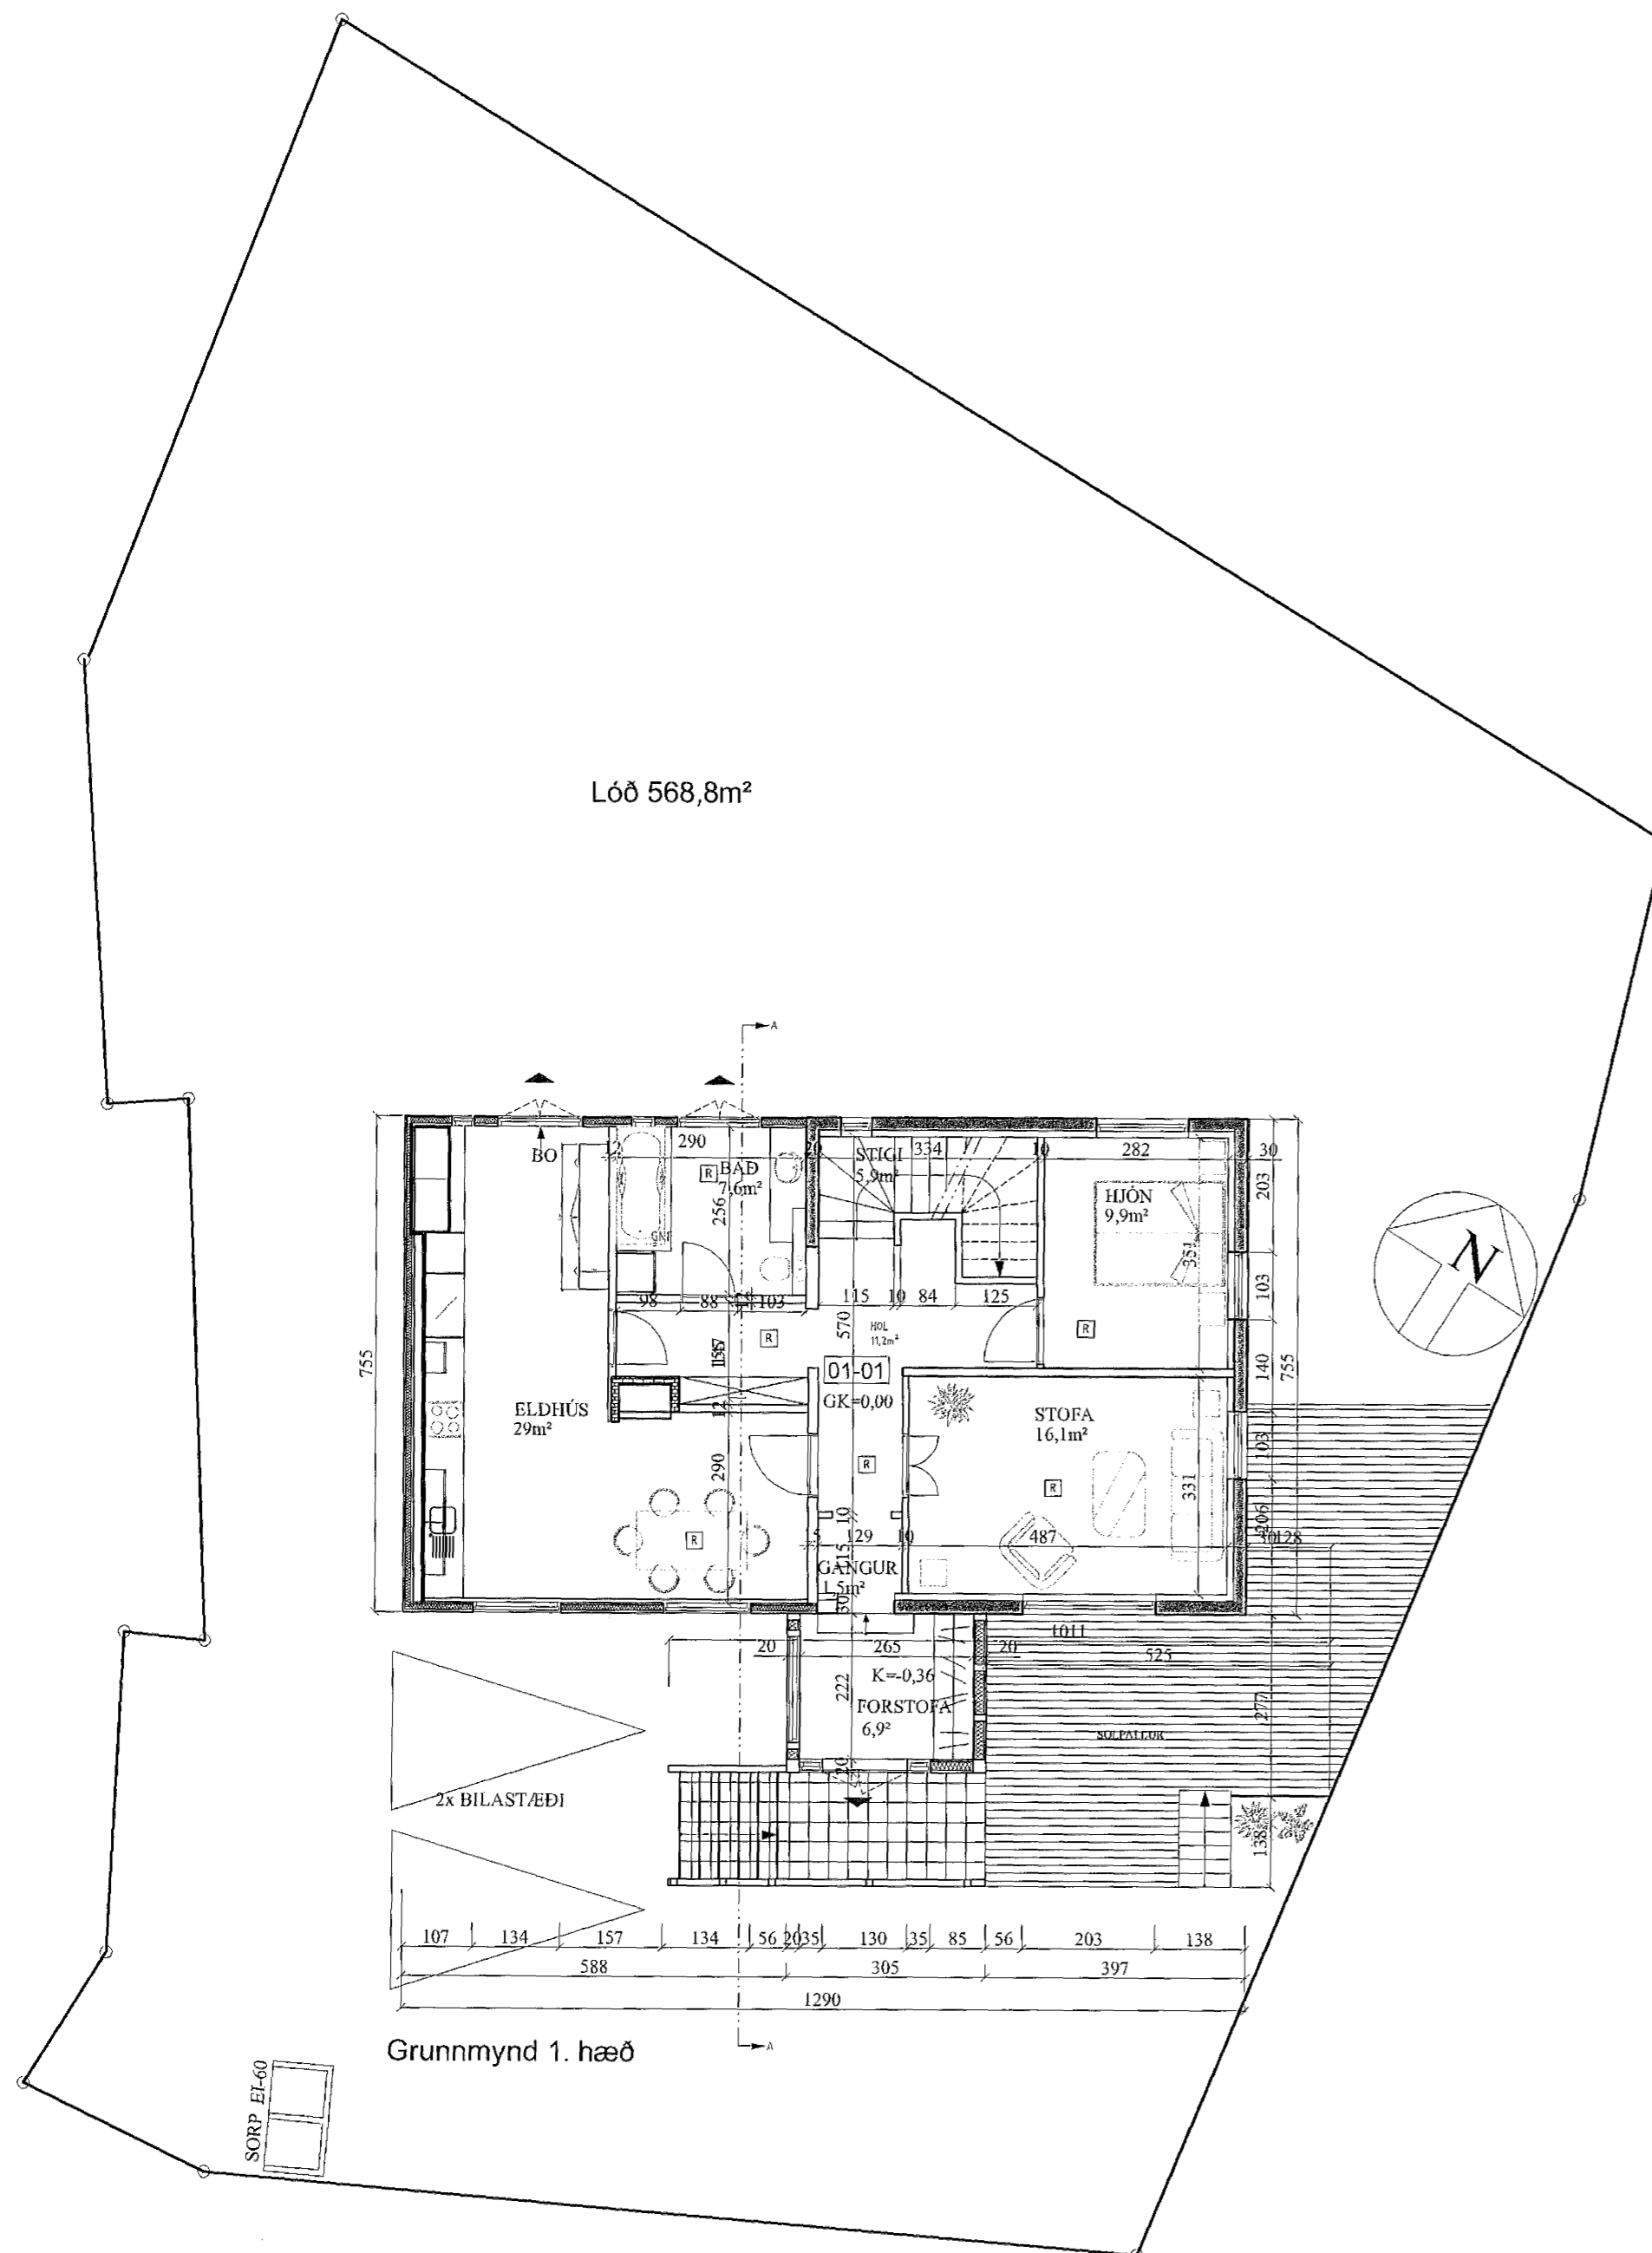
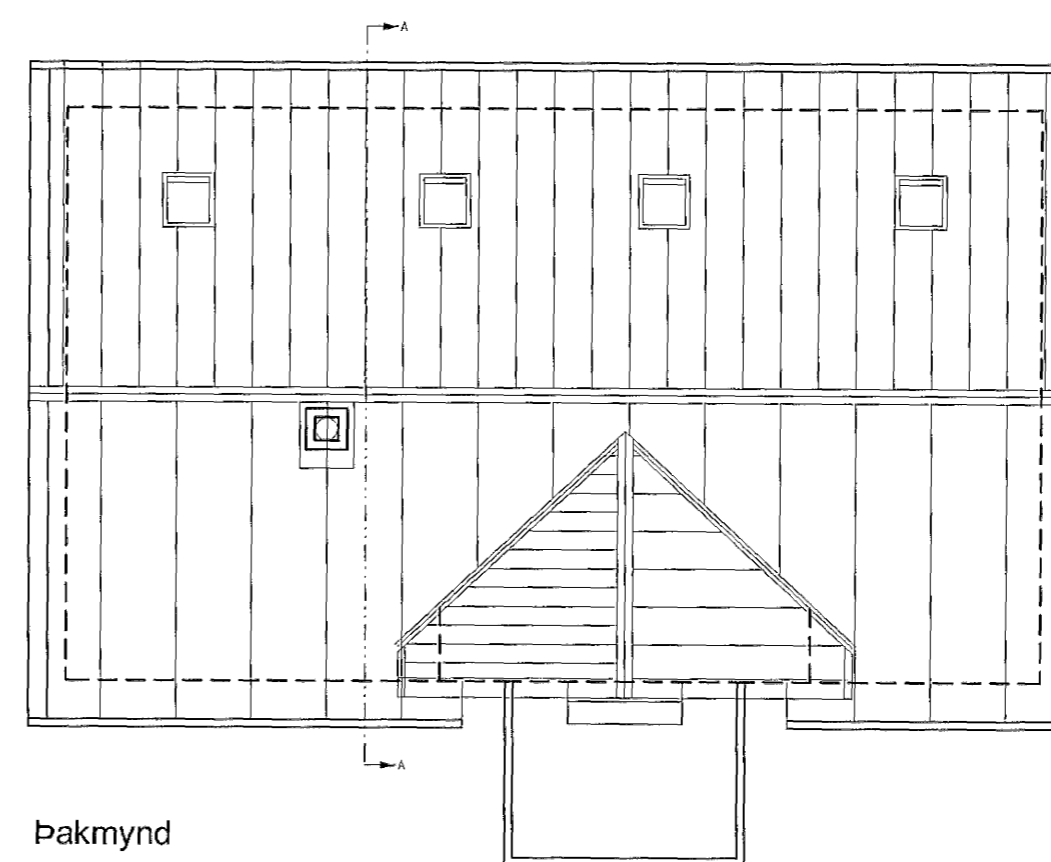


Samþykkt
22 OCT 2008
Byggingarstjórnir
F.h. Jón Sigurðsson

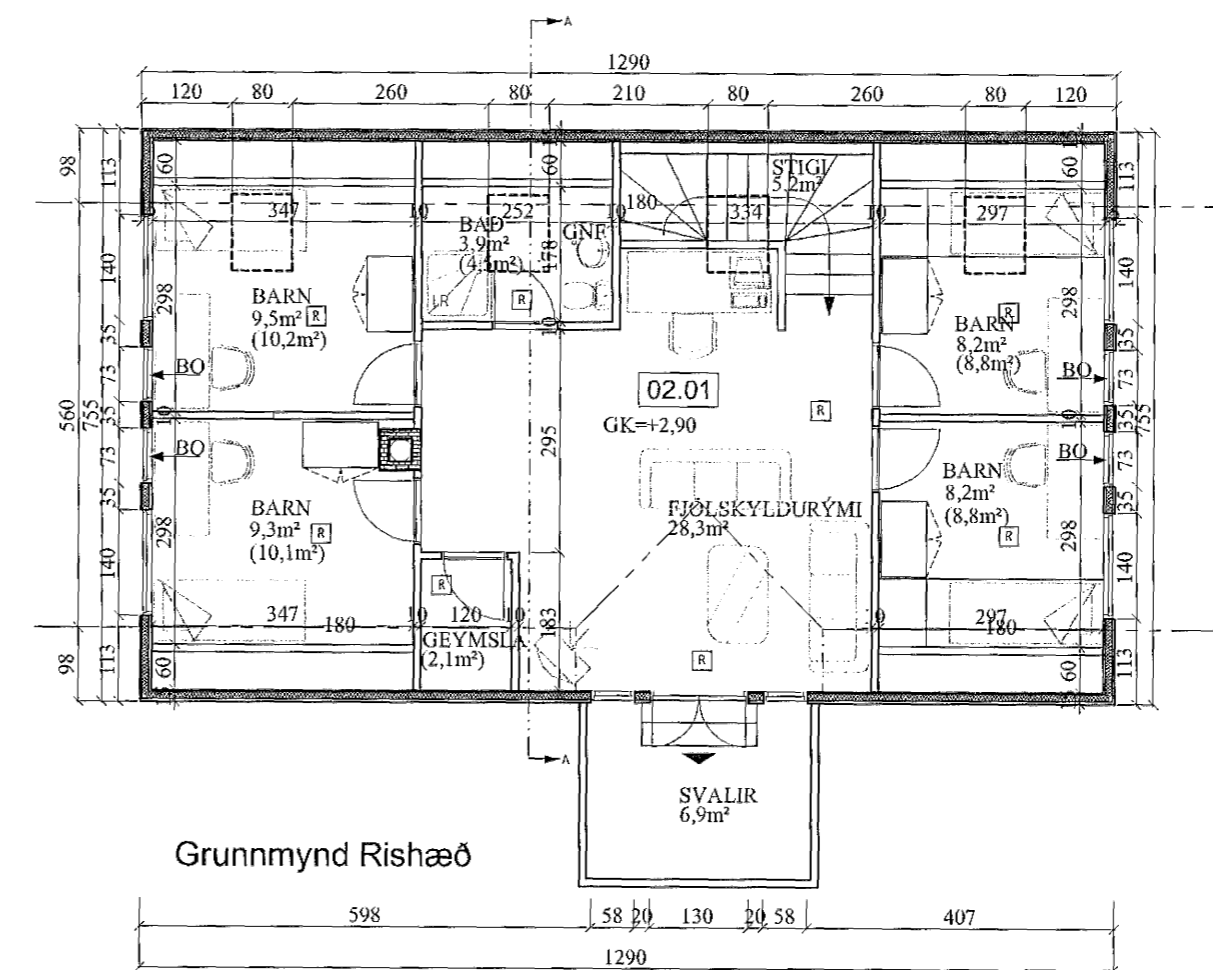

drangahraun 8.
220 hafnarfjörður
Íceland
tel + 354 565 15 25
fax + 354 565 15 20
tul@simnet.is

tul
telklistofan upp á lofti

Unnið í samvinnu við
sægeimur arkitektar hafnarfjörður

Aðal- og samræmingarhönnuður:
Marteinn Huntingdon-Williams, RIBA;FAI
kt:130755-8019
Merkurgata nr.5 220 Hfj
gsm: 869 7354
saegeimur@hotmail.com

Austurgata 29b Hafnarfjörður

Reyndarteikningar

Dags. 23.09.2008

Verknr. A-228-1

Teiknnr. 02

Efni. Grunnmynd 1h.Rishæð og Þakmynd

Teiknað: HUÓ/HLH

Mkv. 1:100