




21 OCT 2008  
 Bygging  
 Fr. Jon

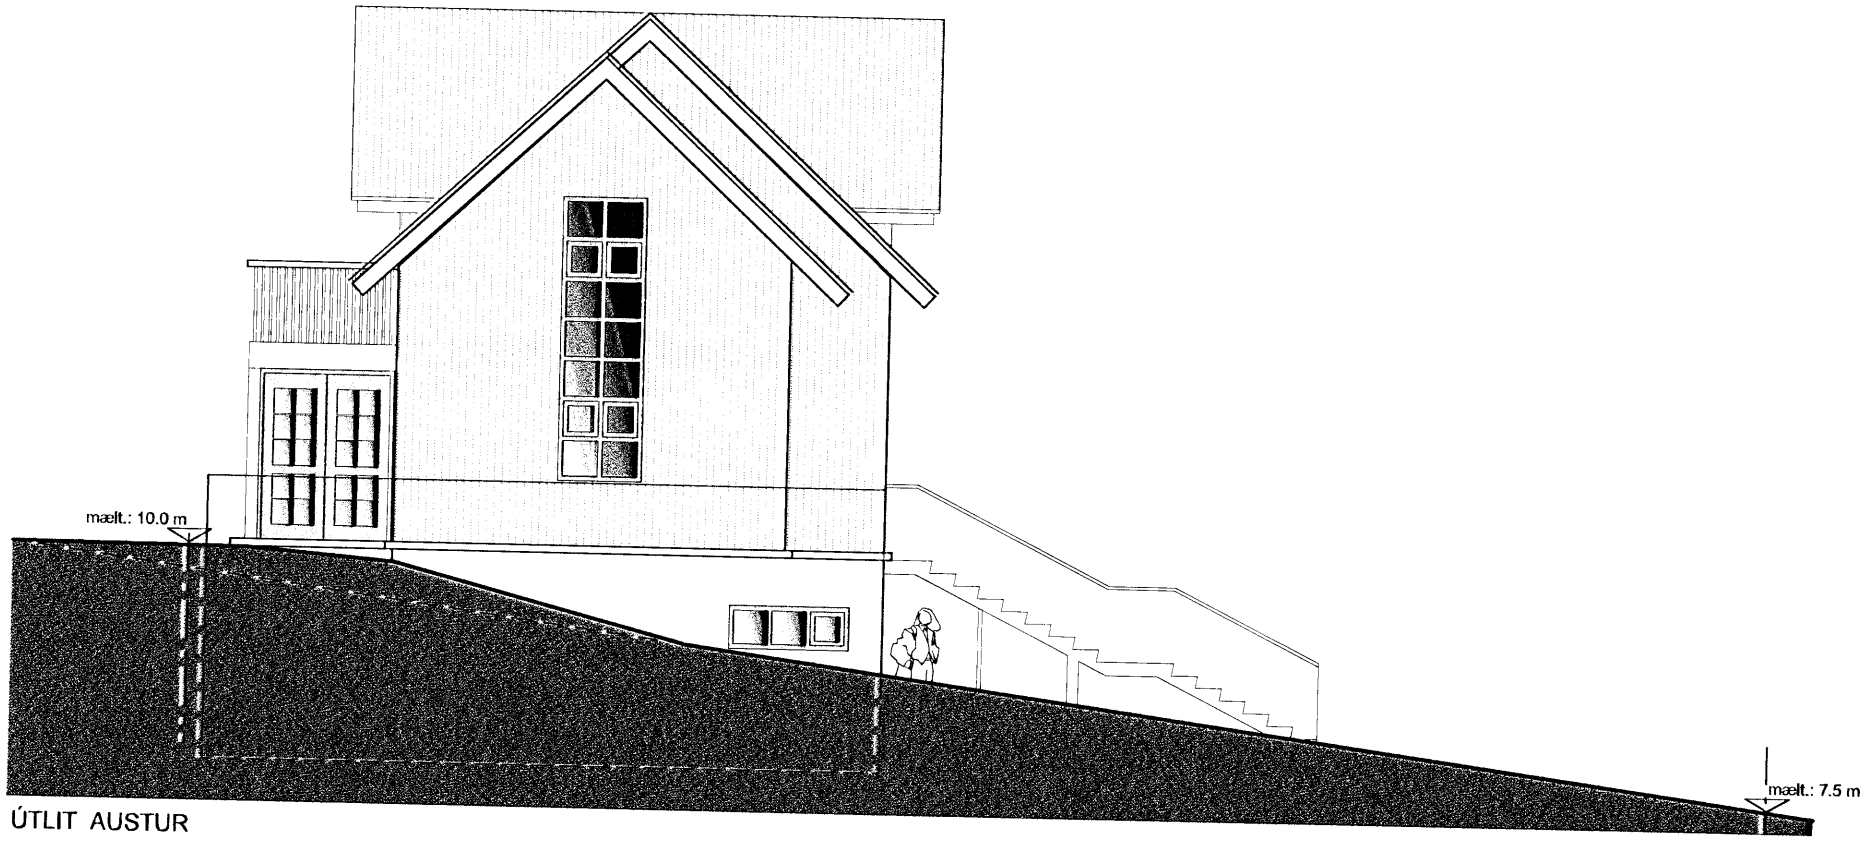


ÚTLIT AUSTUR

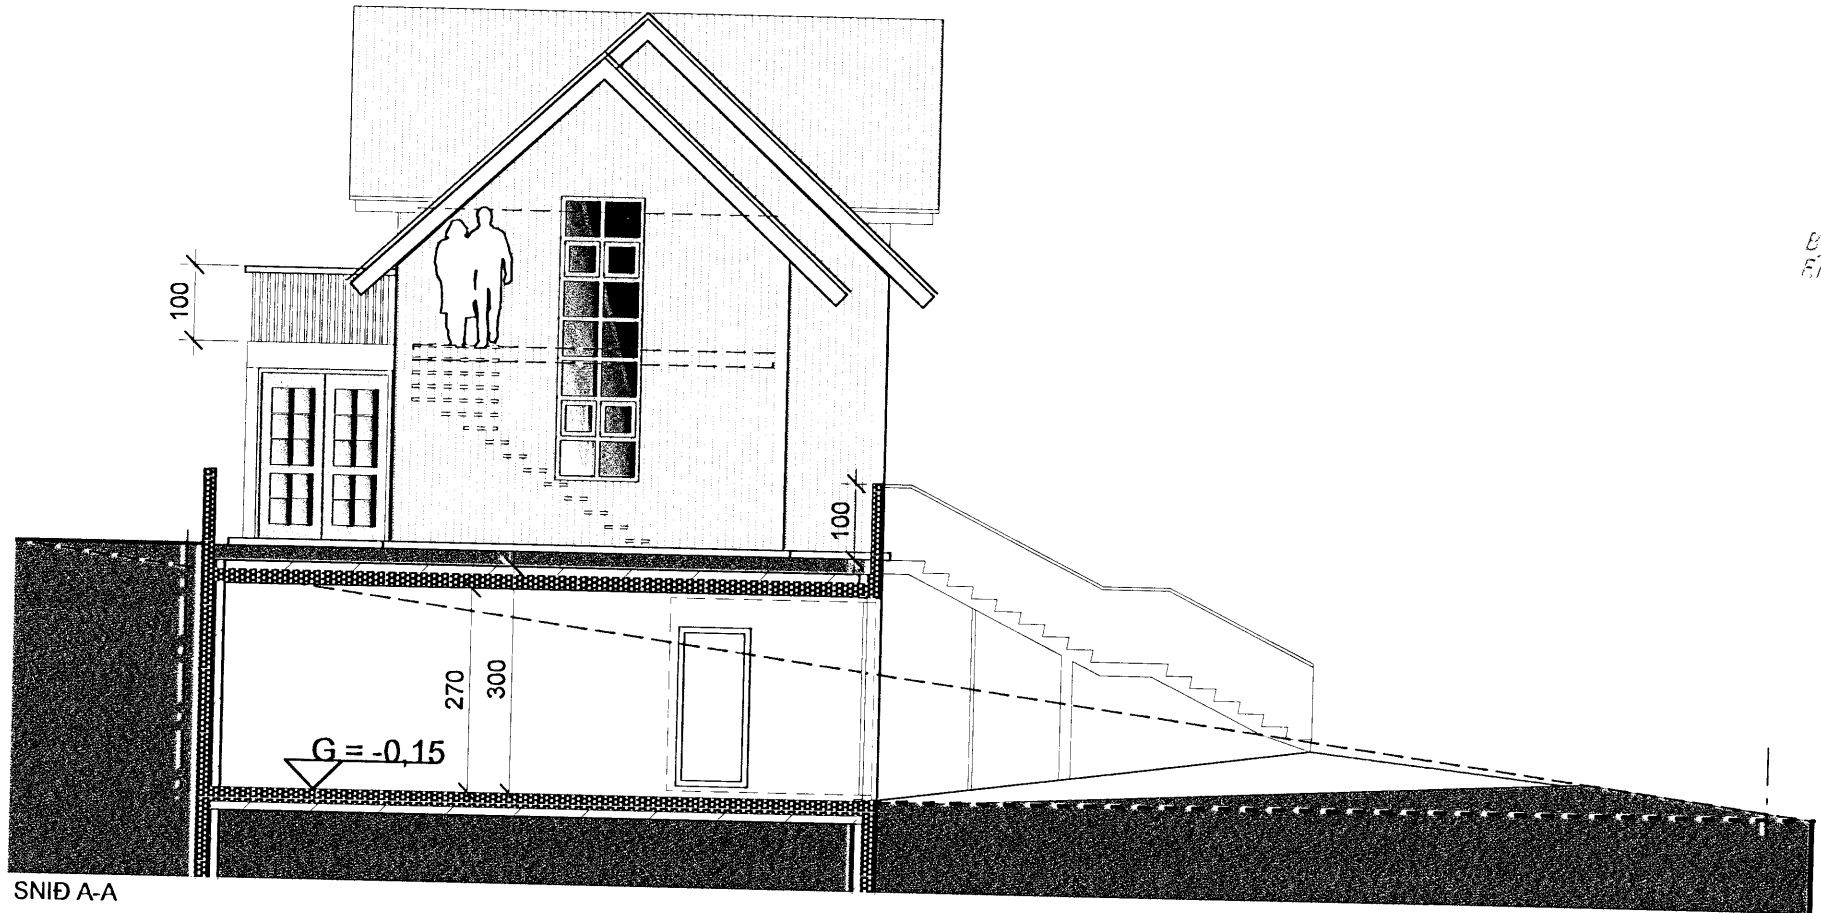


SNID A-A

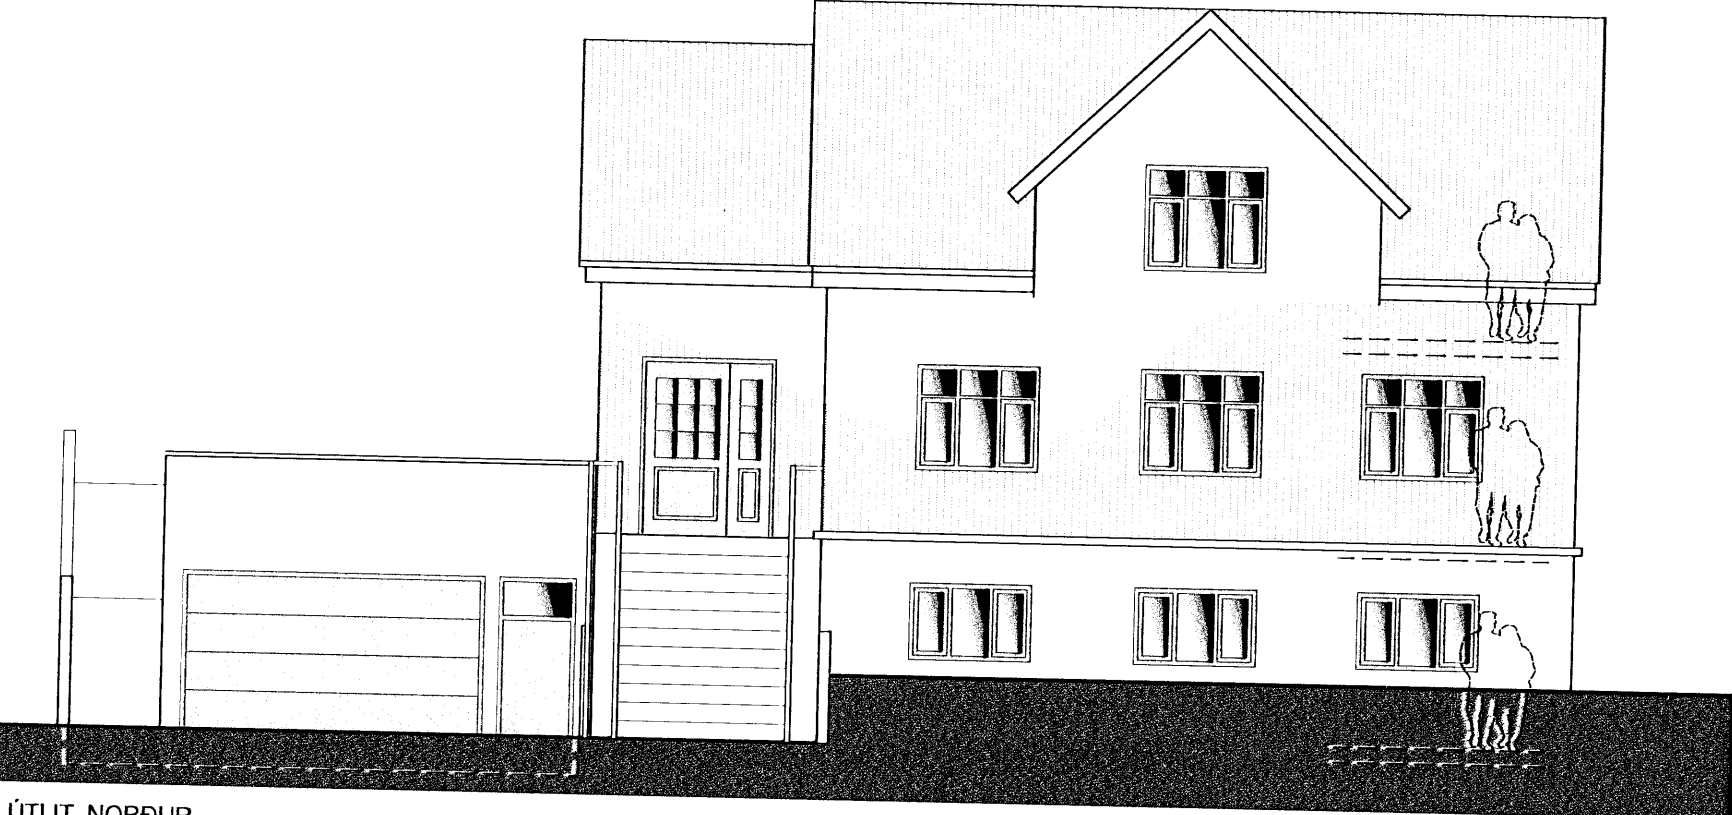


ÚTLIT NORÐUR

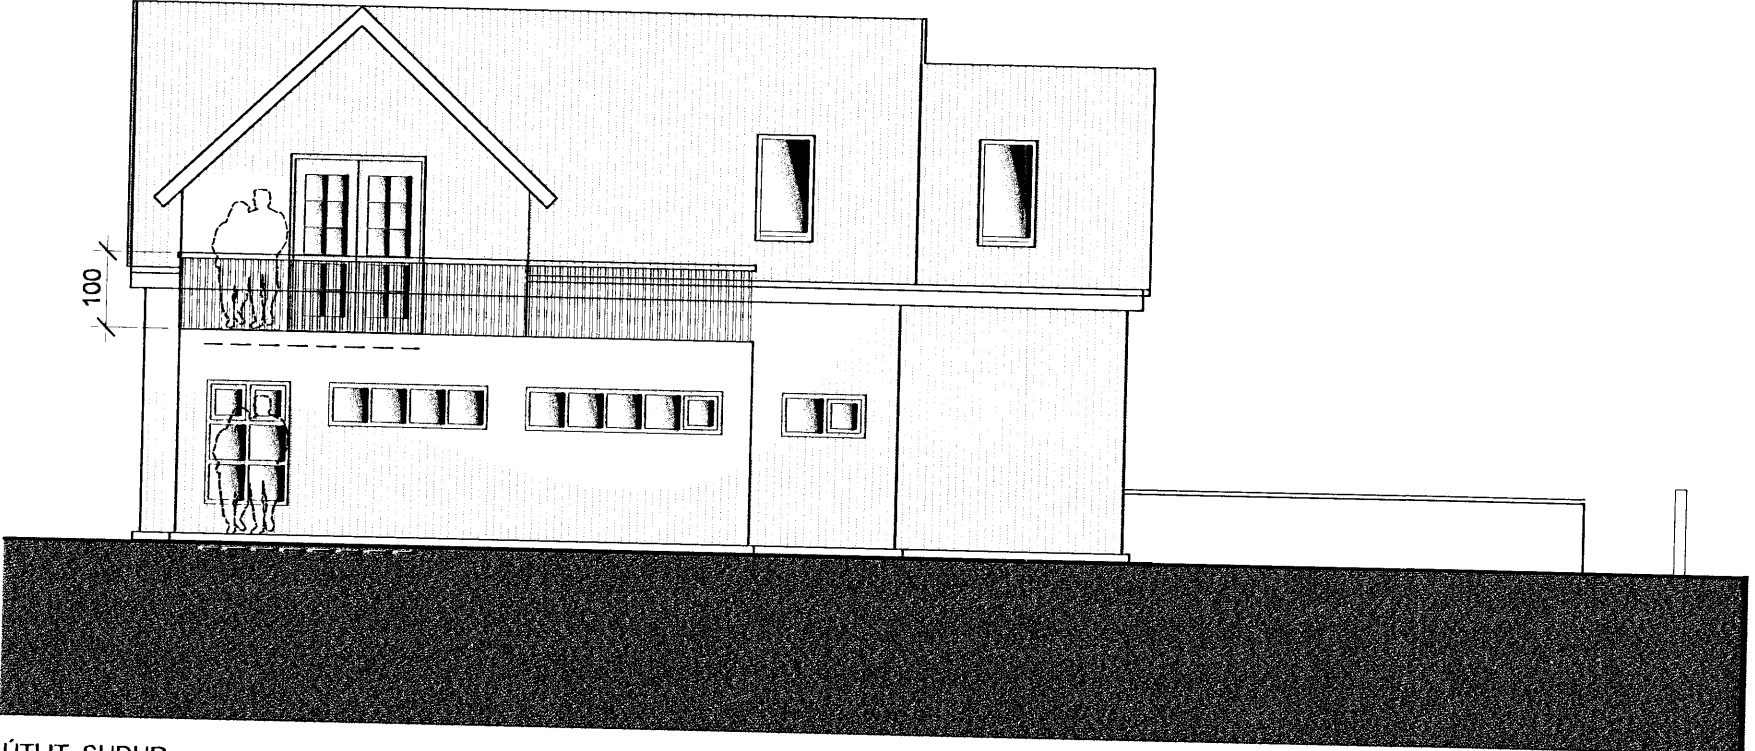

ÚTLIT SUÐUR

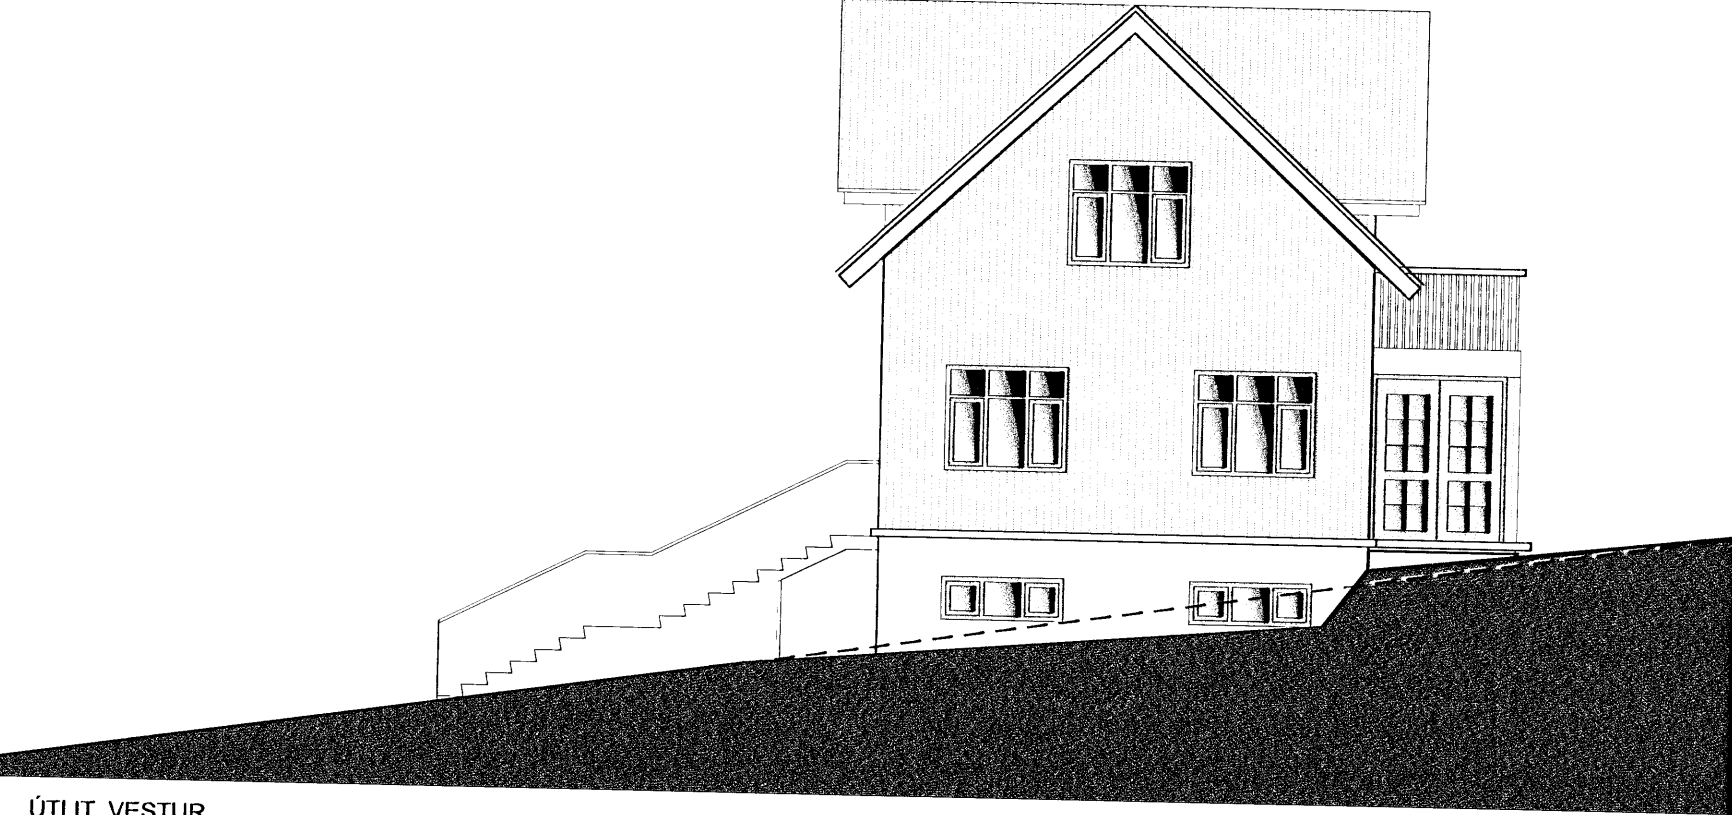

ÚTLIT VESTUR

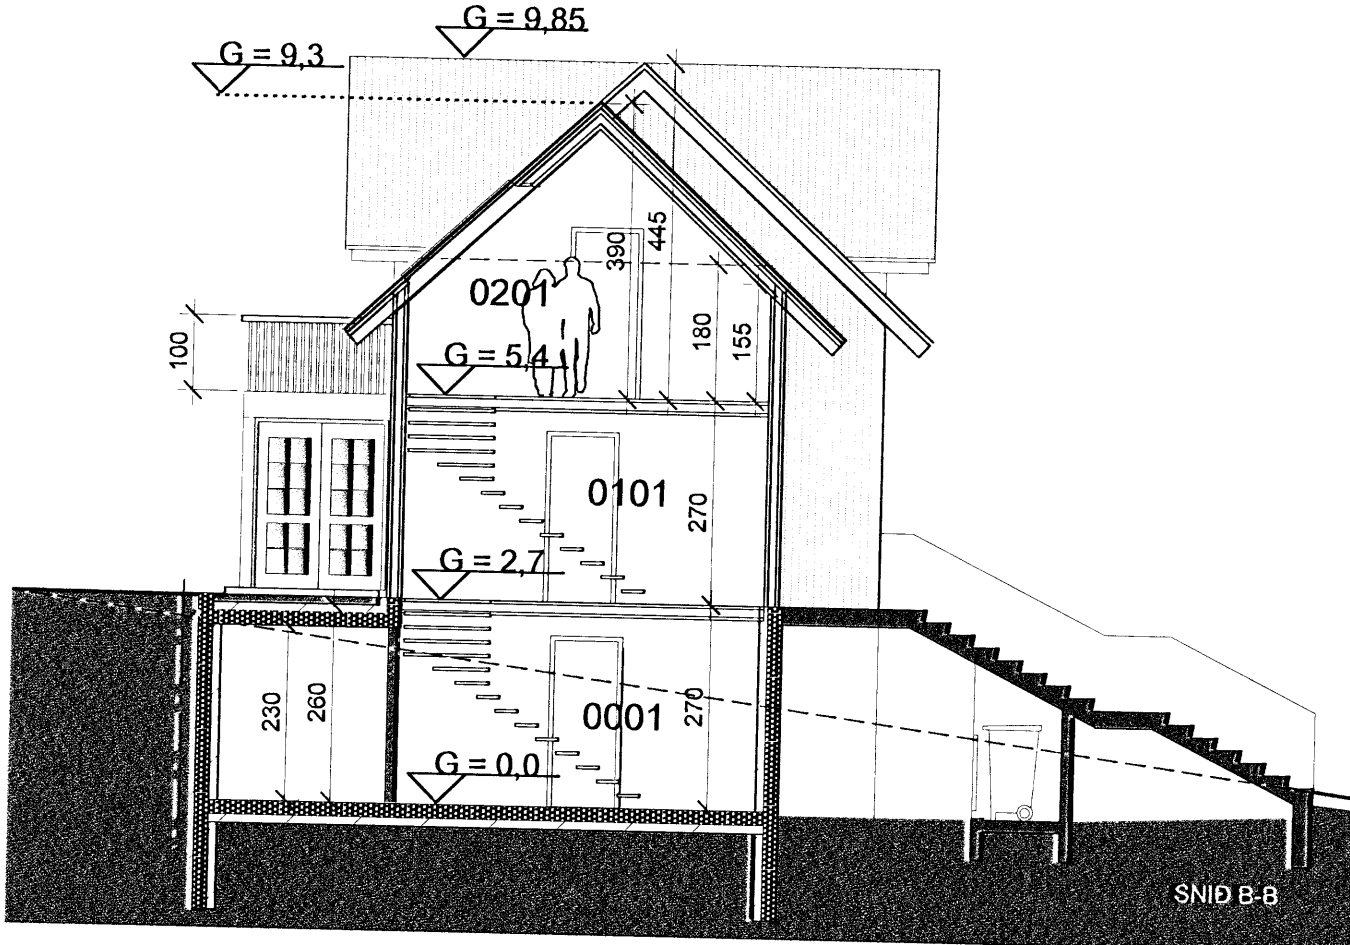

SNID B-B

Breyging vegna útitróppu - samræming 21.10.08

verk	<b>Lækjargata 6, Hafnarfirdi</b>	
heiti	Útlit	
kvartál	1:100 / 1:500	dags 15.05.05
teikn	HI	númer 01

**IOI** arkitektar  
 Laugavegi 59 • 101 Reykjavík • sími: 898 4959 •  
 Haraldur Ingvarsson arkitekt  
 kt.: 030956-3389  
 haling@vortex.is