

  
 15 JAN 2009  
 Byggingarteknið  
 F.h. Sigurður Jónsson

Áritun samráðingarráðgjafar

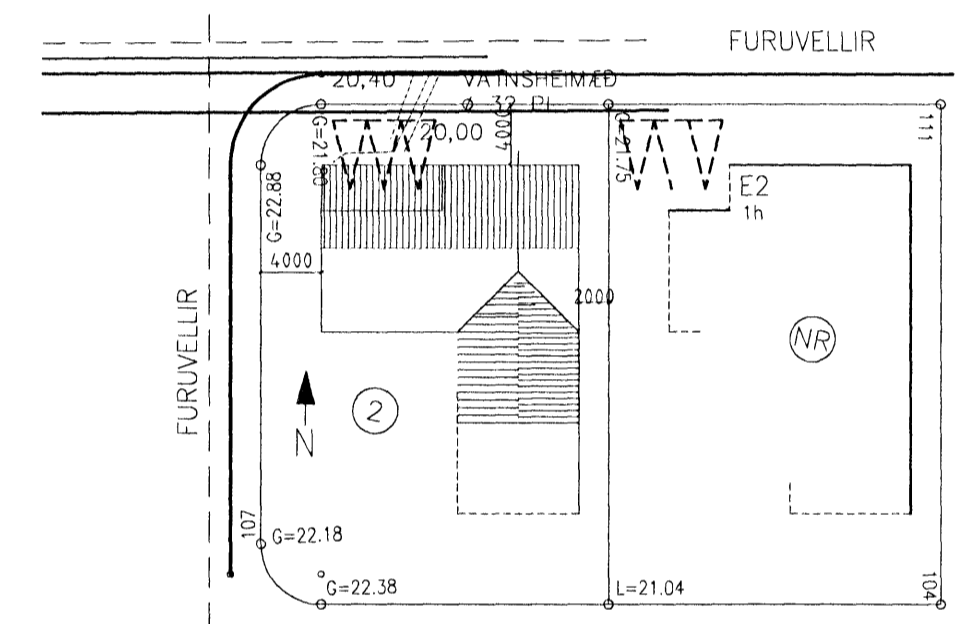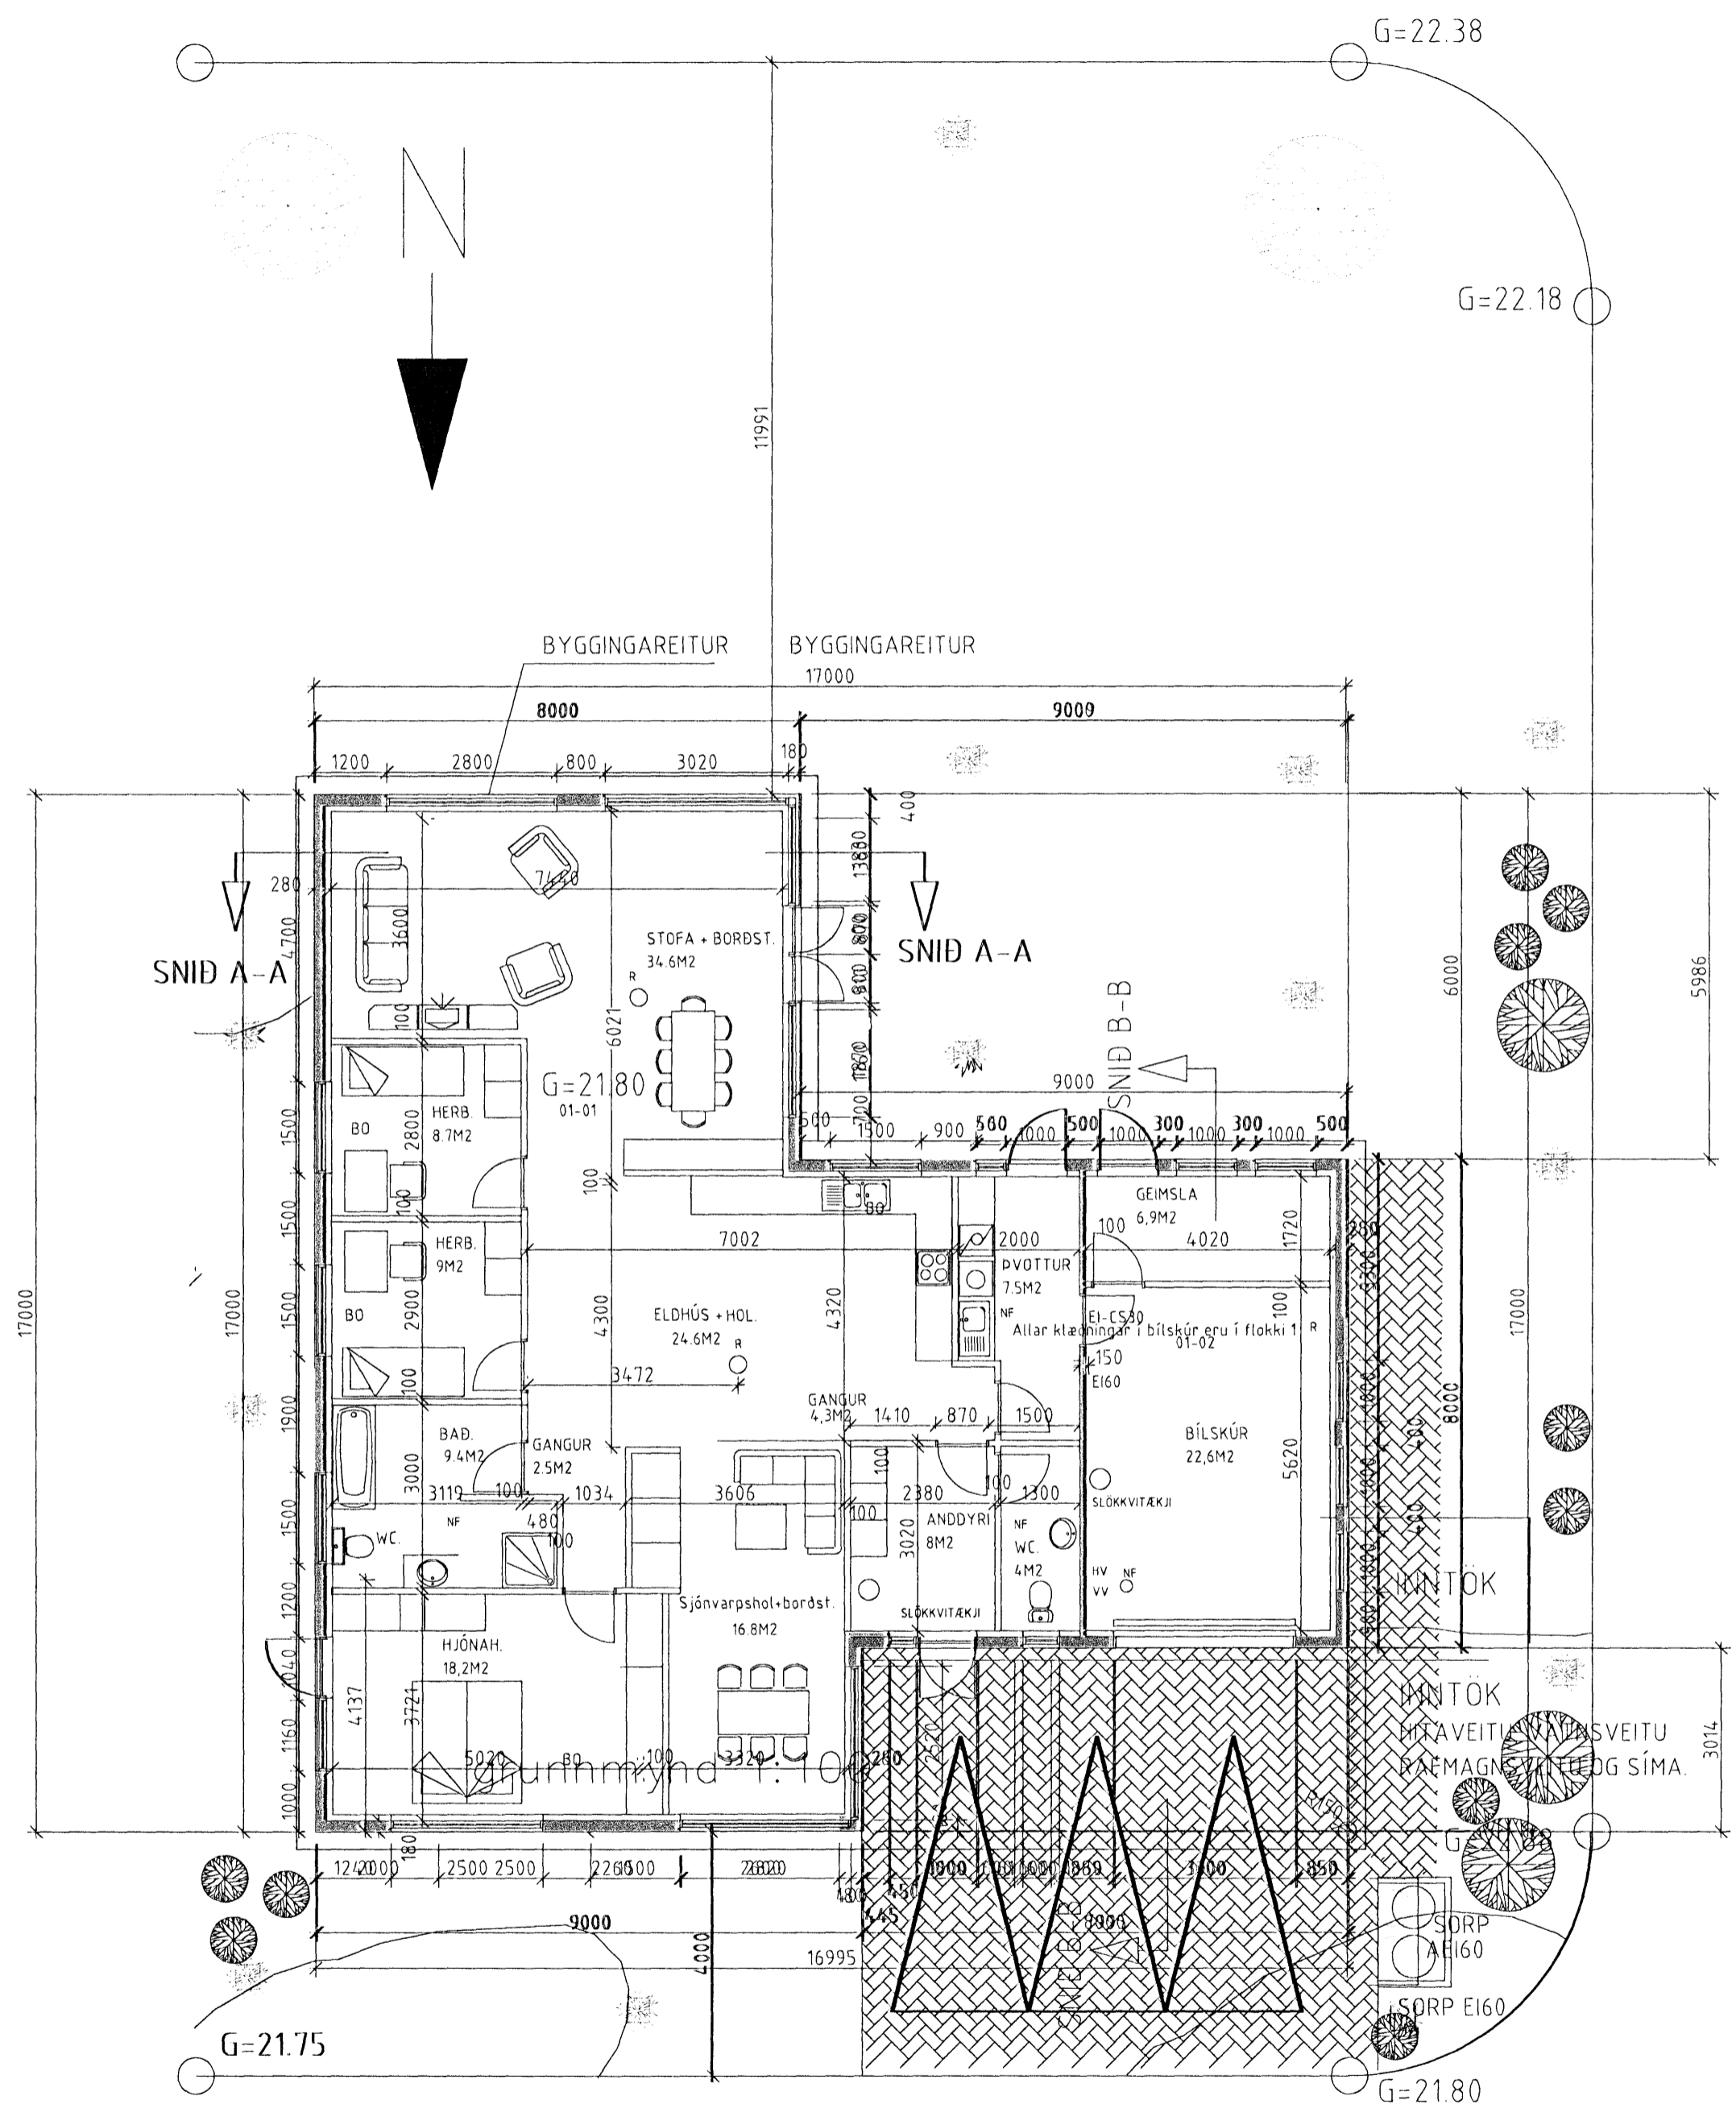

afstöðumynd 1:500

Dags.	Breytingar	Nr.	Nafn	
0505	herb færð			
<b>VBV</b> ALHLIDA HÖNNUN OG RÁÐGJÖF <small>Gsm: 8247587 dhlverk@simnet.is</small>				
Furuvellir 2 HF				
br á herb.skipan				
TÖLVUSKRÁ	HANNAÐ BV <sup>5v</sup>	TEIKNAD BV	YFIRFARID BV	ÓTGÁFA
SAMÞYKKT Björgvin Viglínsson 0405462009	TEIKNING NR.	MKV. 1/100 1/500	BLAD NR.	
DAGS 0505 05		VERK NR.		