


Inntök samþykkt 30.10.2001.
f.h. HITAVEITU SUBURNESJA h.f.
Björg Dóttir

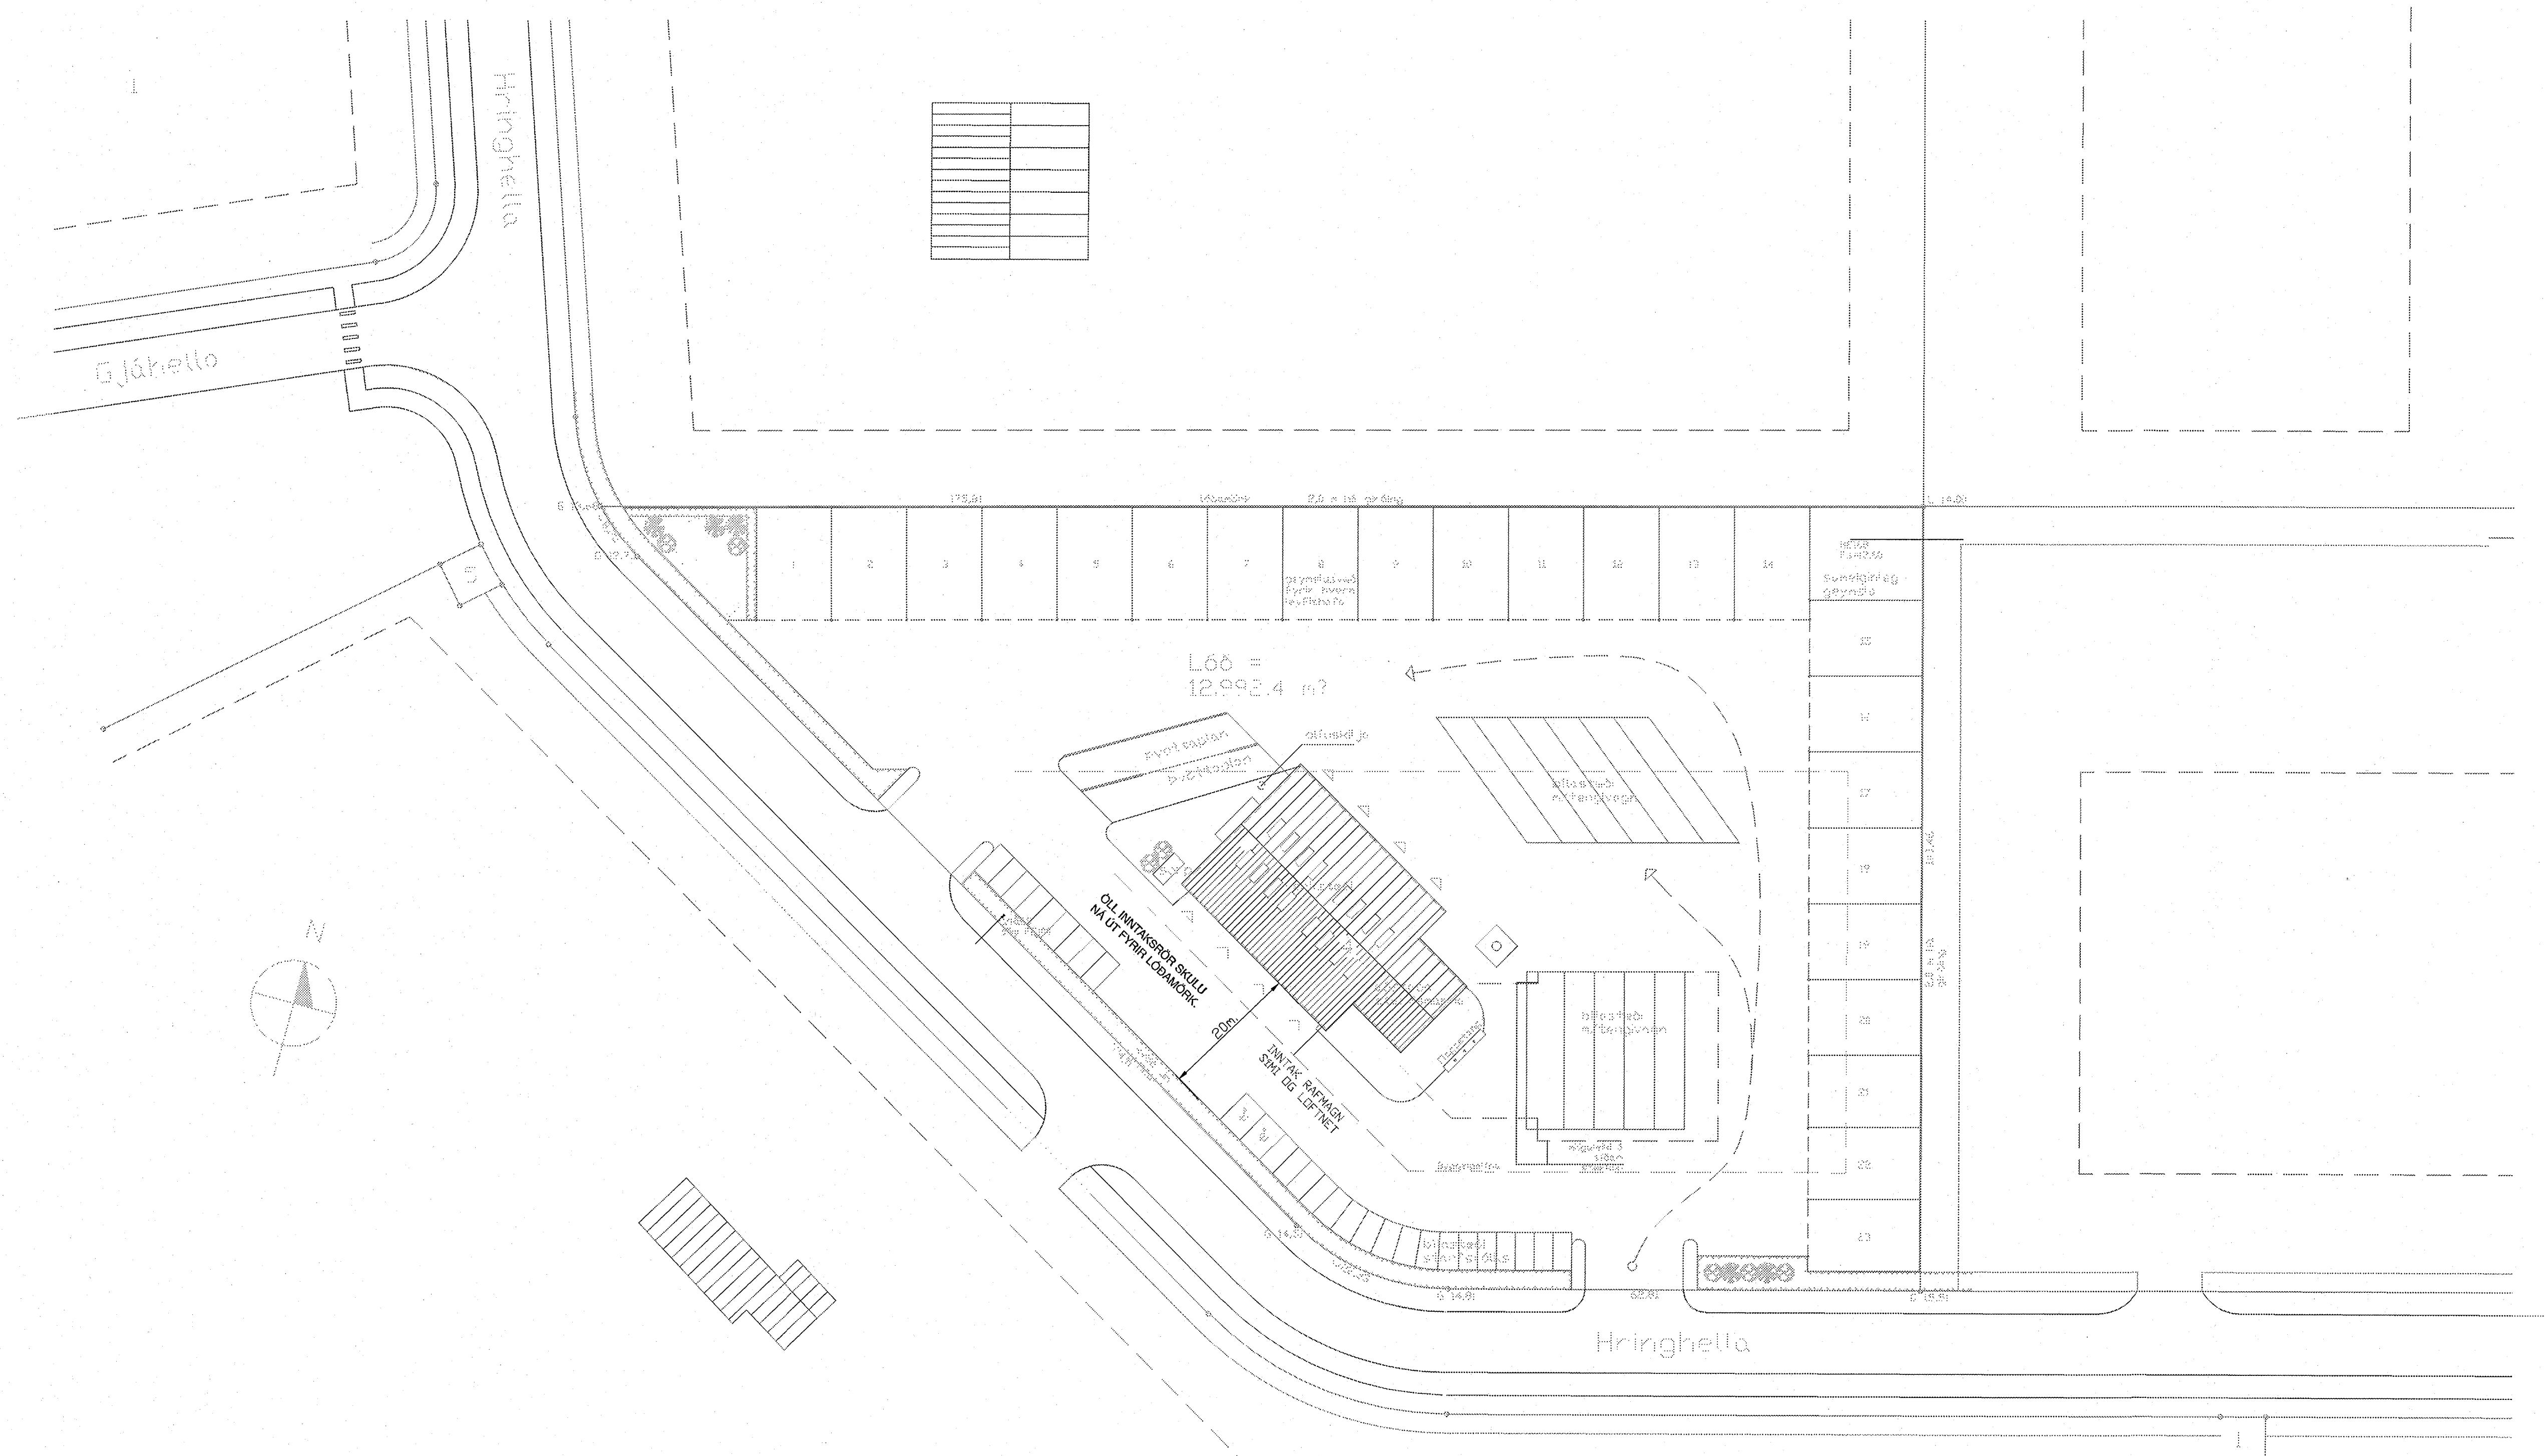

4233

VERKEFNI		HRINGHELLA 4, HAFNARF.		VERKHLUTI		AFSTÖÐUMYND		MKV.
								1:500
H	10/01	Andrés M.	ANDRÉS MAGNÚSSON KT., 311038-3469		SAMP.			TEIKNNR.
T	10/01	Andrés M.	SÍMI: 555-2253 / 898-2253				1	af
DTG.	BREYTING	DAGS.	NAFN	DAGS.	NAFN	KRÁKAMÝRI 7B, 210 GARDABÆ		14
						VERKNR. 165		