



MÖNBARÐ NR 6B HAFNARF.

Byggingafultrúi Hafnarjarðar
Afgreitt þann
27. AUG 2008
Sigríð

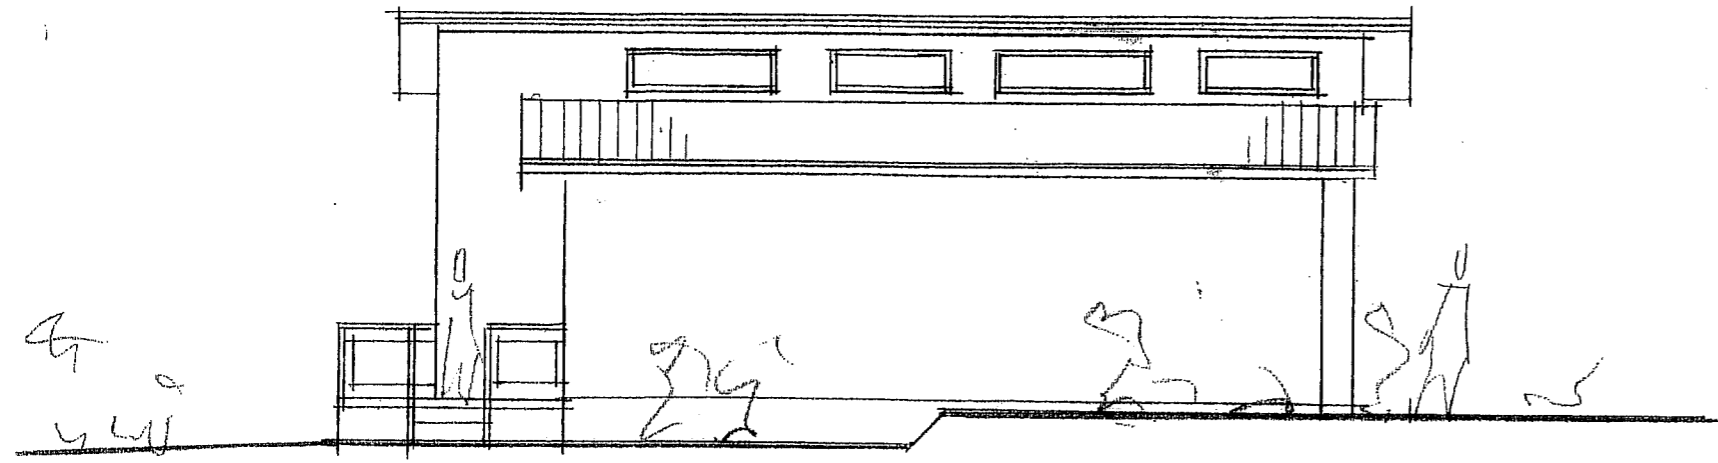


VÍÐA
120

ÚTLIT SÚÐ-VESTUR M 1:100

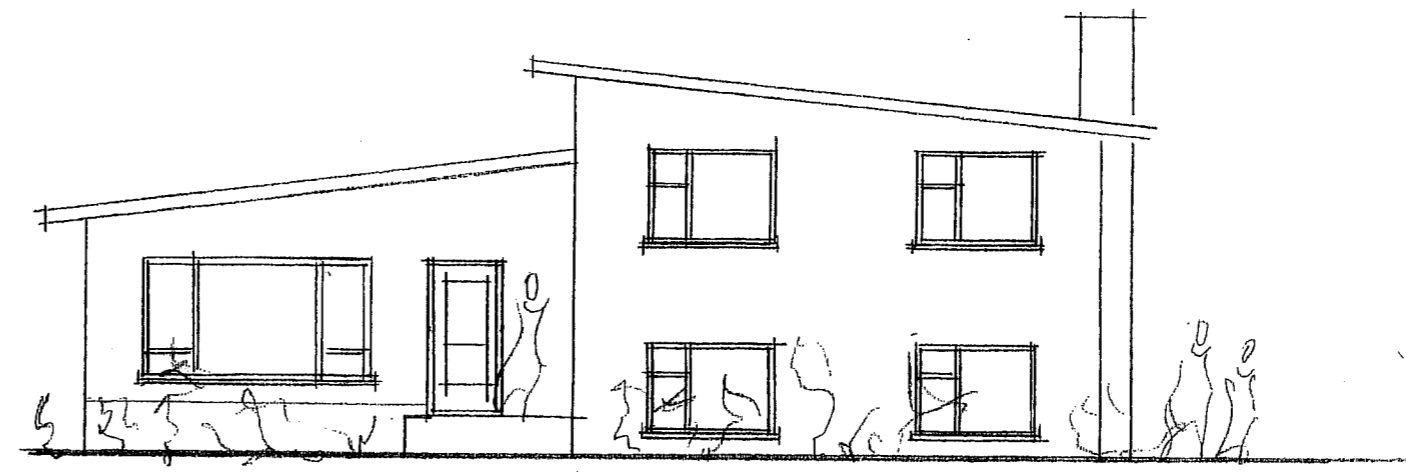


ÚTLIT SÚÐ-AUSTUR M 1:100

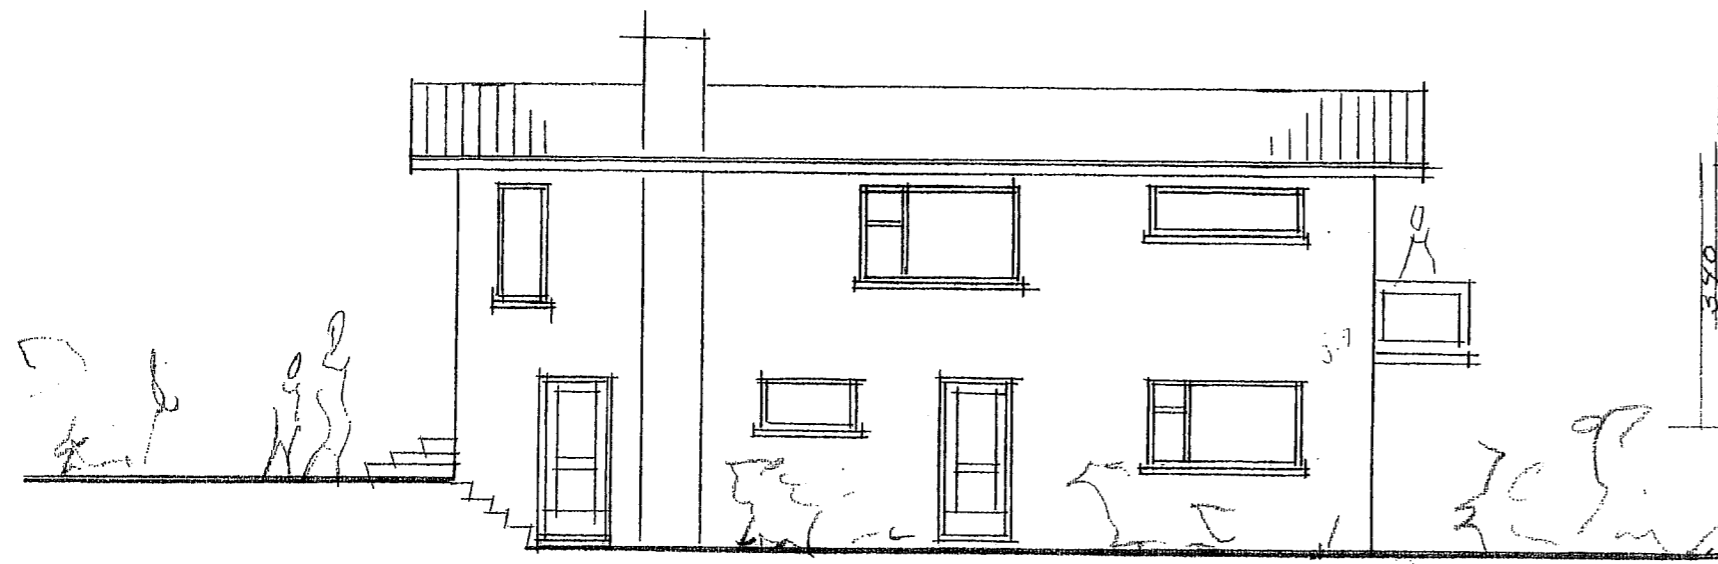


VÍÐBYGGING
390

ÚTLIT NORÐ-AUSTUR M 1:100

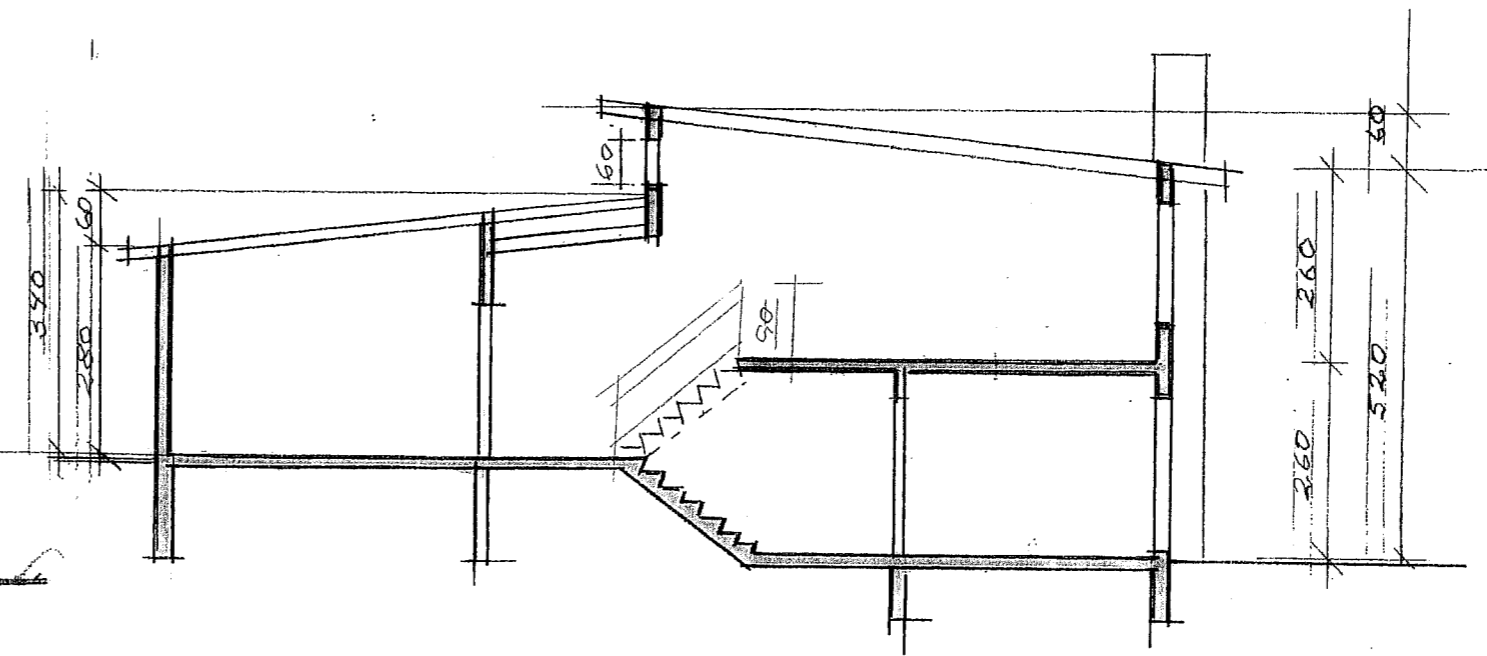

SNÍÐ H-H M 1:100

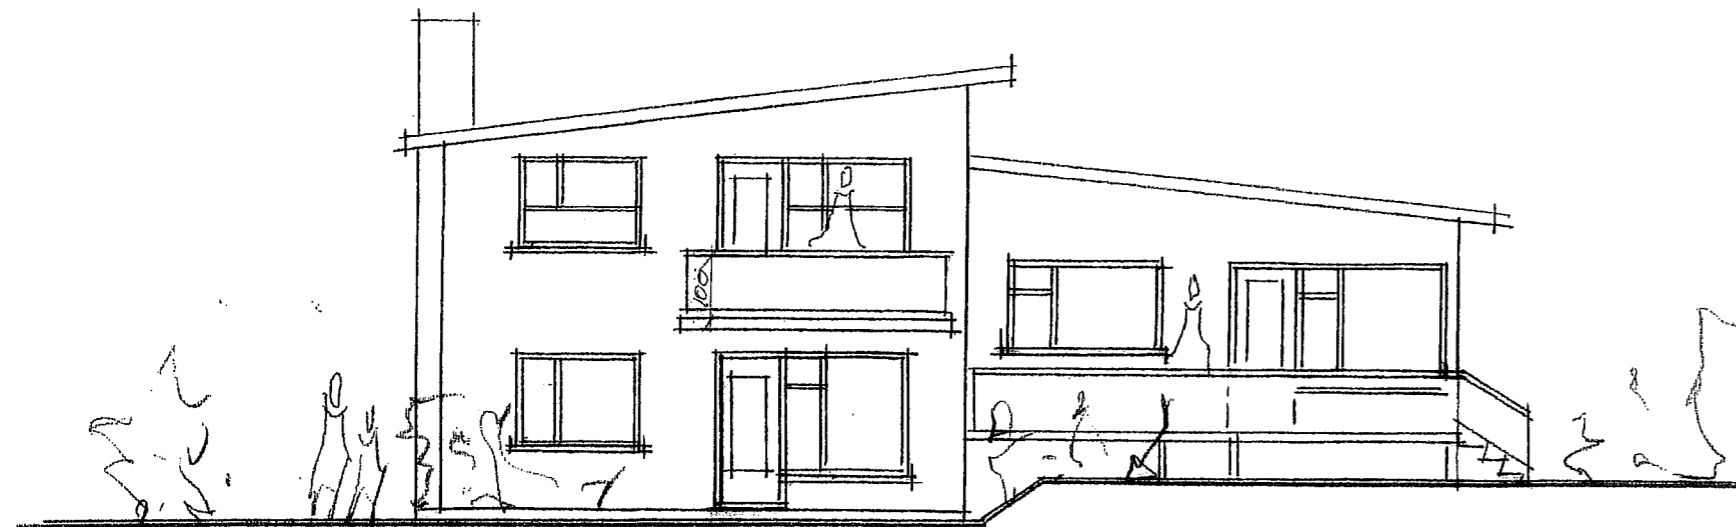


ÚTLIT NORÐ-VESTUR M 1:100

BR. 21.08.2008
SULLI EG. P. SÚÐ-VESTURHLÍÐ FENDUR ÚT *PH*

LAND NR 121949

BR 81806 MÍLS. 19/9.06

MÖNBARÐ 6B HAFNARFÍRÐI

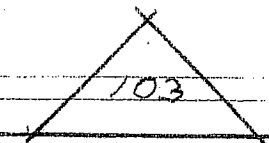

ÚTLIT, SNÍÐ

MÁL 1:100

DAGS 20.05.06

ERLENDUR FRJÓ HÍÐLUNDSSON BEI KLEBERG 6
S = 6645634 RT. 100355-5239

PH