


Inntök samþykkt 18/12 2001.  
f.h. HITAVEITU SUÐURNESJÁ h.f.  
*Björg Dagsbjörnsdóttir*

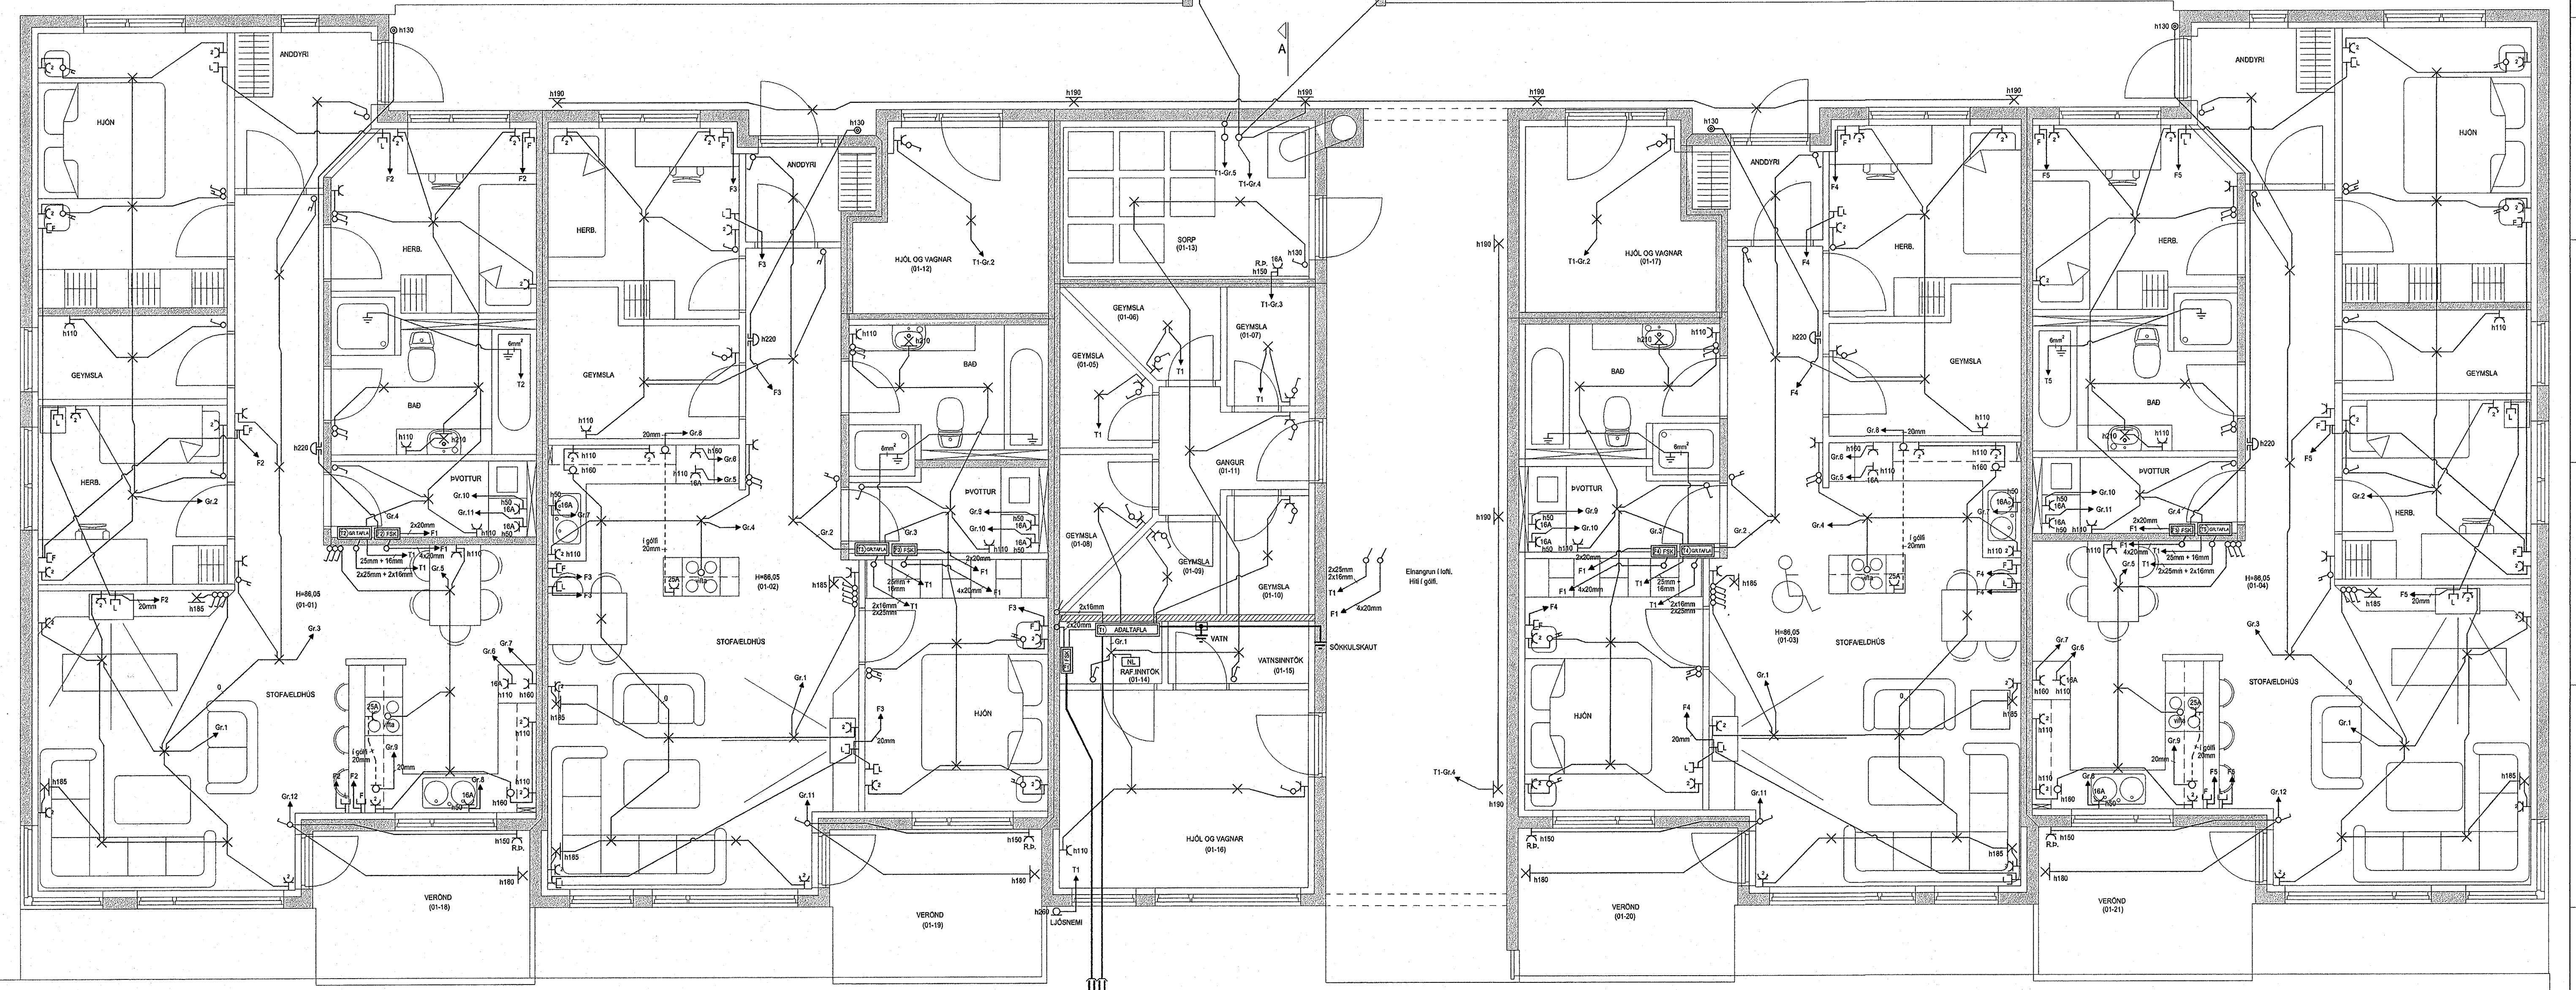

GRUNNMÝND 1. HÆÐ

PIPUR SKULU NA AD LOBARMRORUM  
LOFTRET 32mm PP  
HEIMTAUG SIMA 2, 50MM PP  
GARDLÓ'S 32mm PP  
HEIMTAUG RM 80mm PP

DAGS.	16.07.2001	SÍÐA NR.	1 AF 4	HANNAB	HKE	VERKEFNI	ÞRÁSTARÁS 16, HAFNARFIRÐI
TEIKN NR.	AR-01	TÖLVUHEITI	GRÞHRÁSTARÁS16	TEIKNAD	PHS	RAFLÖGN	RAFLÖGN
VERKHJUTI	GRUNNMÝND 1. HÆÐ	BREYTING A		YFIRFARIB	HKE		
MKV.	1:50	BREYTING B					