


DALSHRAUN 3

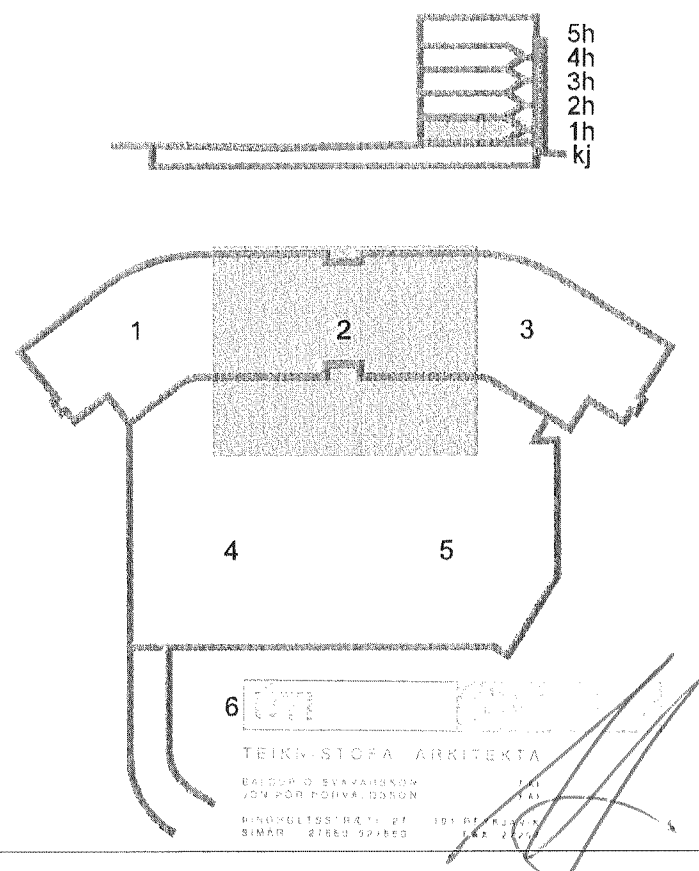

A 09.07.13 Skrifstofunými og breytingar við tröppur (miðrym). BSG/ÖG  
Útg. Dags. Skýring Hannas/Yrfrarió



VERKFRÆDISTOFA

BEJARIHRAUN 20 • 220 HAFNARFJÖRÐUR • KENNIT. 710796-2899  
vsb@vsb.is • Sími 585 8600 • Fax 585 8610 • www.vsb.is

Áritun sérhönnuðar					
Örn Guðmundsson					
Rt. 220961 2739 • orn@vsb.is					
Verkefni					
DALSHRAUN 3					
HAFNARFIRÐI					
Verkhúsi					
Rafkerfi					
Lampaplan 1.hæð					
Grunnmynd 2					
Hannaó	Teiknaó	Yrfrarió	Kvarði	/ A1	Síða
VD	VD	BSG	1.50		-
Dags.	Verkefni	Teikning	Útgáfa		
13.05.2008	07244	R2 012	A		