
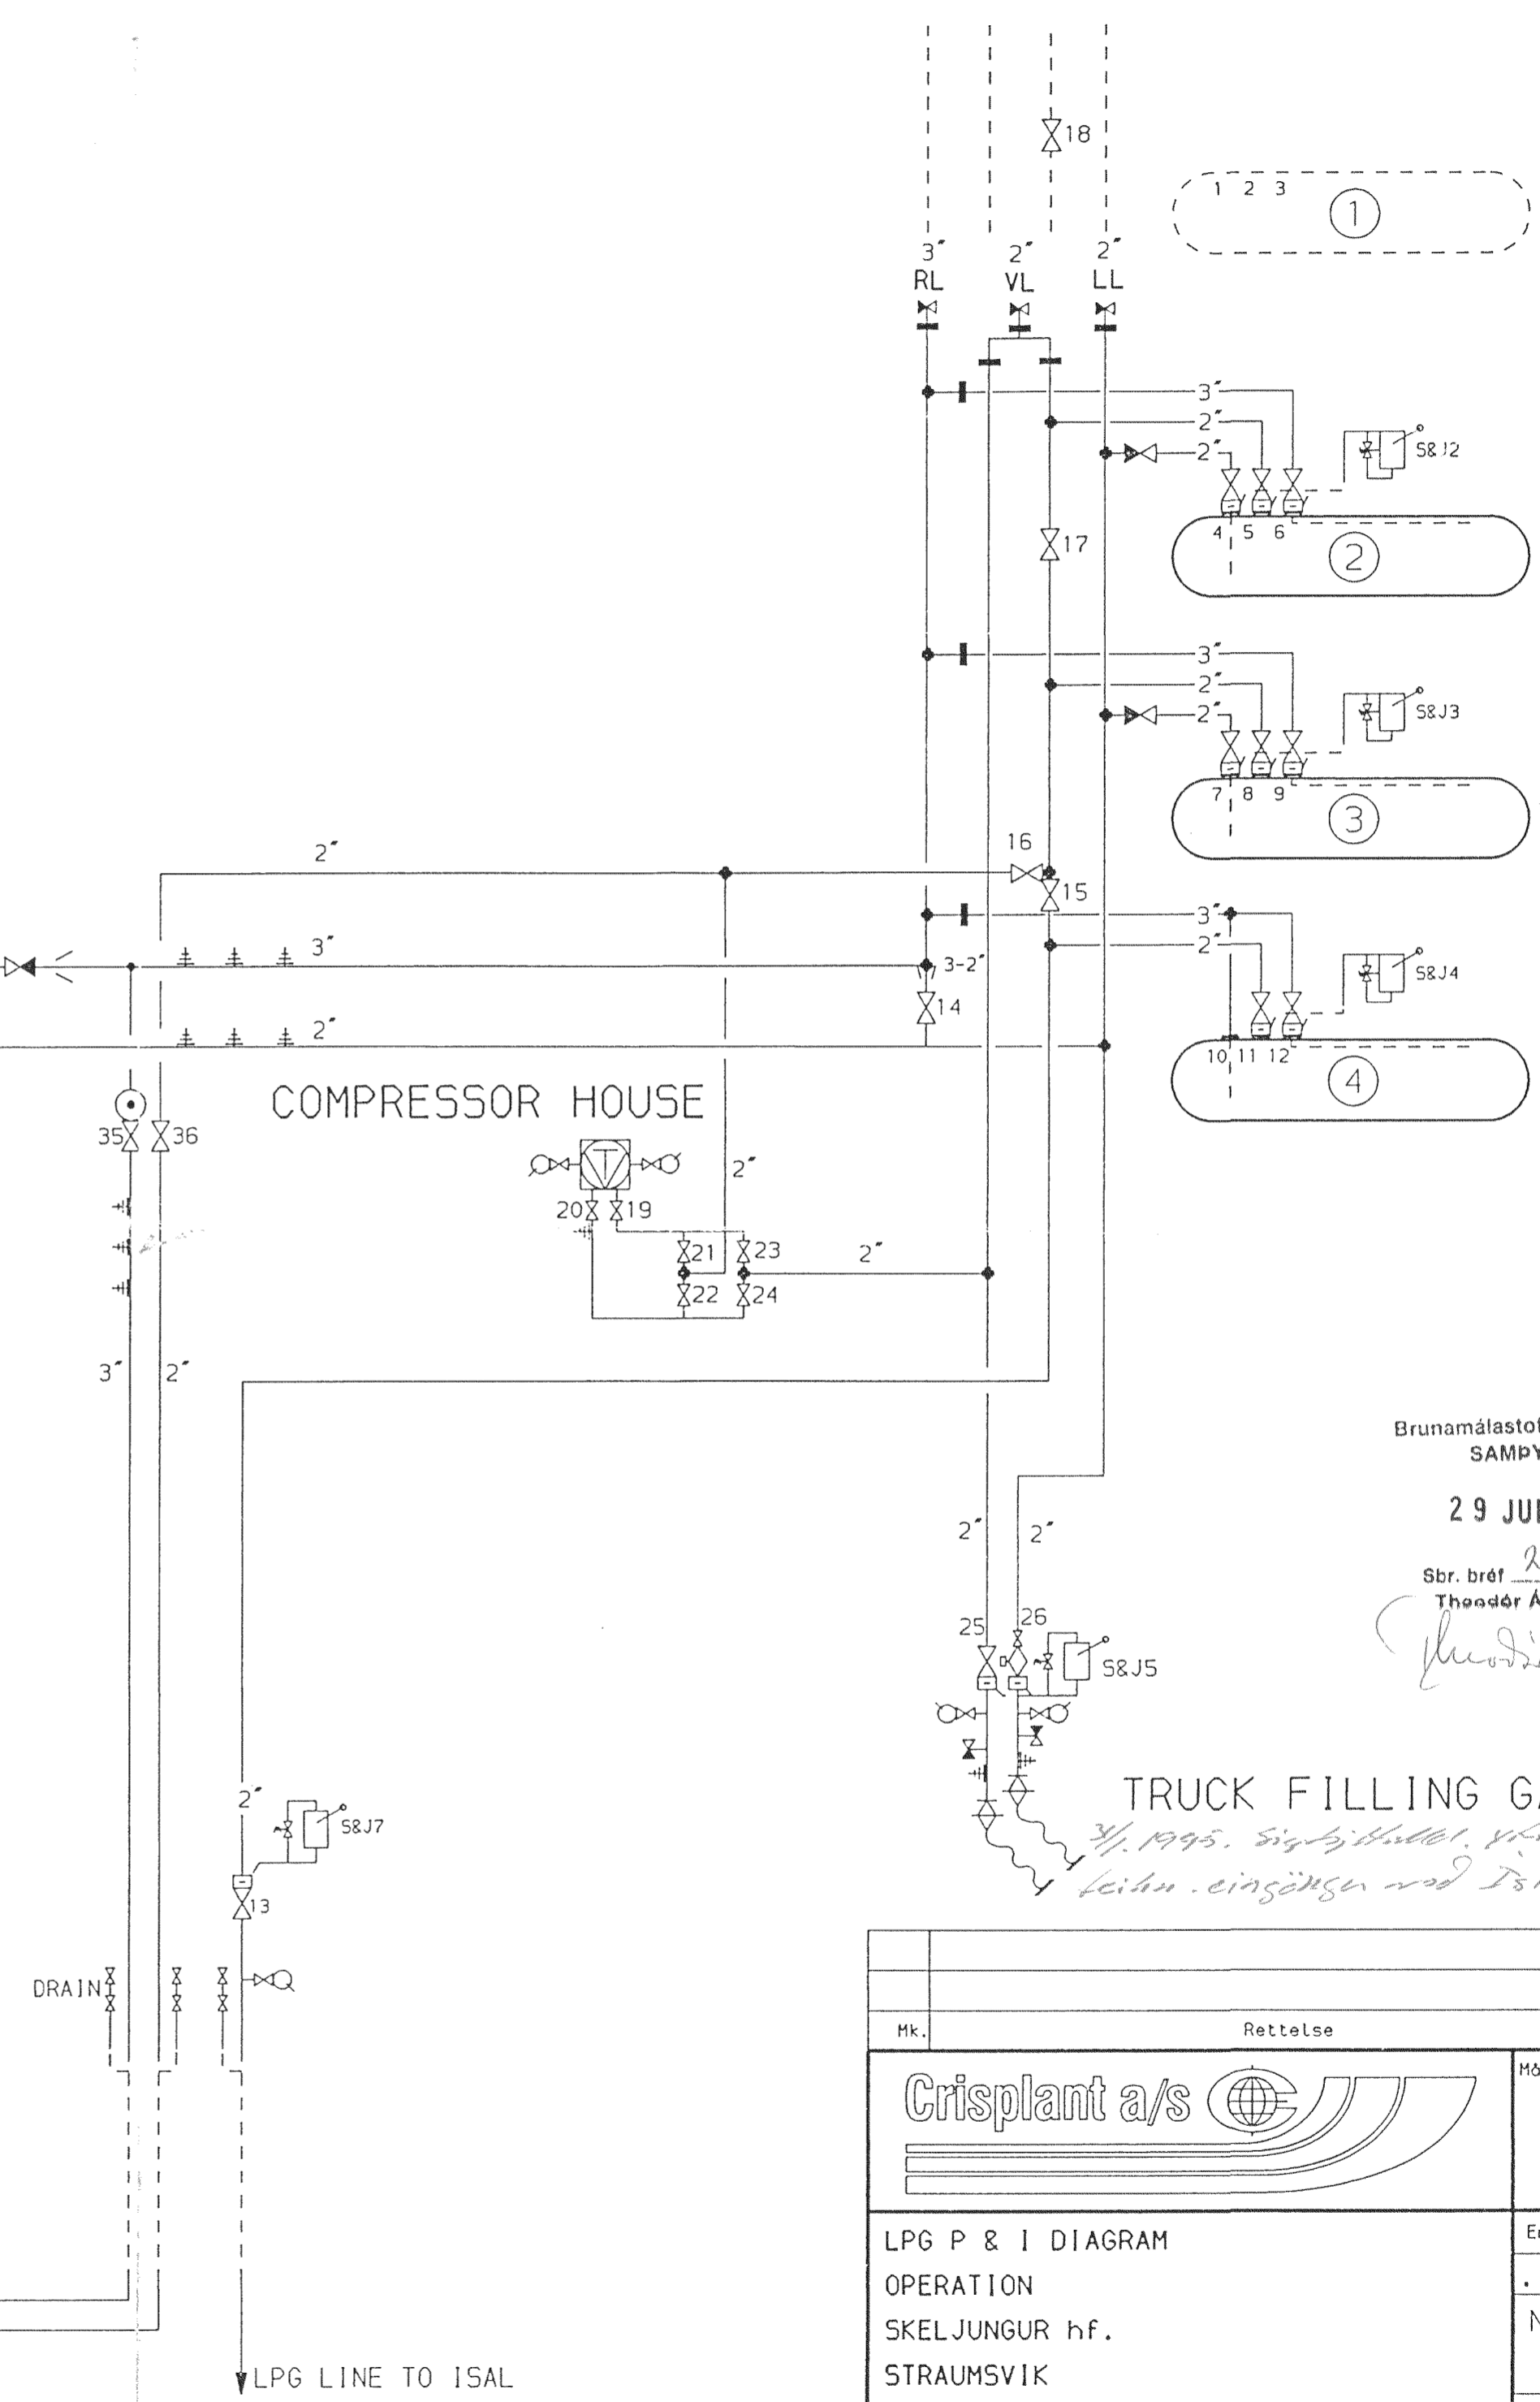
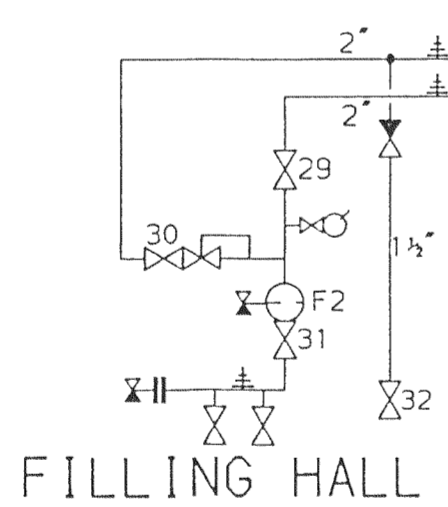


- LL— LIQUID LINE
- VL— VAPOUR LINE
- RL— RETURN LINE
- X— BLOCK VALVE
- H— HYDRAULIC QUICK CLOSING VALVE
- C— CHECK VALVE
- F— FILTER
- SR— SAFETY RELIEF VALVE
- D— DRAIN/VENT. VALVE
- M— MANOMETER
- P— LPG PUMP
- C— LPG COMPRESSOR
- H— LOADING HOSE
- D— DIFF. PRESSURE VALVE
- G— SIGHT GLASS

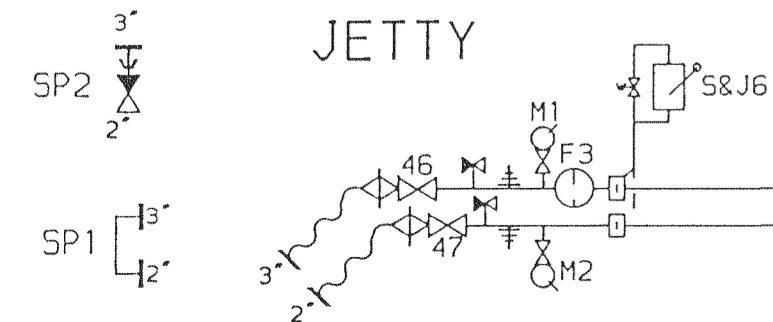

TANKYARD

Brunamálastofnun ríkisins
SAMPYKKT

29 JUN 1994

Sbr. bréf 29/6 1994
Theodor Arnason

Theodor Arnason

TRUCK FILLING GANTRY


Mk.	Rettelise	Dato	Tegn.	Konf.
Crisplant a/s		Málforhold	Tegn.	KPR
			Konf.	BRL
		Godk.		940318
LPG P & I DIAGRAM OPERATION SKELJUNGUR hf. STRAUMSVIK ICELAND		Erstatning for: Nr. 268B120.2 Rev. 0 Erstattet of:		