
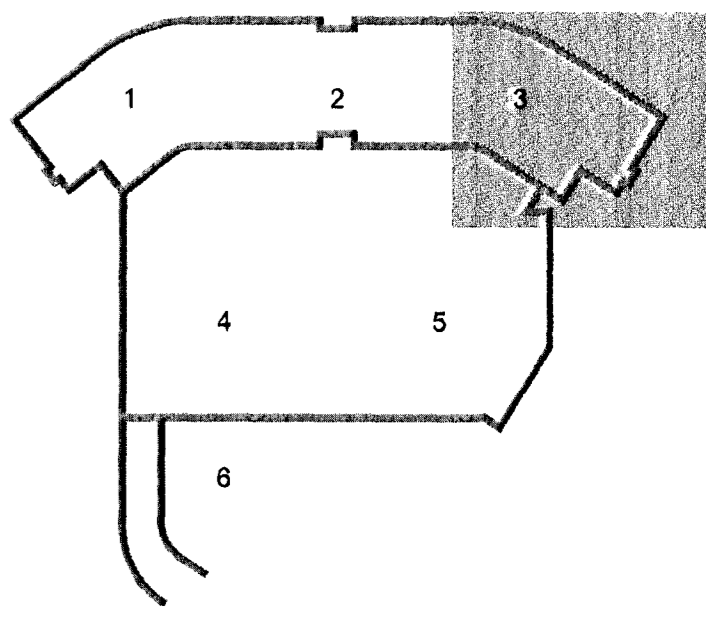


ús, fundarherb og fl.

ÚTI
ARKITEKTAR
Jón Þór Þorvaldsson Af, FSS
Kt. 021256 7579

DALSHRAUN 3

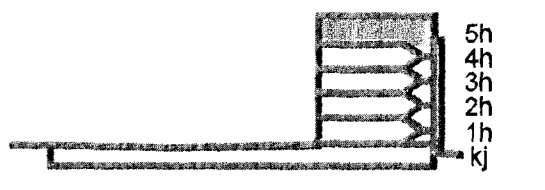

B 12.08.13 Færsla á lömpum í mataal BSG/AR
A 09.07.13 Skrifstofuými og breytingar við tröppur (míóymí) BSG/ÓG
Ulg. Daga: Skýring Hannes/Virfanó



VERKFRÆÐISTOFA

BÆJARHRAUN 20 • 220 HAFNARFJÖRÐUR • KENNIT. 710796-2899
vsb@vsb.is • Sími 585 8500 • Fax 585 8610 • www.vsb.is

Aflun sérhönnuðar
Órn Guðmundsdóttir
Kt. 220961 2738 • orn@vsb.is

Verkefni
DALSHRAUN 3
HAFNARFIRÐI

Verkið
Rafkerfi
Lampaplan 5 hæð
Grunnmynd 3

Hannaf	Teknað	Virfanó	Kvæði	Síða
VD	VD	BSG	1:50	/ A1
Dags.	03.06.2008	Verkefni	07244	Talkning
		Utgáfa	R2 053	B