
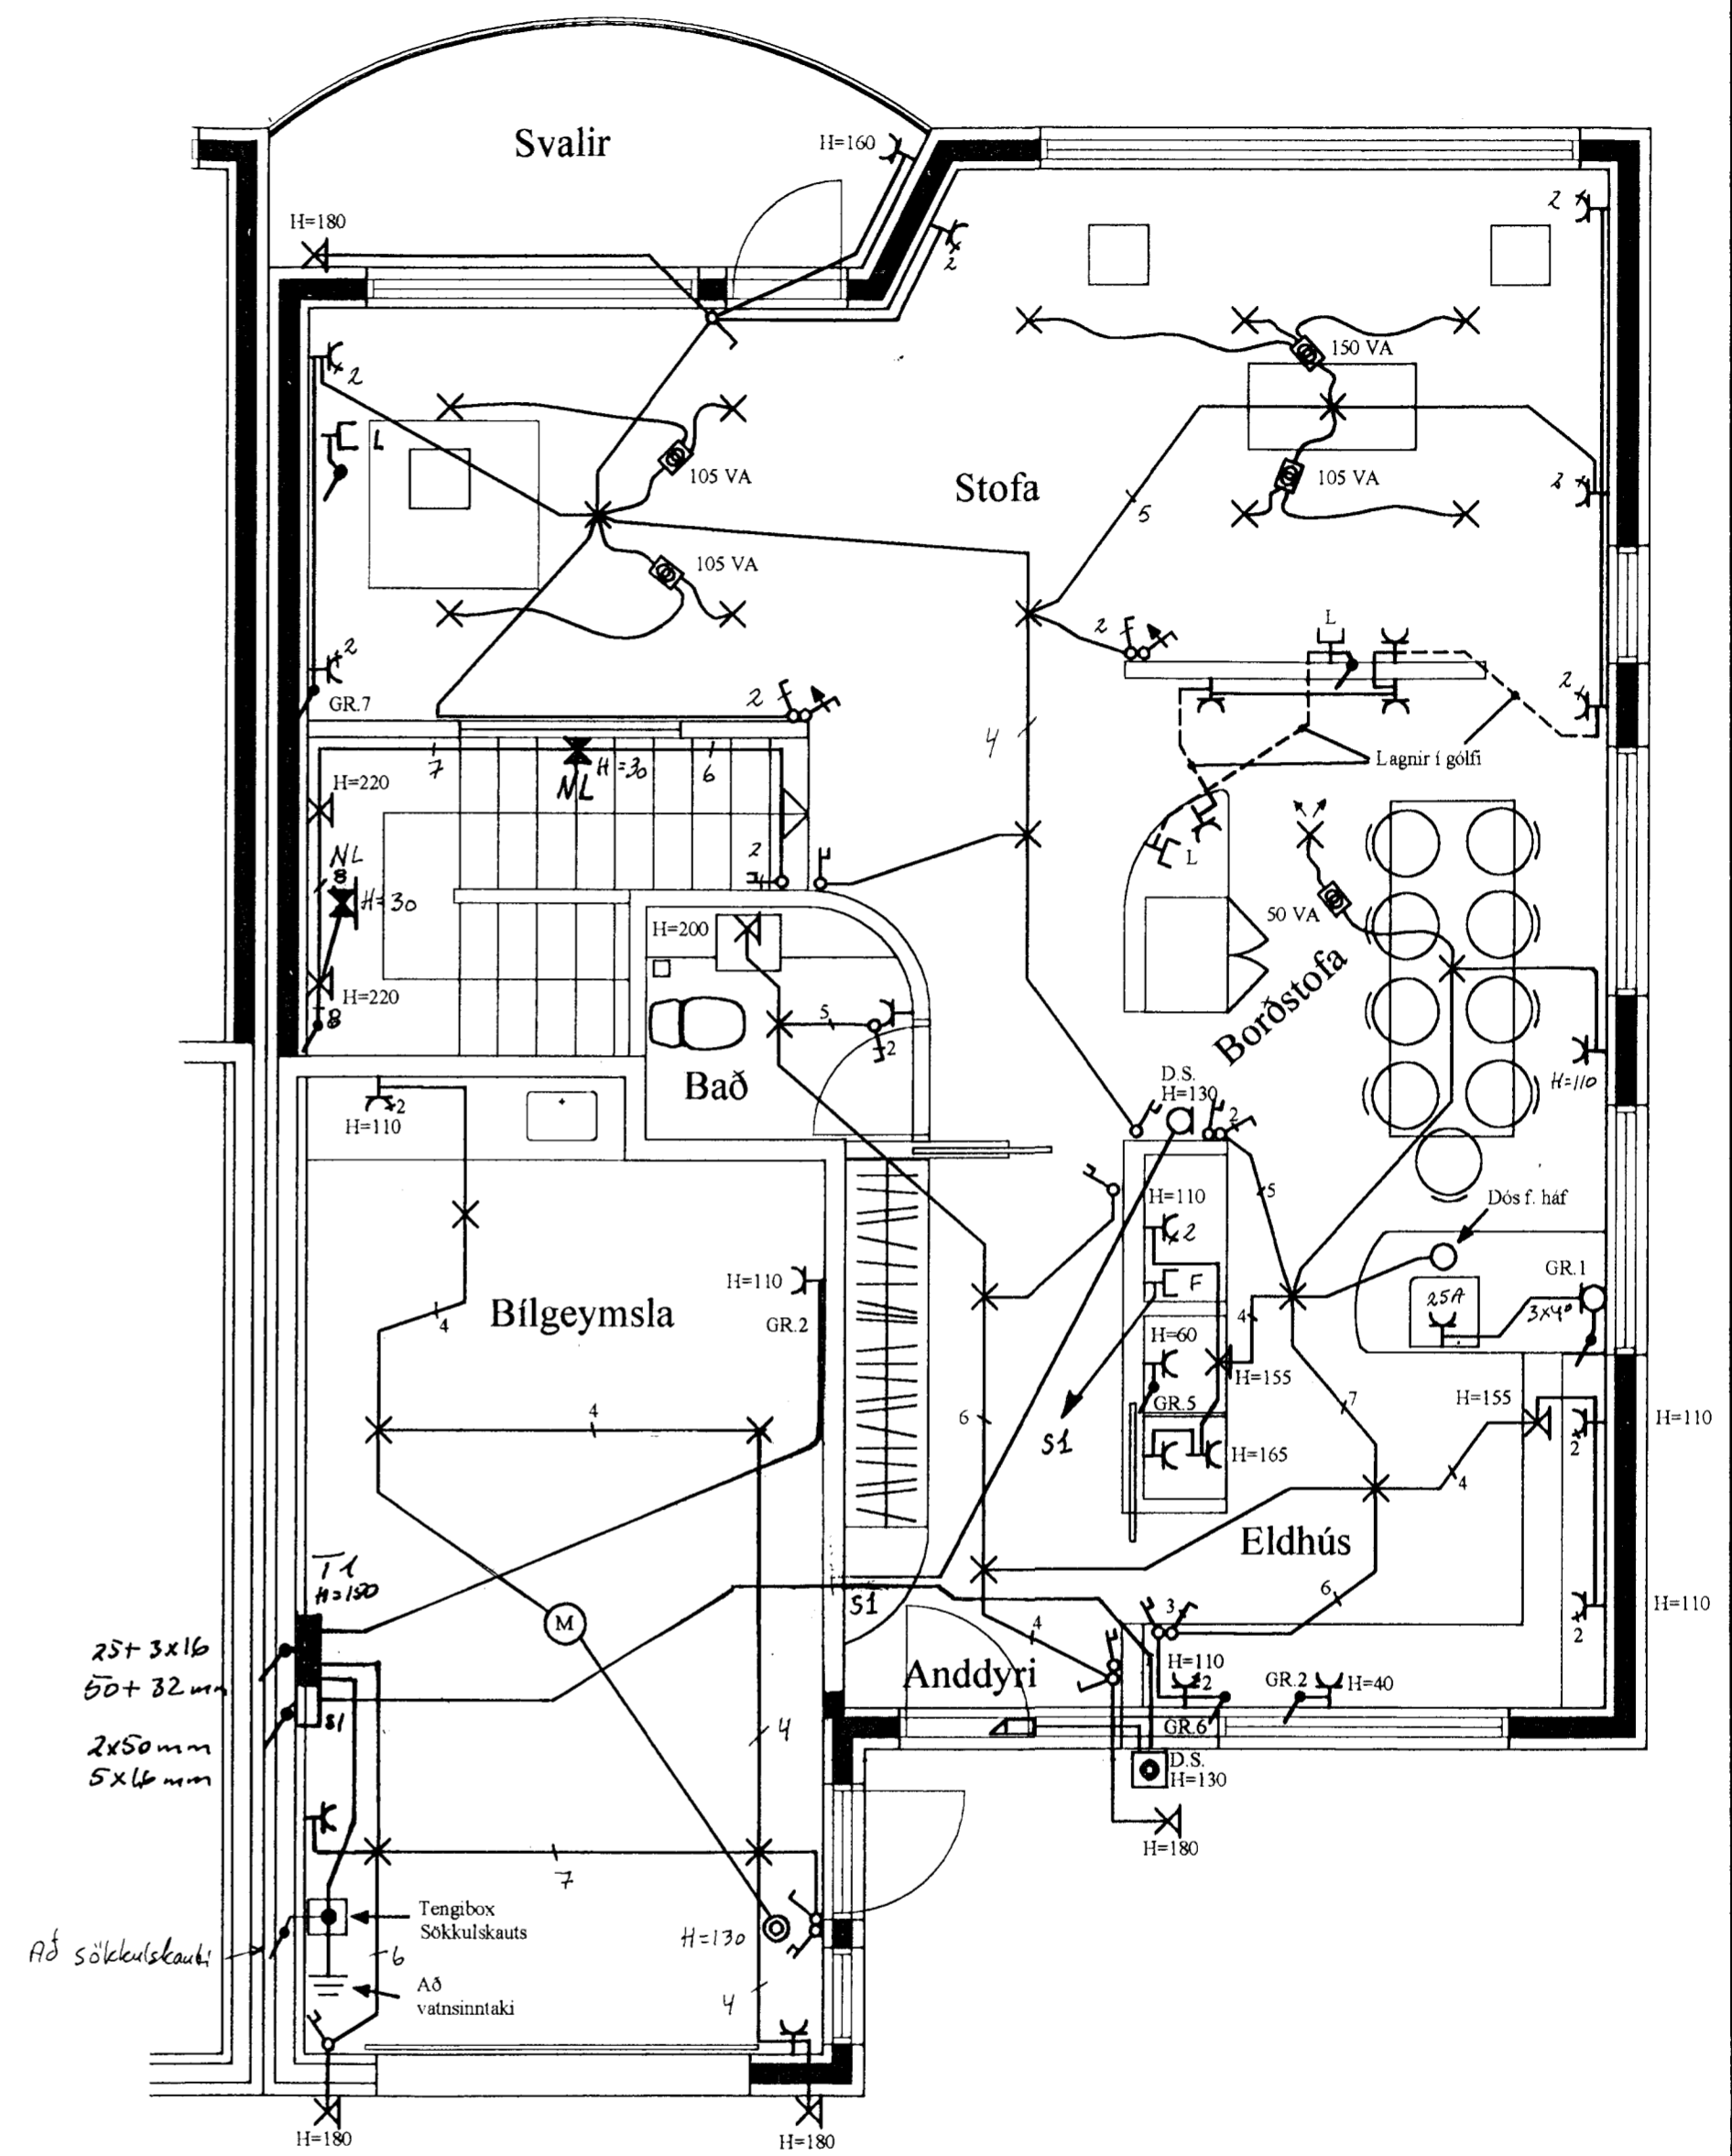


TAFLA T2

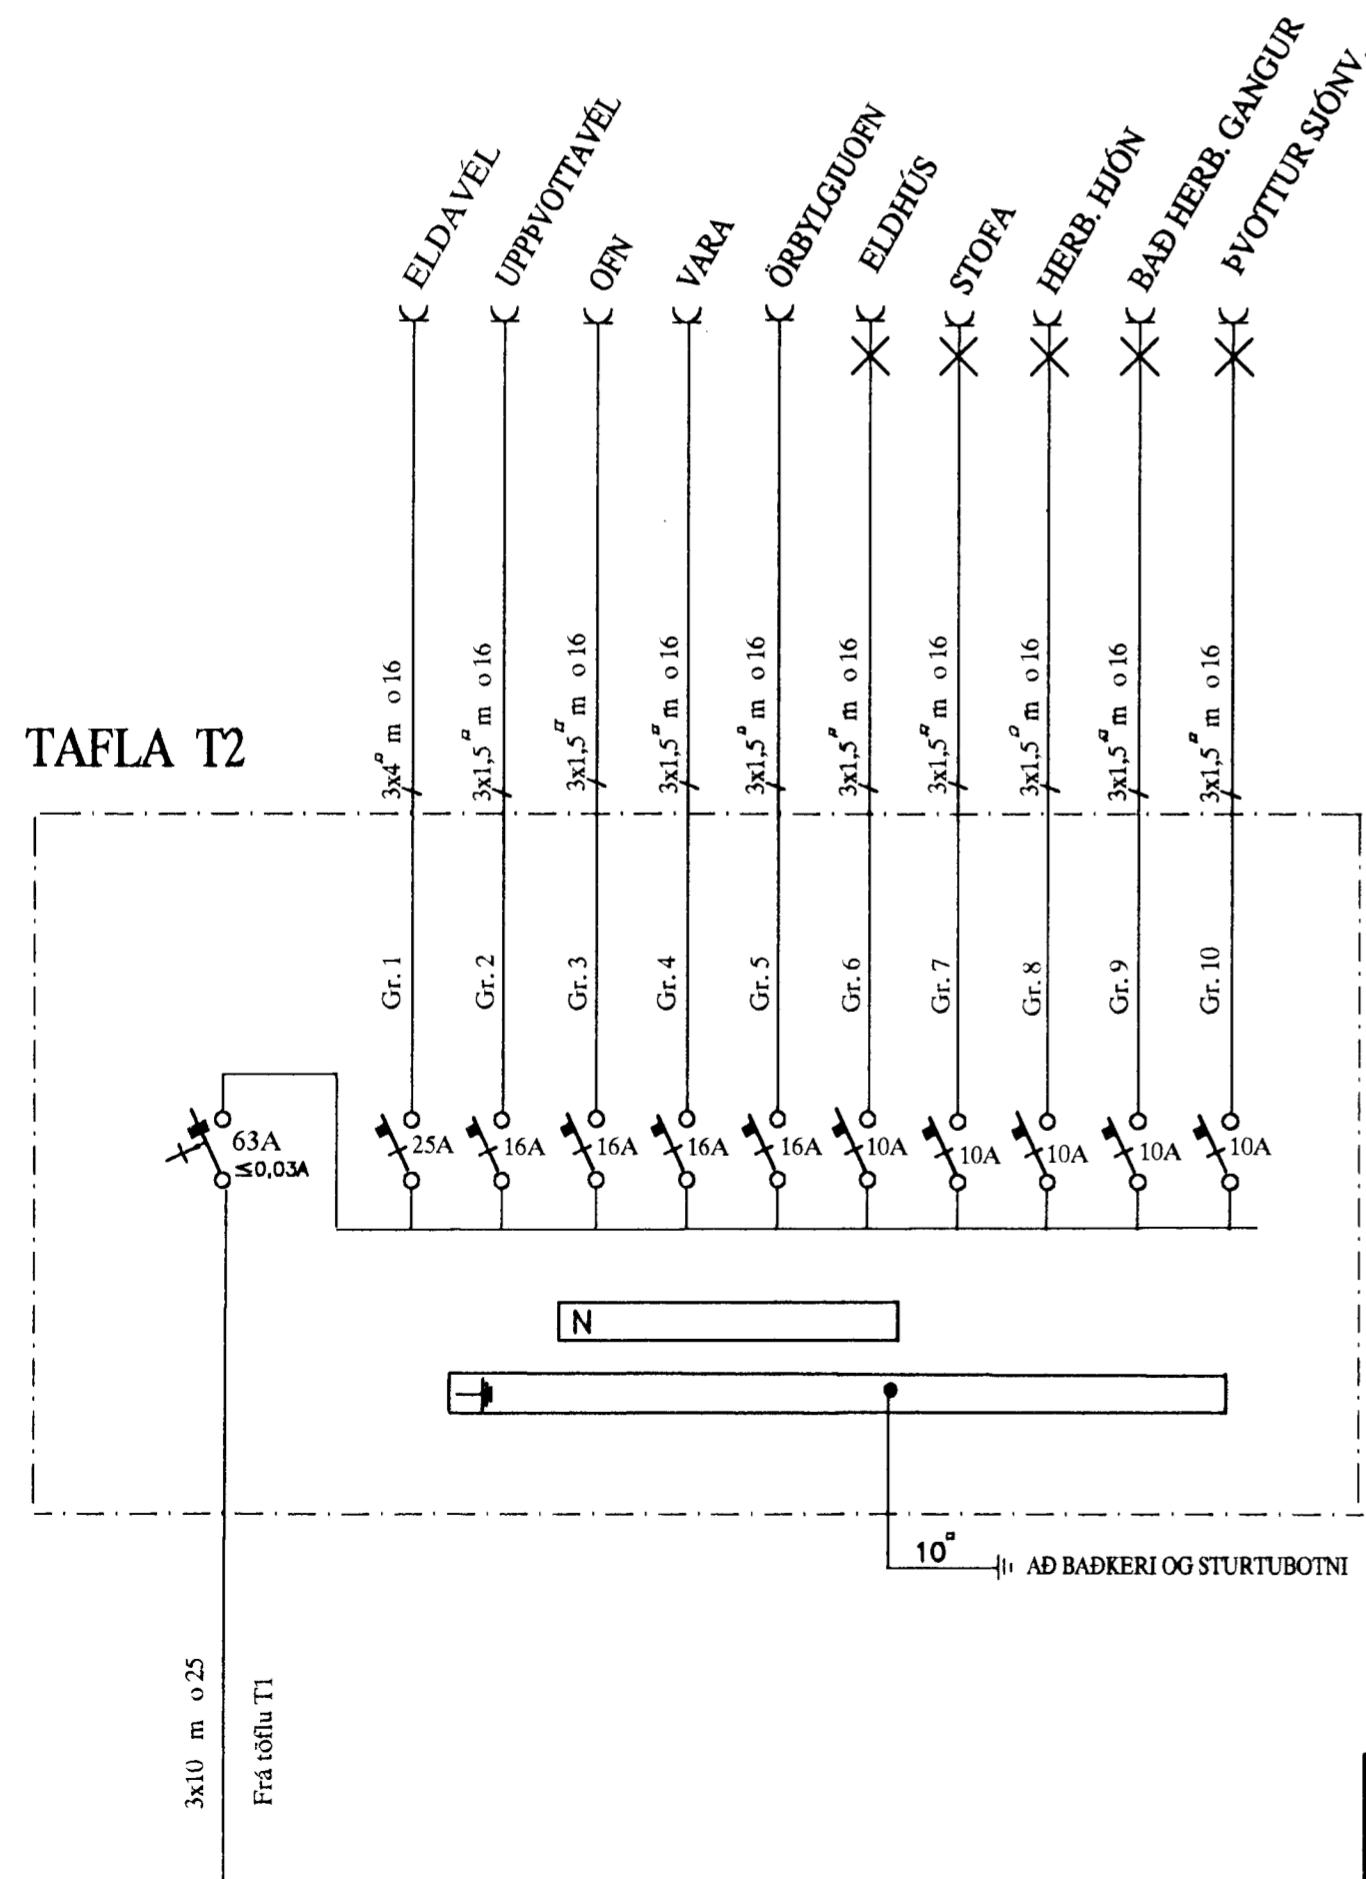

						KRÍUÁS 43 HAFNARFIRÐI		MRV. 1:50 %	
						RAFLÖGN EFRI HÆÐ OG TAFLA - T2		TEIKN.NR. 3	
								SIDASTA INR.	
A	01.06.06	HEIMTAUGARTEIKNING OG FULLNADART.	B.b.T.	T.S.	Transil Sveinbjörn	220146-2439	TERA s/p	RAFMAGNISVERKFRÆÐISTOFA	INR. 3 AF 3
ÚTG.	DAGS.		TEIKN.	HANNAÐ	SAMÞYKKT	KENNITALA		EDMUND BELLERSEN TRAUUSTI SVEINBJÖRNSSON	ÓTG. A
								SÉMI 5687388 RAFMAGNISSTJÓRNUN SÉMI 5687390	
								GEYMSLUNR. GRANNING.LOU	