
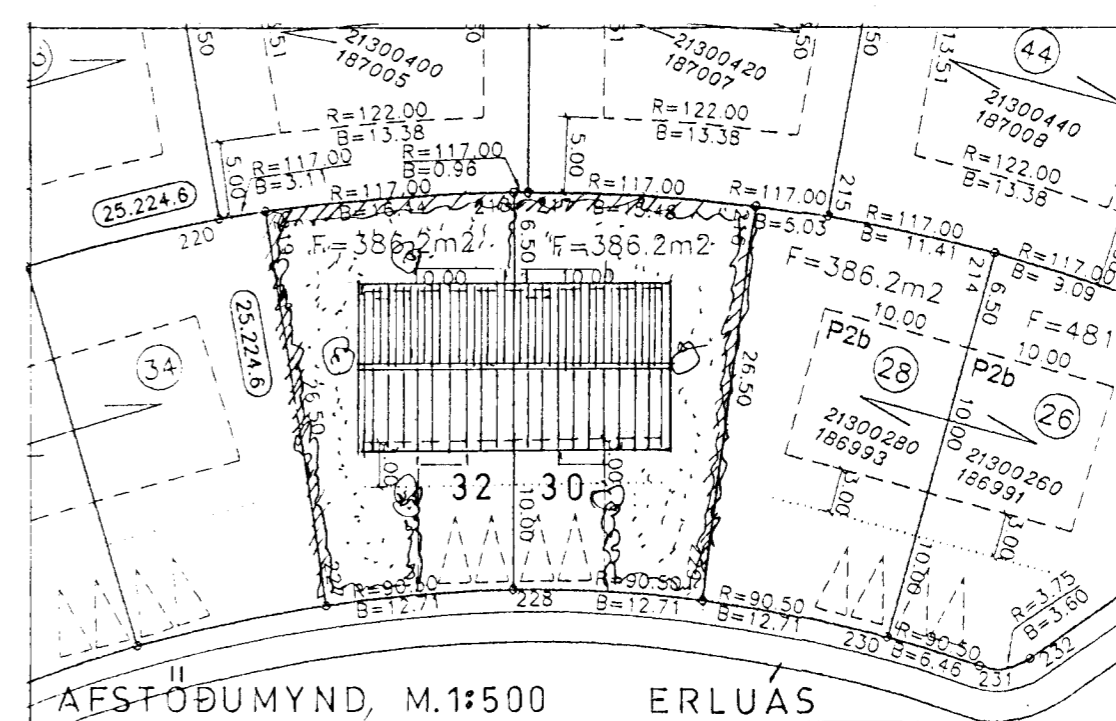
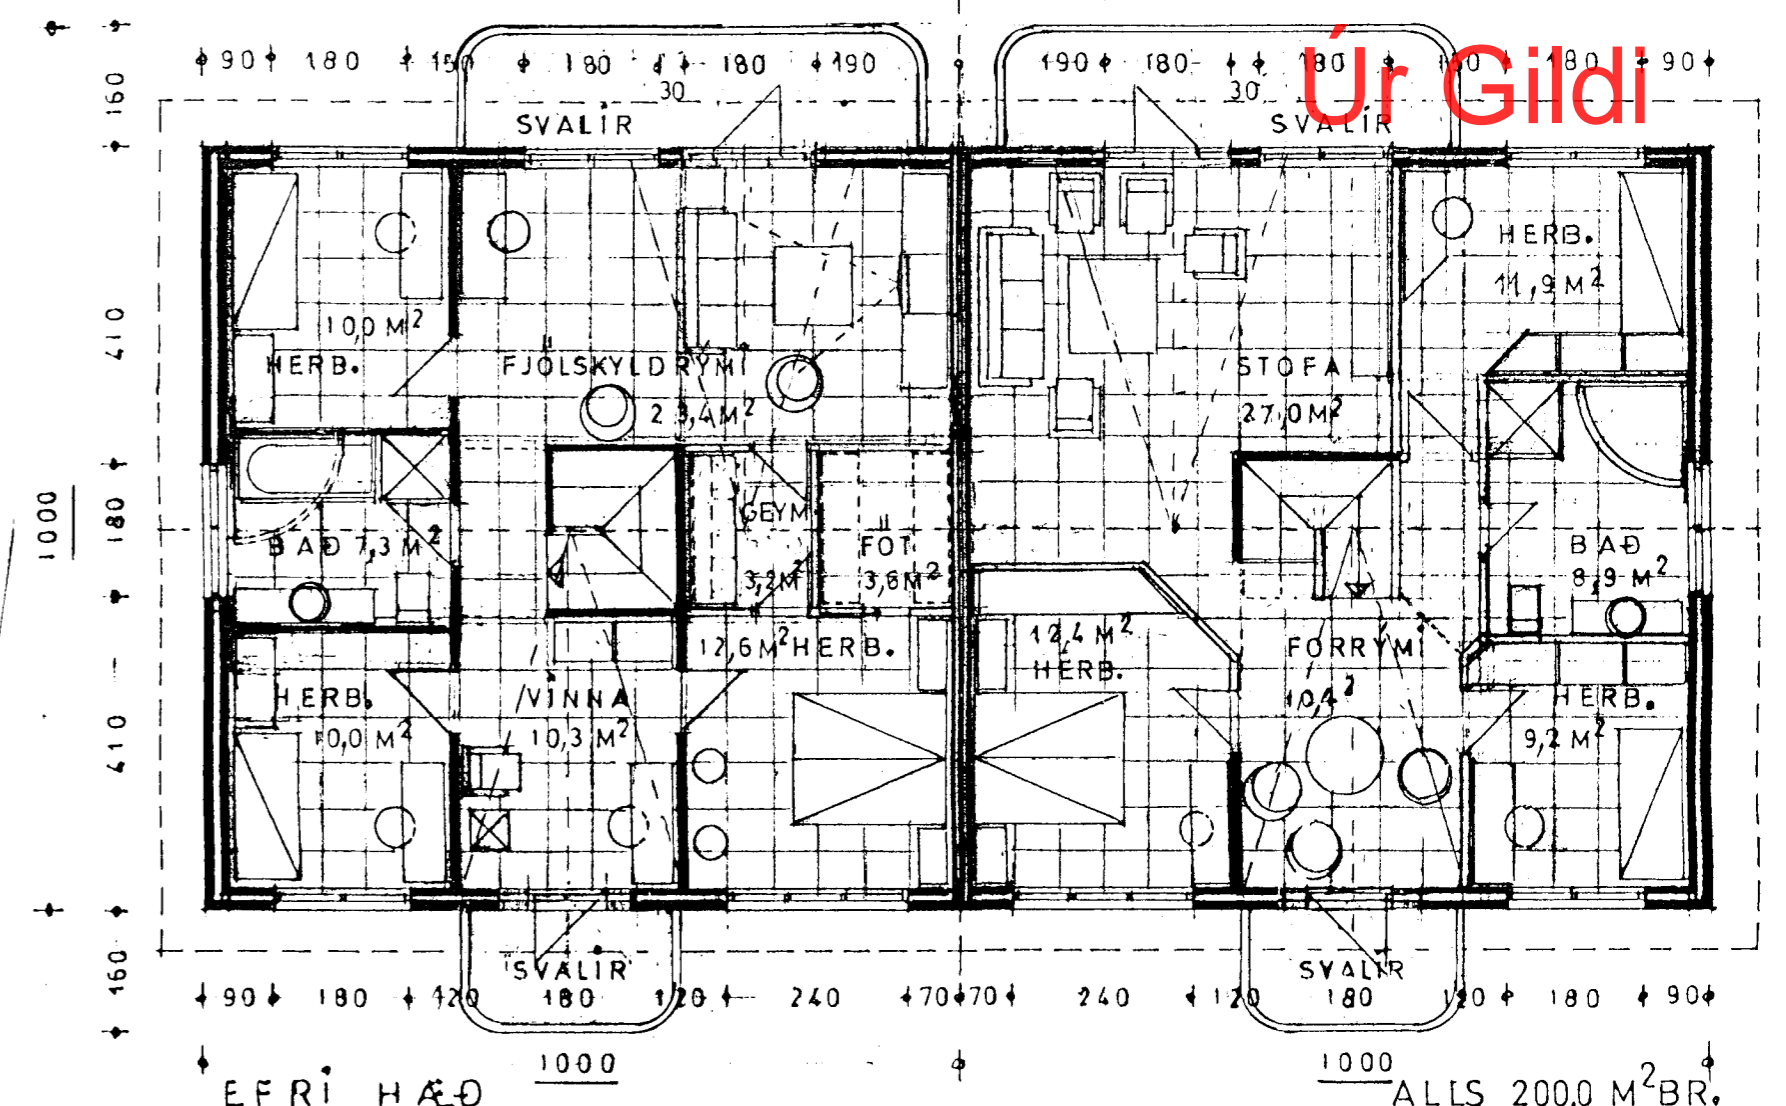


5/4 2001 fullnámshættir
JP

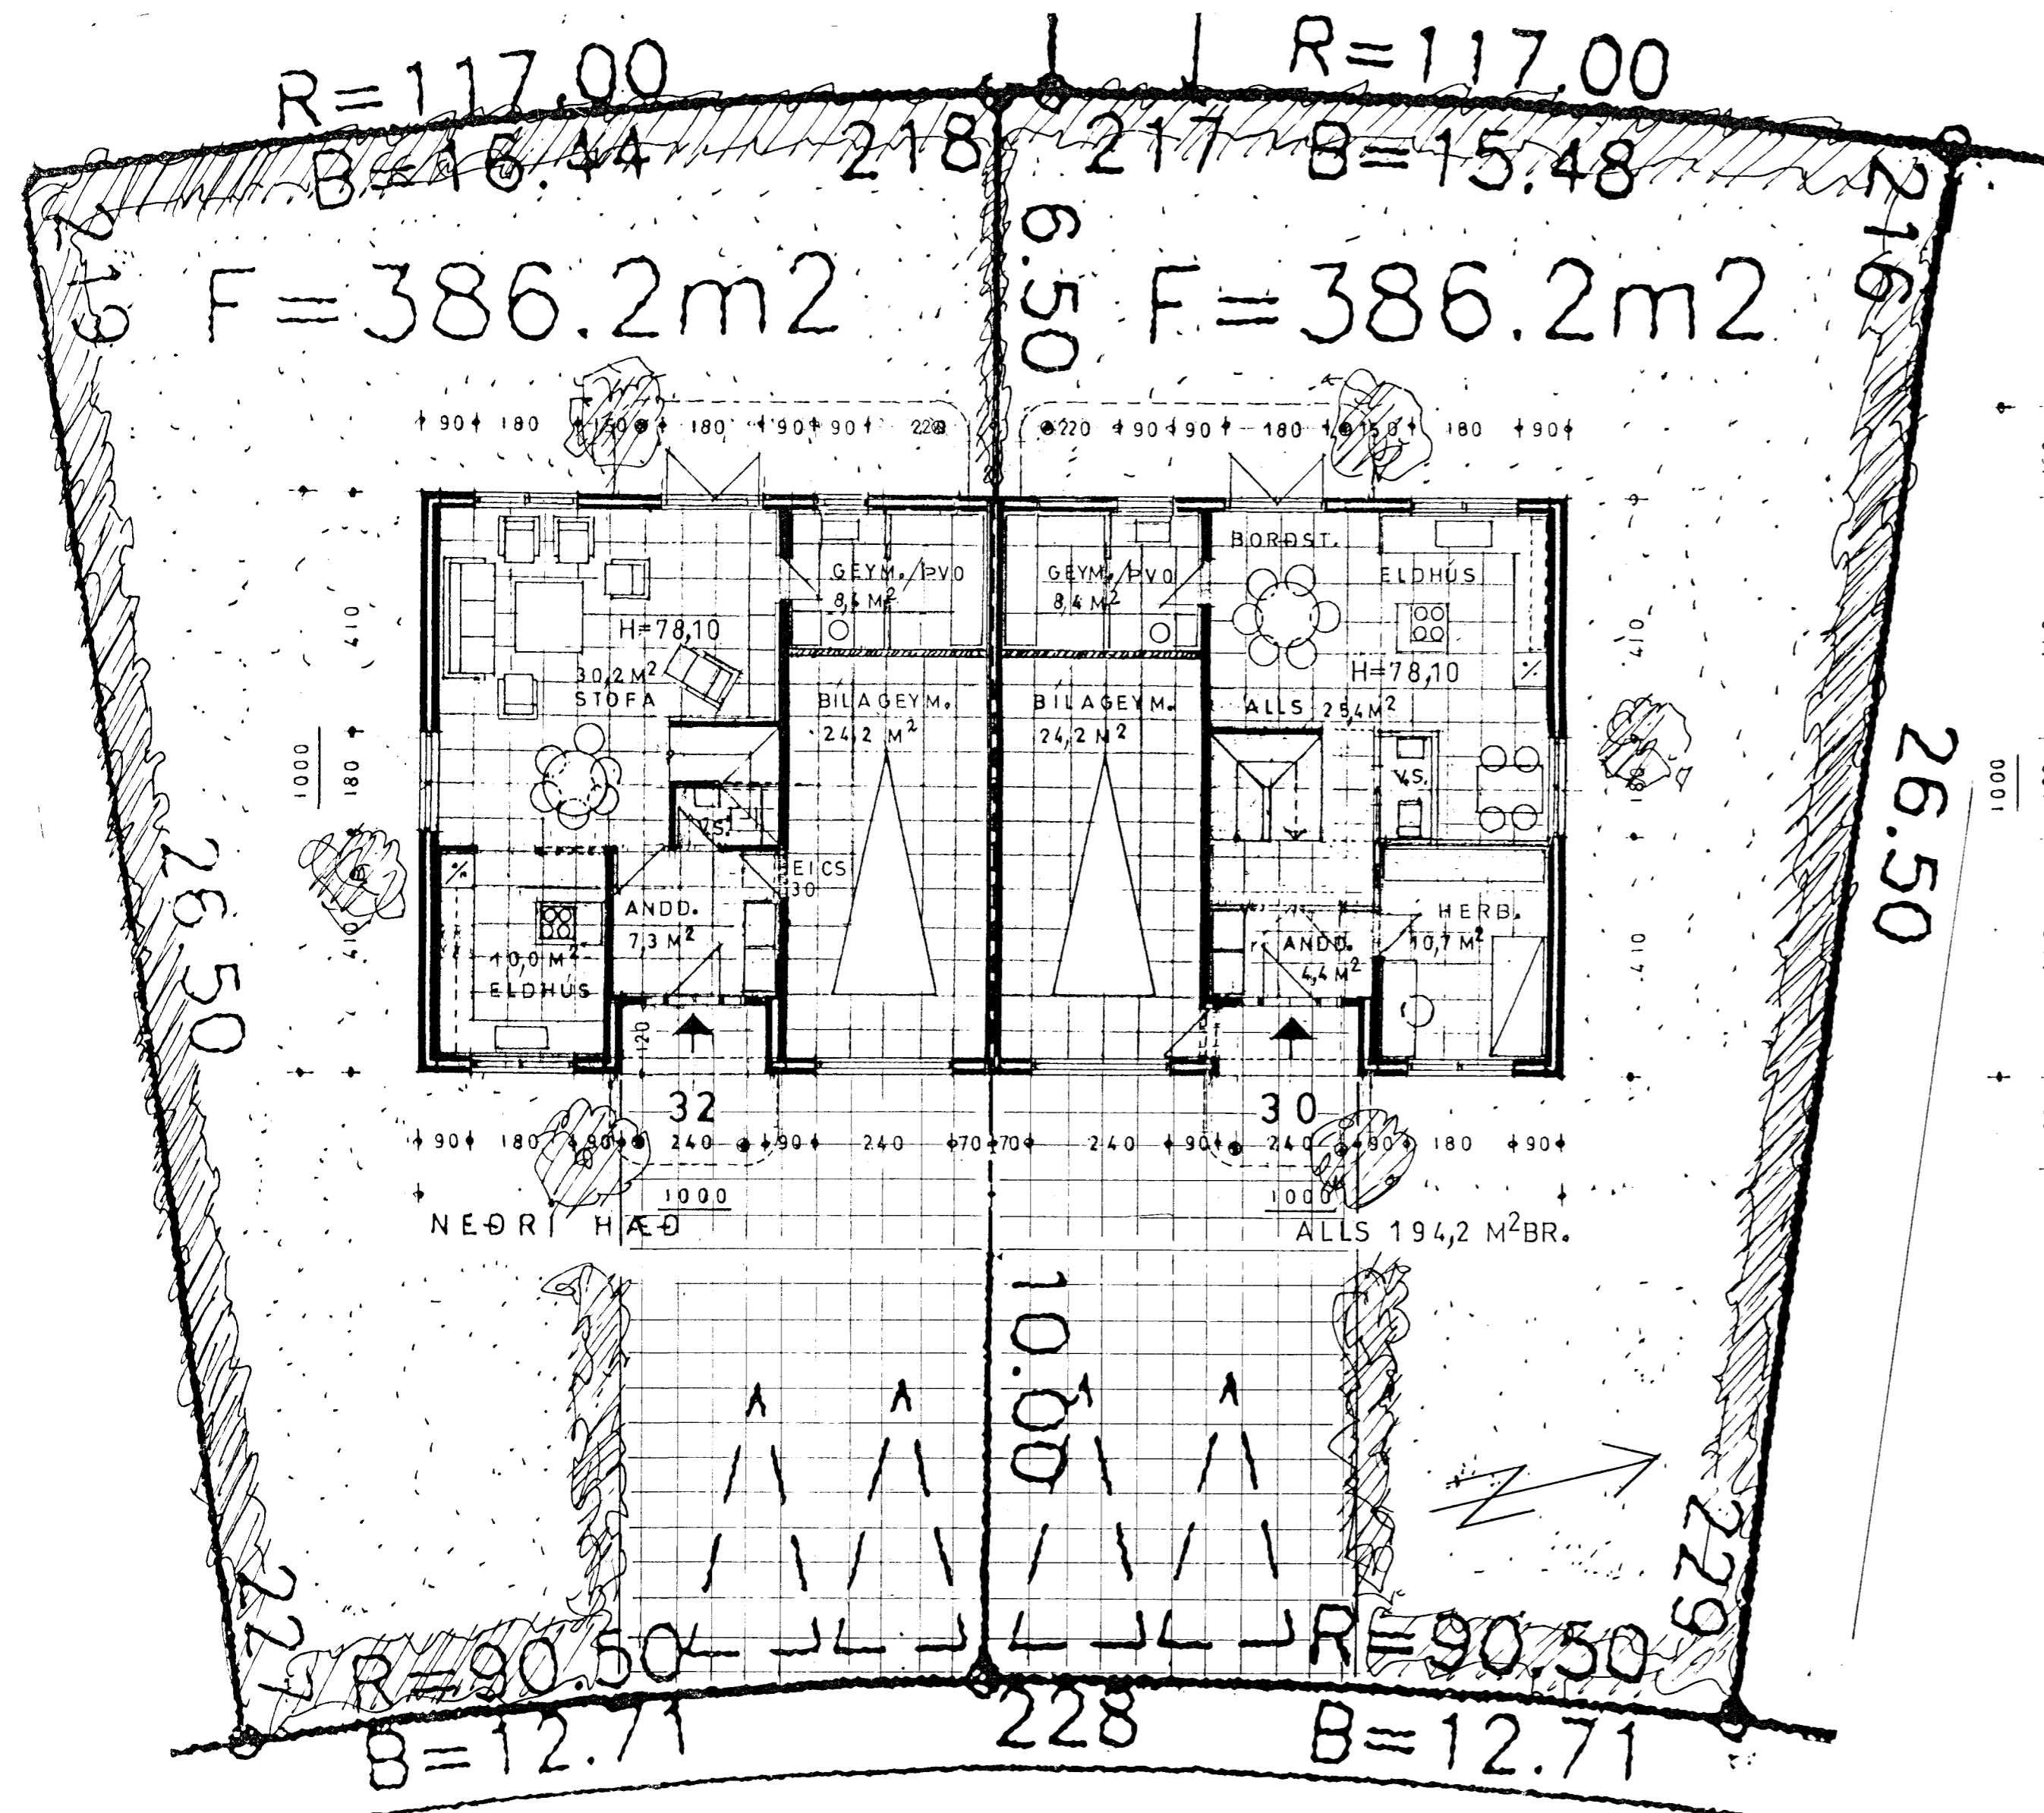

ERLUÁS 30 OG 32 HF, GRUNNMYND, M.1:100

ERLUÁS 30 OG 32 HF.
GRUNNMYNDIR, AF STAÐA, M.1:100 OG 1:500
VÍNNUSTOFAN HREFNUGÖTU 8, 105 R.
SVERRIR NORÐFJÖRÐ ARKÍTEKT F.A.Í.
KT.170641 7799, S.5527320, APRÍL 2001
Sverrir Norðfjörð
Sverrir Norðfjörð