

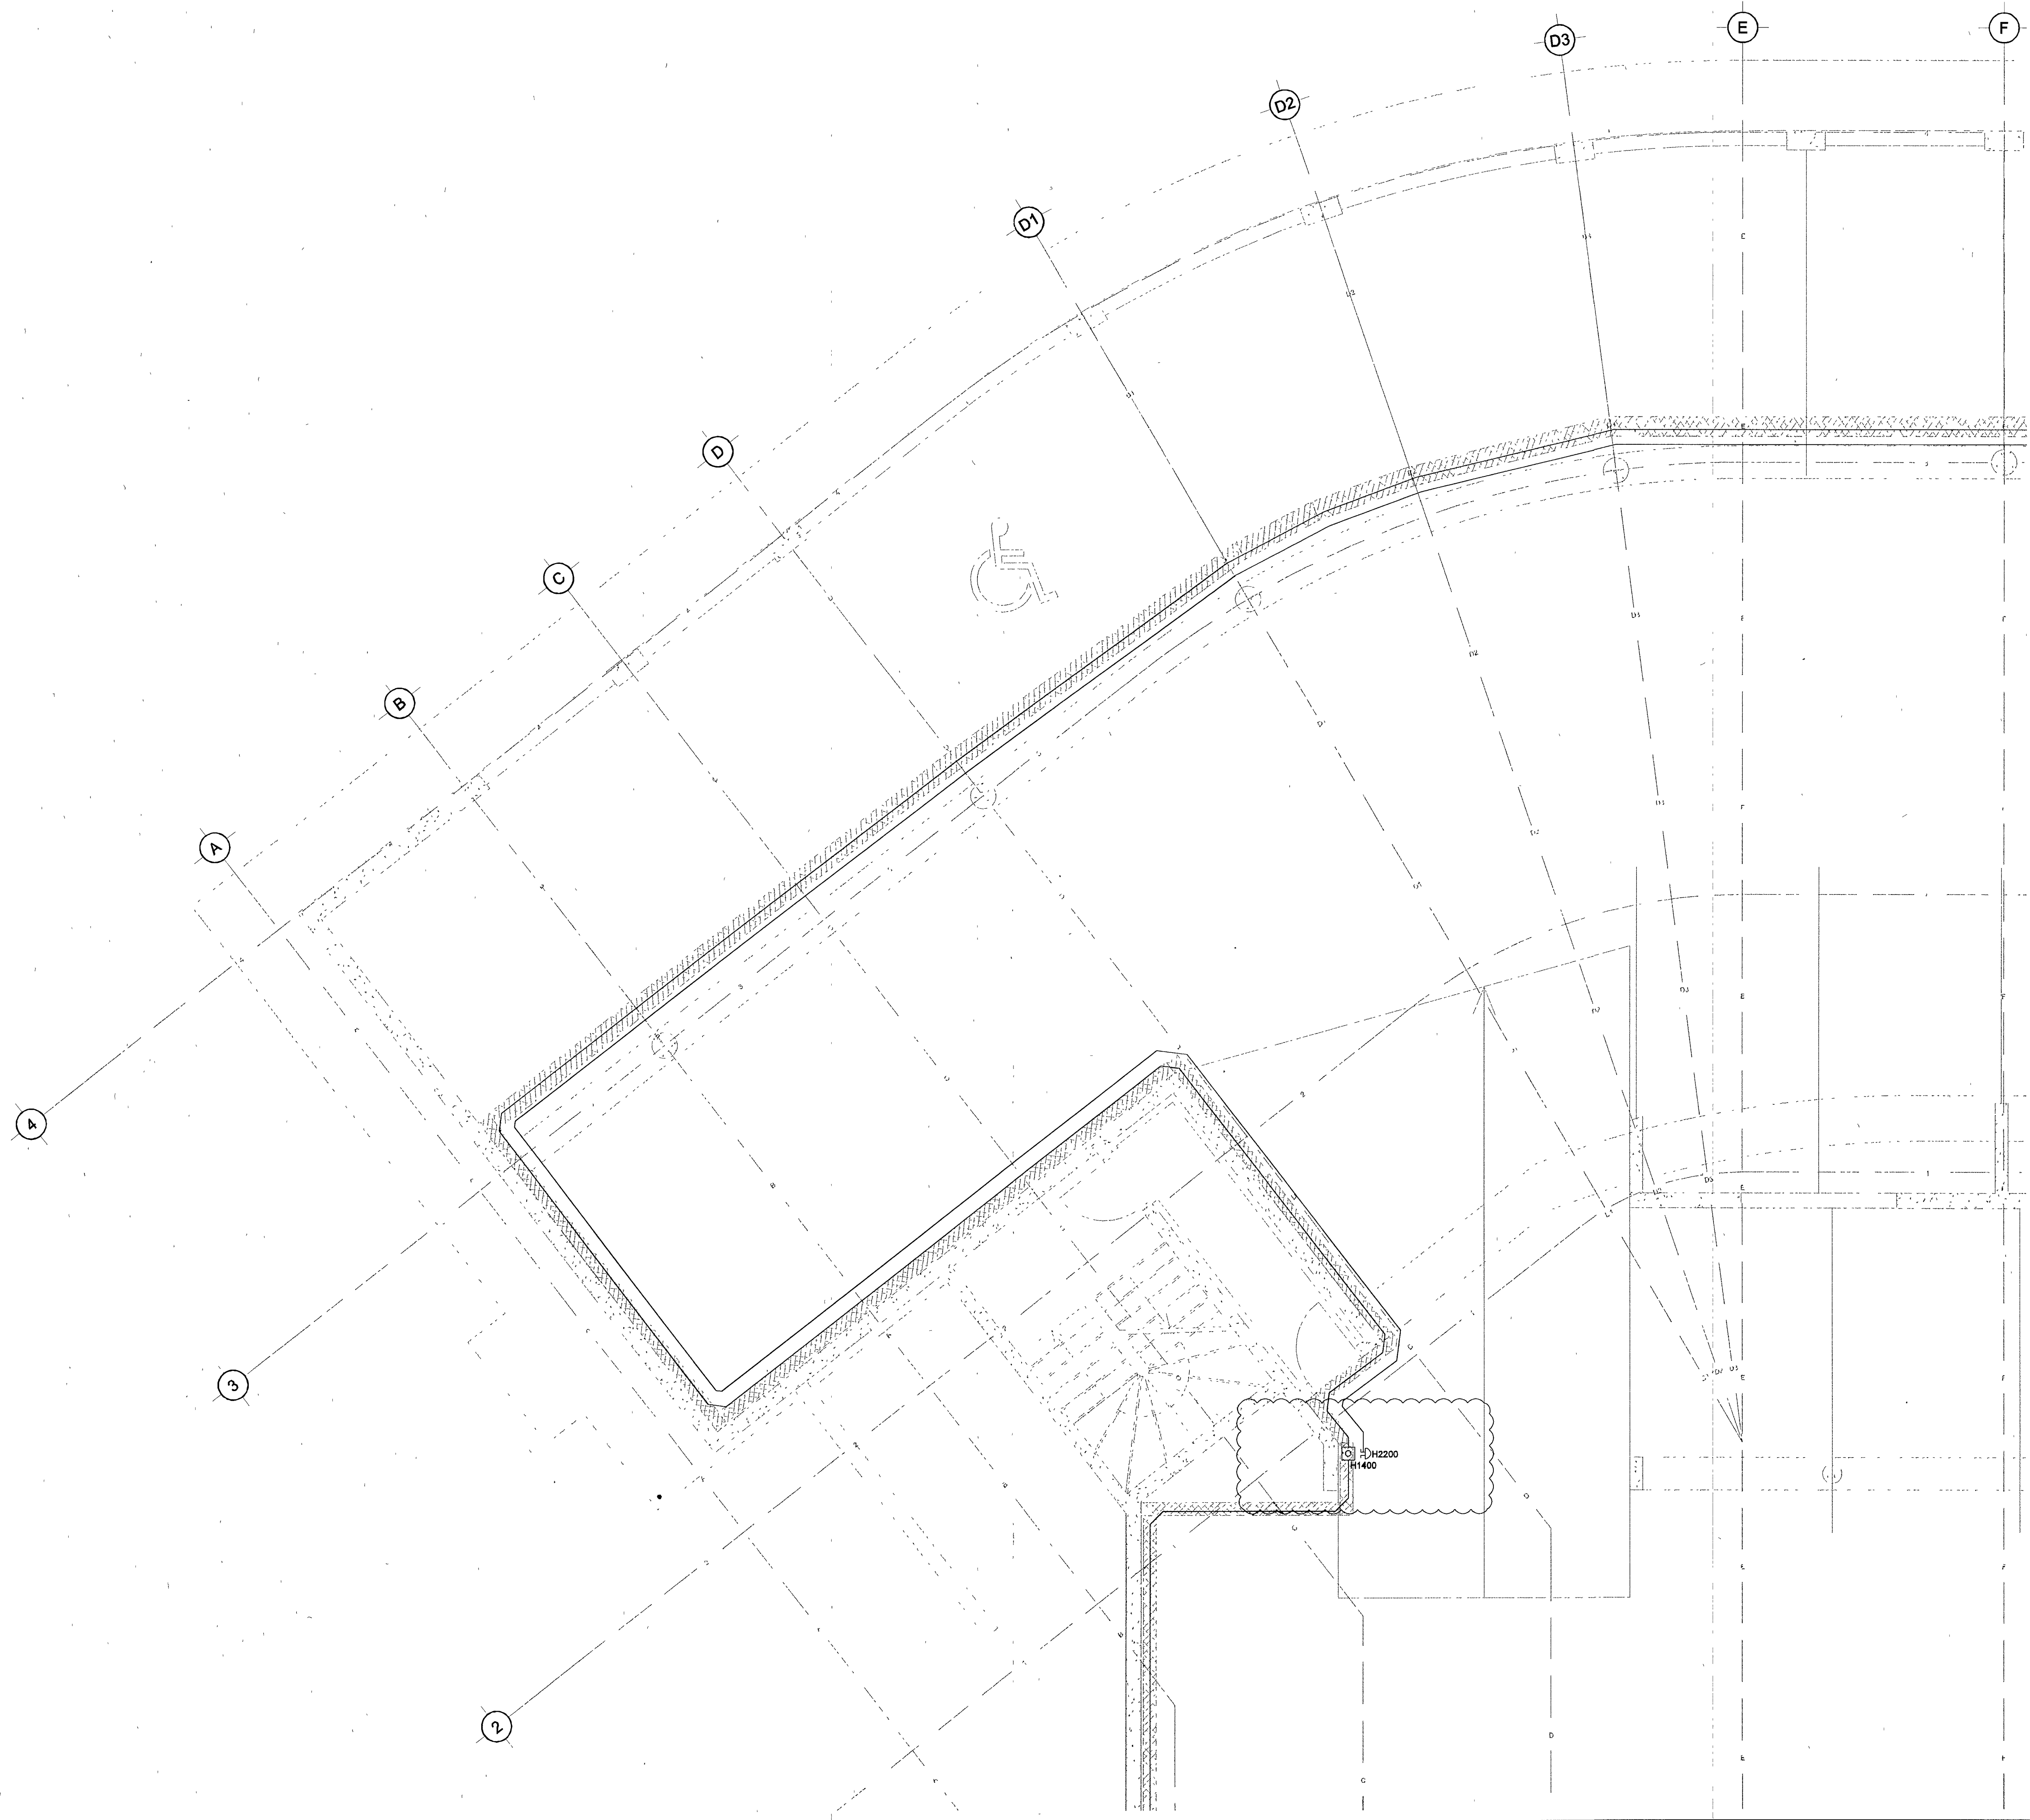


Byggingafultrúi Hafnarfjarðar
Móttækistö þann
0 4 OCT 2013

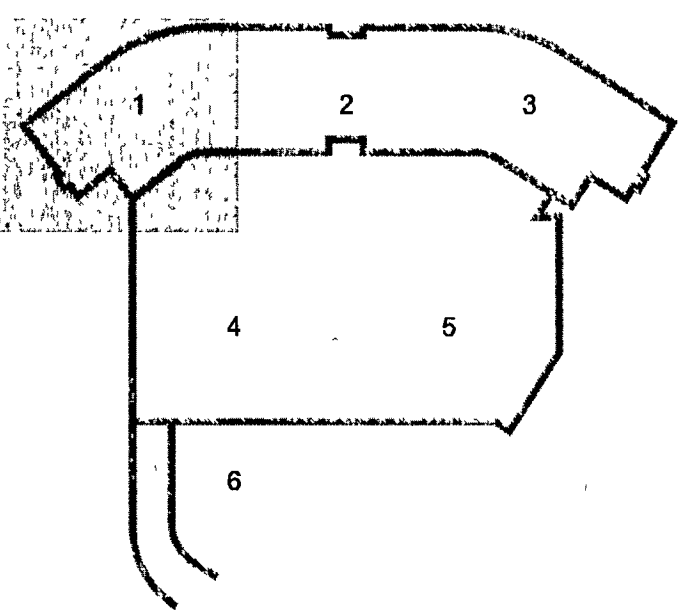

UTÍ
ARKITEKTAR
Jón Póri Þorvaldsson Afl. 122
Kt. 021256 7579

DALSHRAUN 3

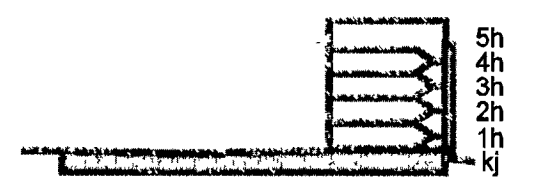

B 03.09.13 Býllur BSG/ÓG
A 12.08.13 Ýmsar breytingar JARUAR
Ug Dags Skýring Harnaðýfirland

VSB

VERKFRÆÐISTOFA

BÆJARHRAUN 20 • 220 HAFNARFJORÐUR • KENNIT 710796-2899
vab@vab.is • Sími 585 8600 • Fax 585 8610 • www.vab.is

Ártun séðhönnuðar
Órn Guðmundsson
Kt. 220961 2739 • orn@vab.is

Verkefni
DALSHRAUN 3
HAFNARFIRÐI

Verkið
Rafkerfi
Brunaviðvörnarkerfi kjallara
Grunnmynd 1

Hannad	Yfirfarið	Verkefni	Kvarði	Síða
VD	VD	BSG	1 50	/A1
Dags	14.02.2008	07244	R5-01	B

V:\2007\07244\07244-Dalshraun 3\Sheki\RA\07244-RE-Kjallara.dwg