


Inntök samþykkt 4/4 2002.
 f.h. HITAVEITU SUDURNESJA h.f.
 f.l. *Björgur Dóttir*

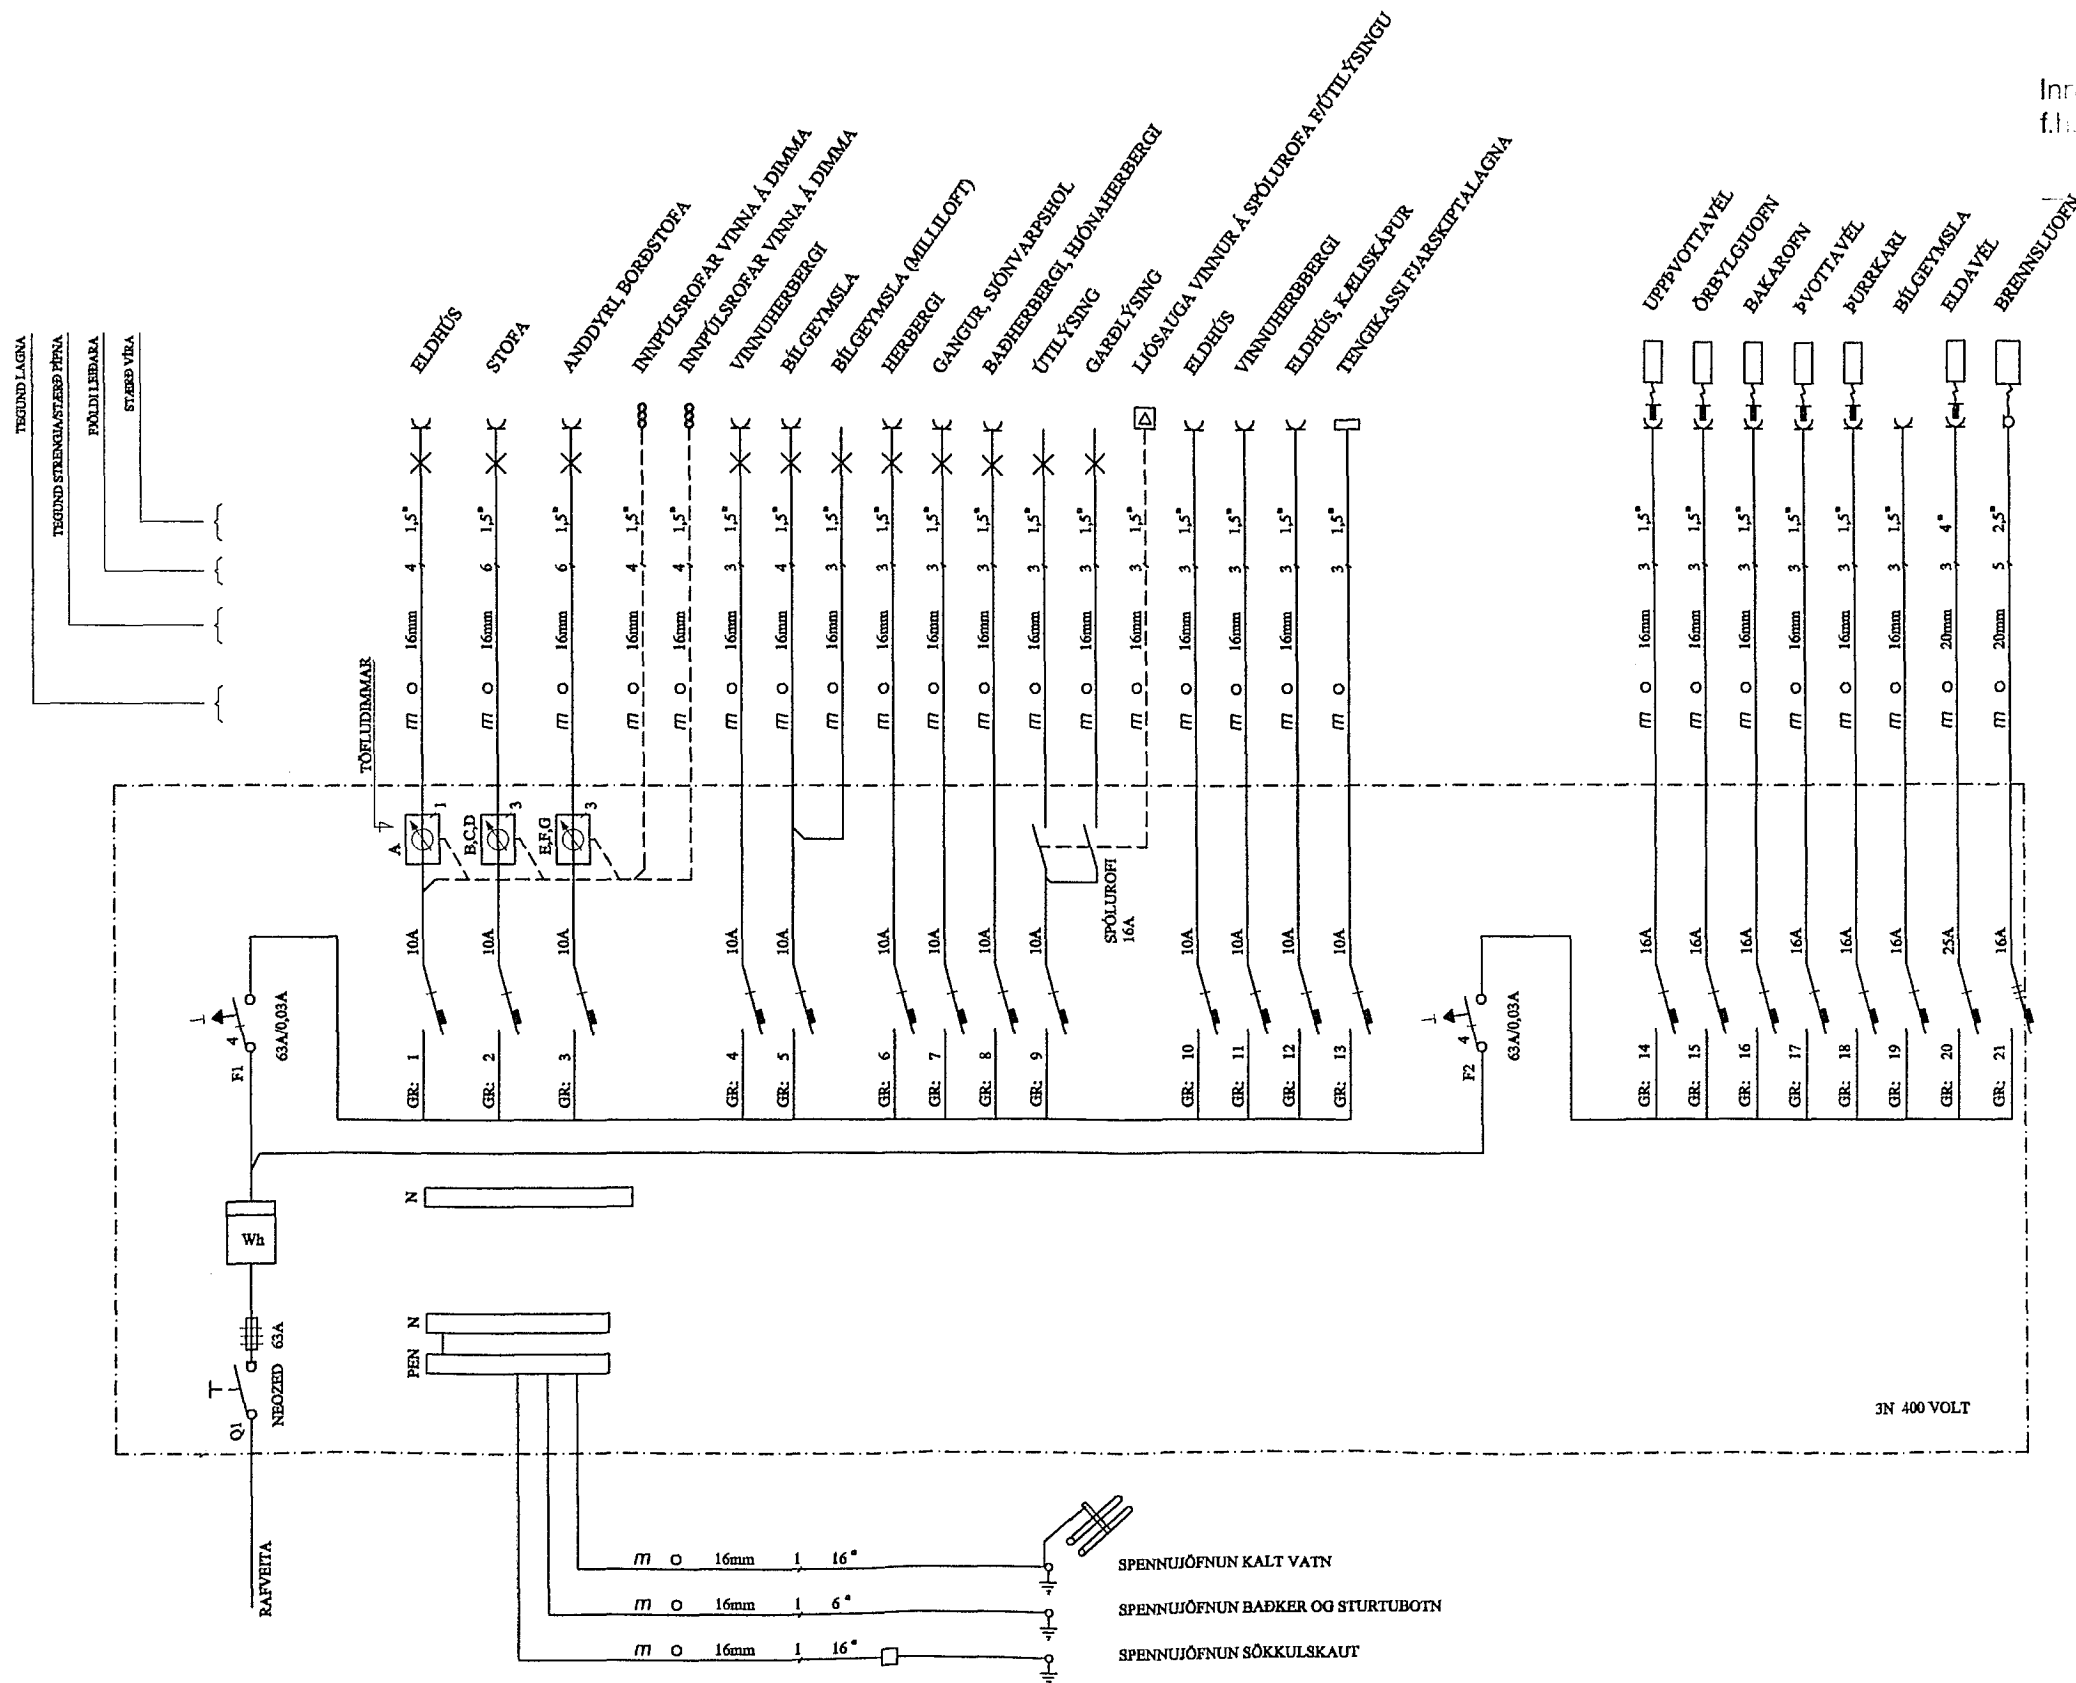

4324