


TAFLA T1
t.d. AT 50/4 + AT50
800x1050x130 + 800x300x130

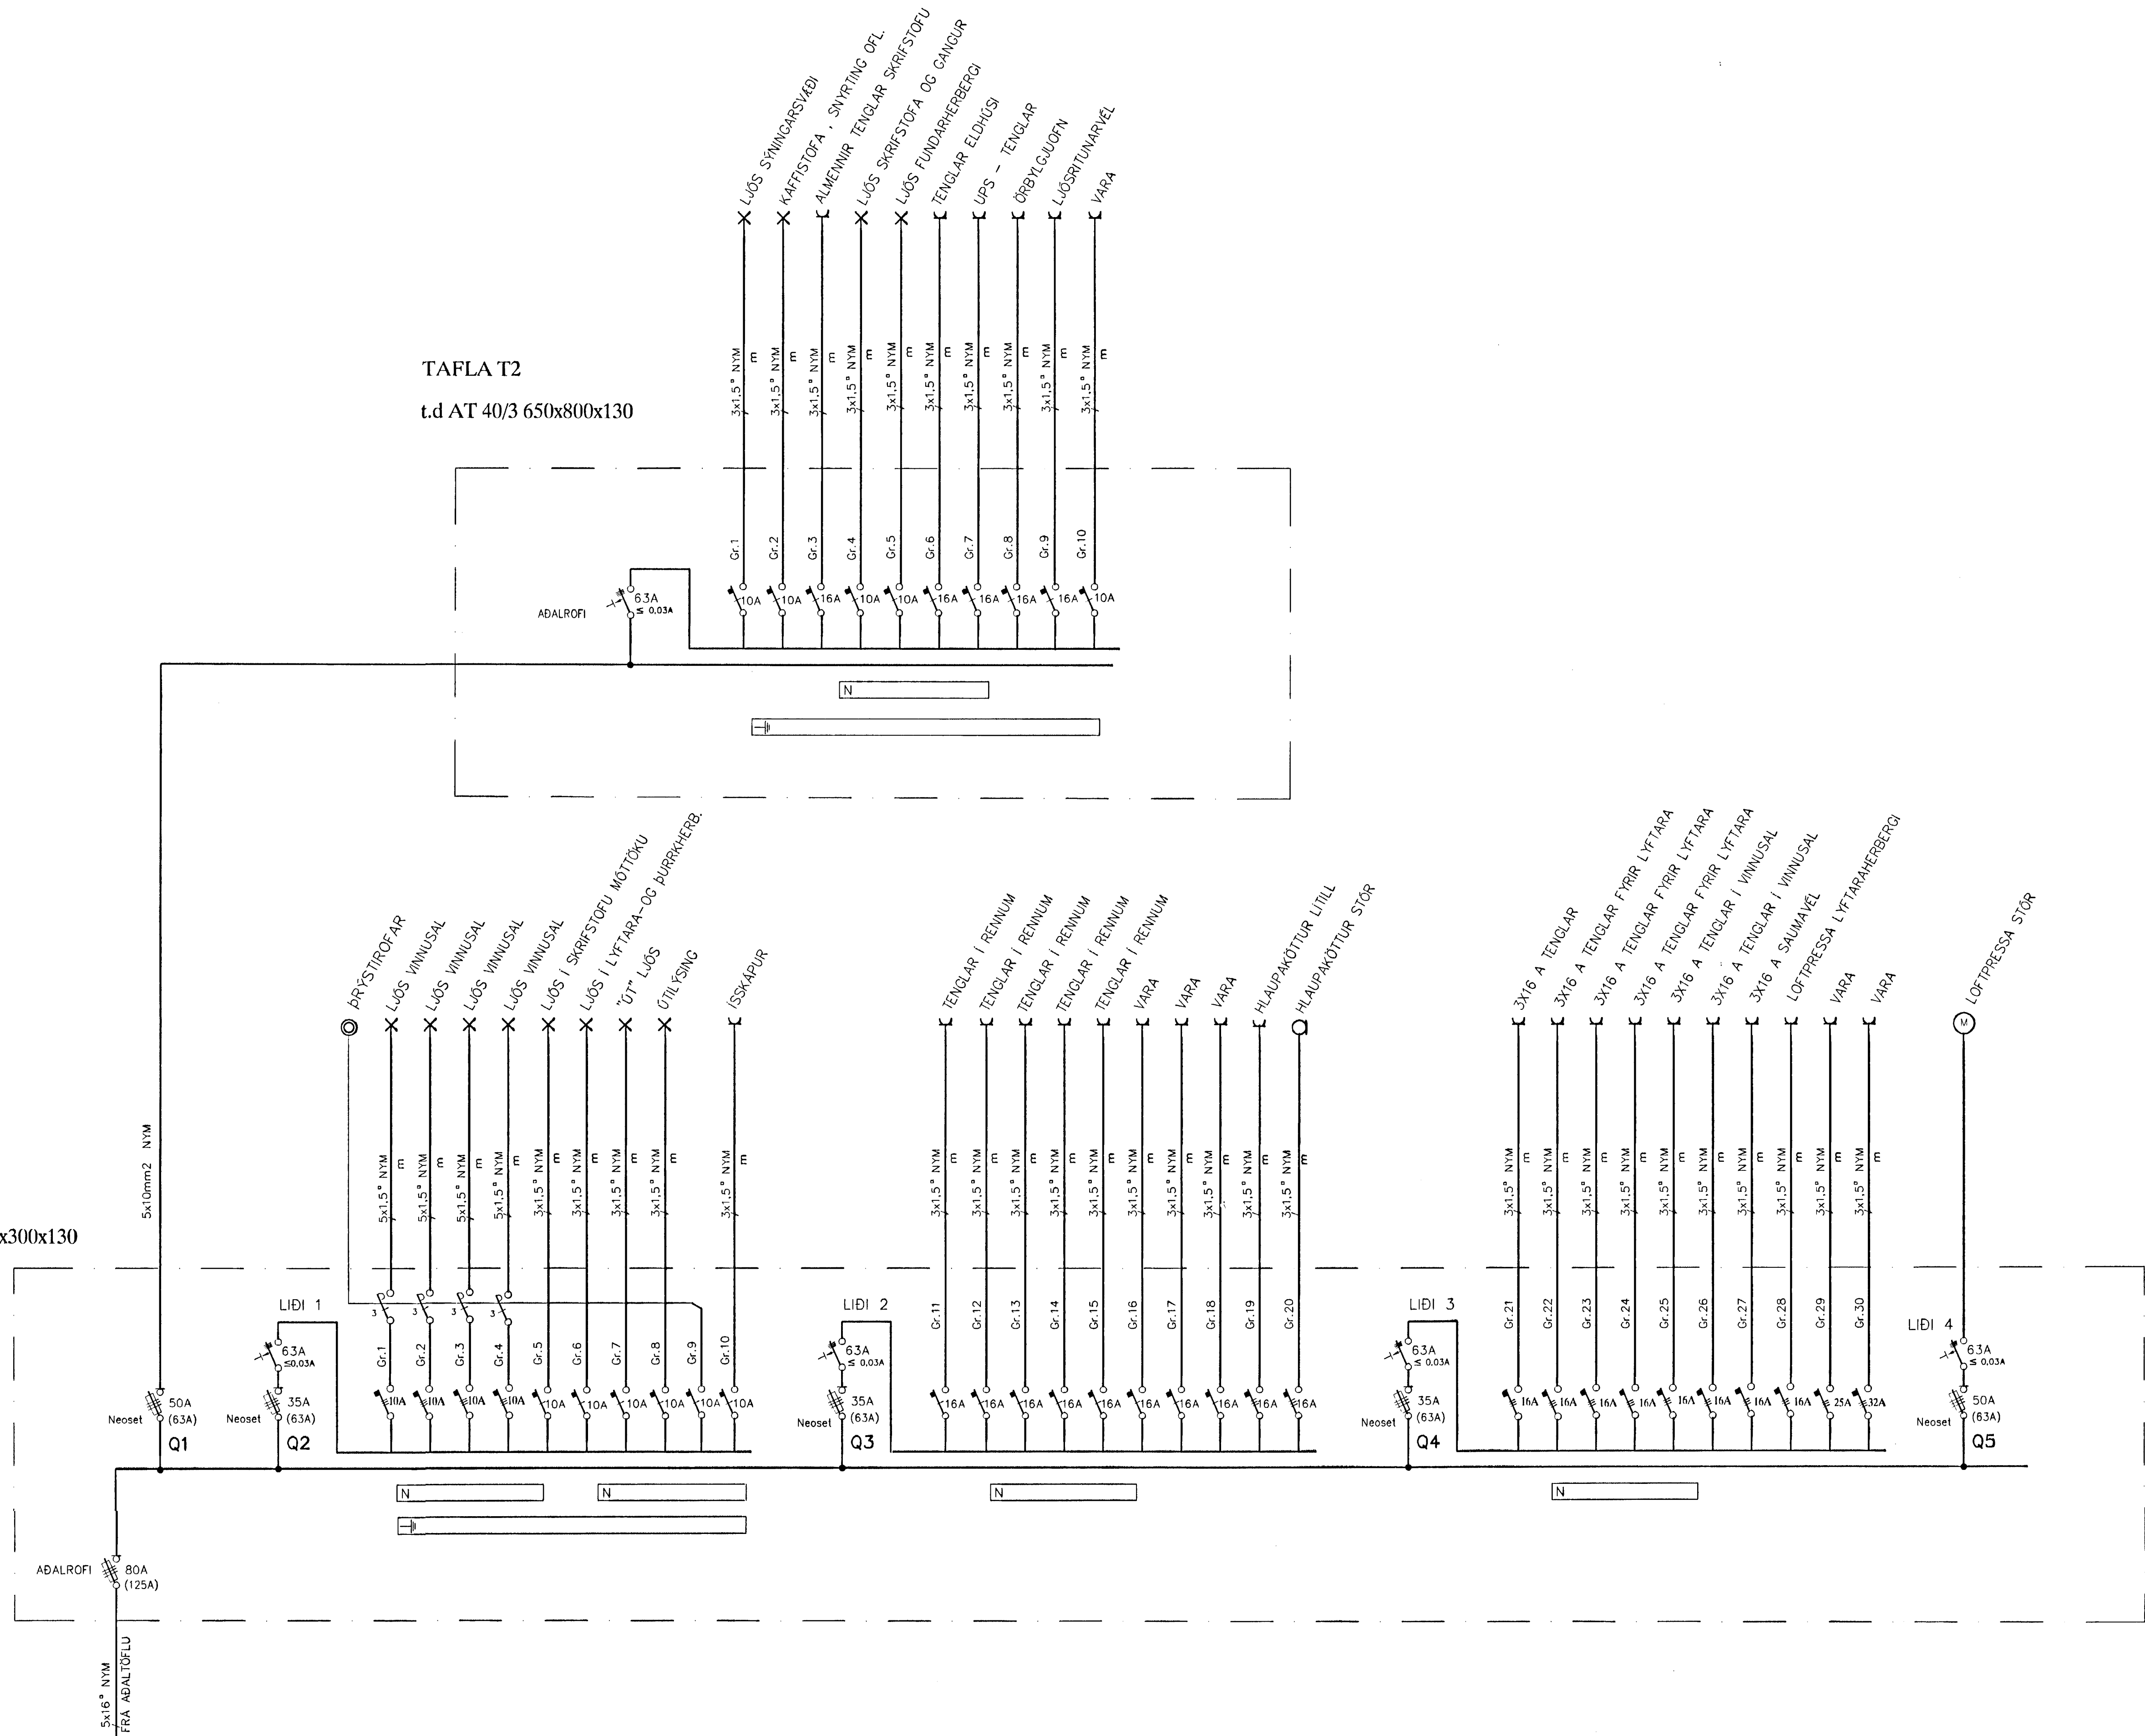

TAFLA T2
t.d. AT 40/3 650x800x130

				HVALEYRARBRAUT 27 HAFNARFIRDI				MKV - /	
				Einlinumynd af töflum T1 og T2				TEIKN NR 3	
								RESTA TNR	
B	02-07-29	REYNDARTEIKNING	S.A.	T.S.	Tranki Sveinbjörn	220140-2439	TNR 3	AT 3	UTL B
A	02-04-24	VINNUTEIKNING	S.A.	T.S.			GEYMSLUR	ERL - dag	
