
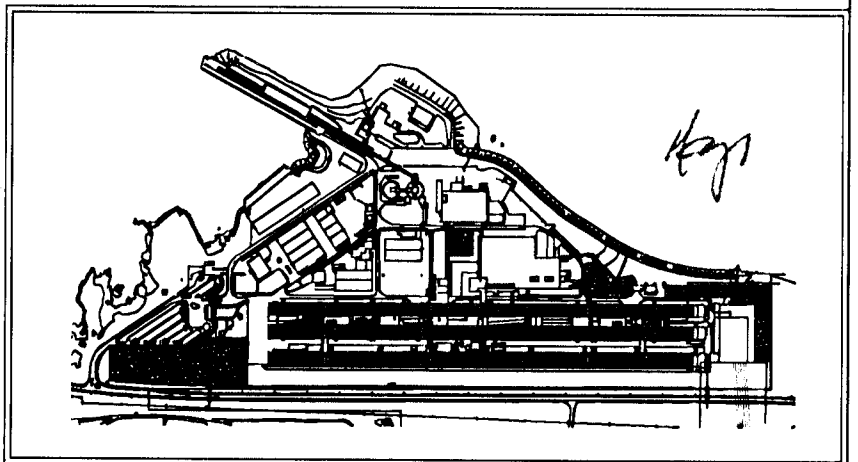


Samþykkt þann
 07 FEB 2012
 Eyvindur Guðnason / Hafnarfirði
 P.P. Fróðfur S. Gunnlaússon

Níels Indriðsson
 181144-3946 NL

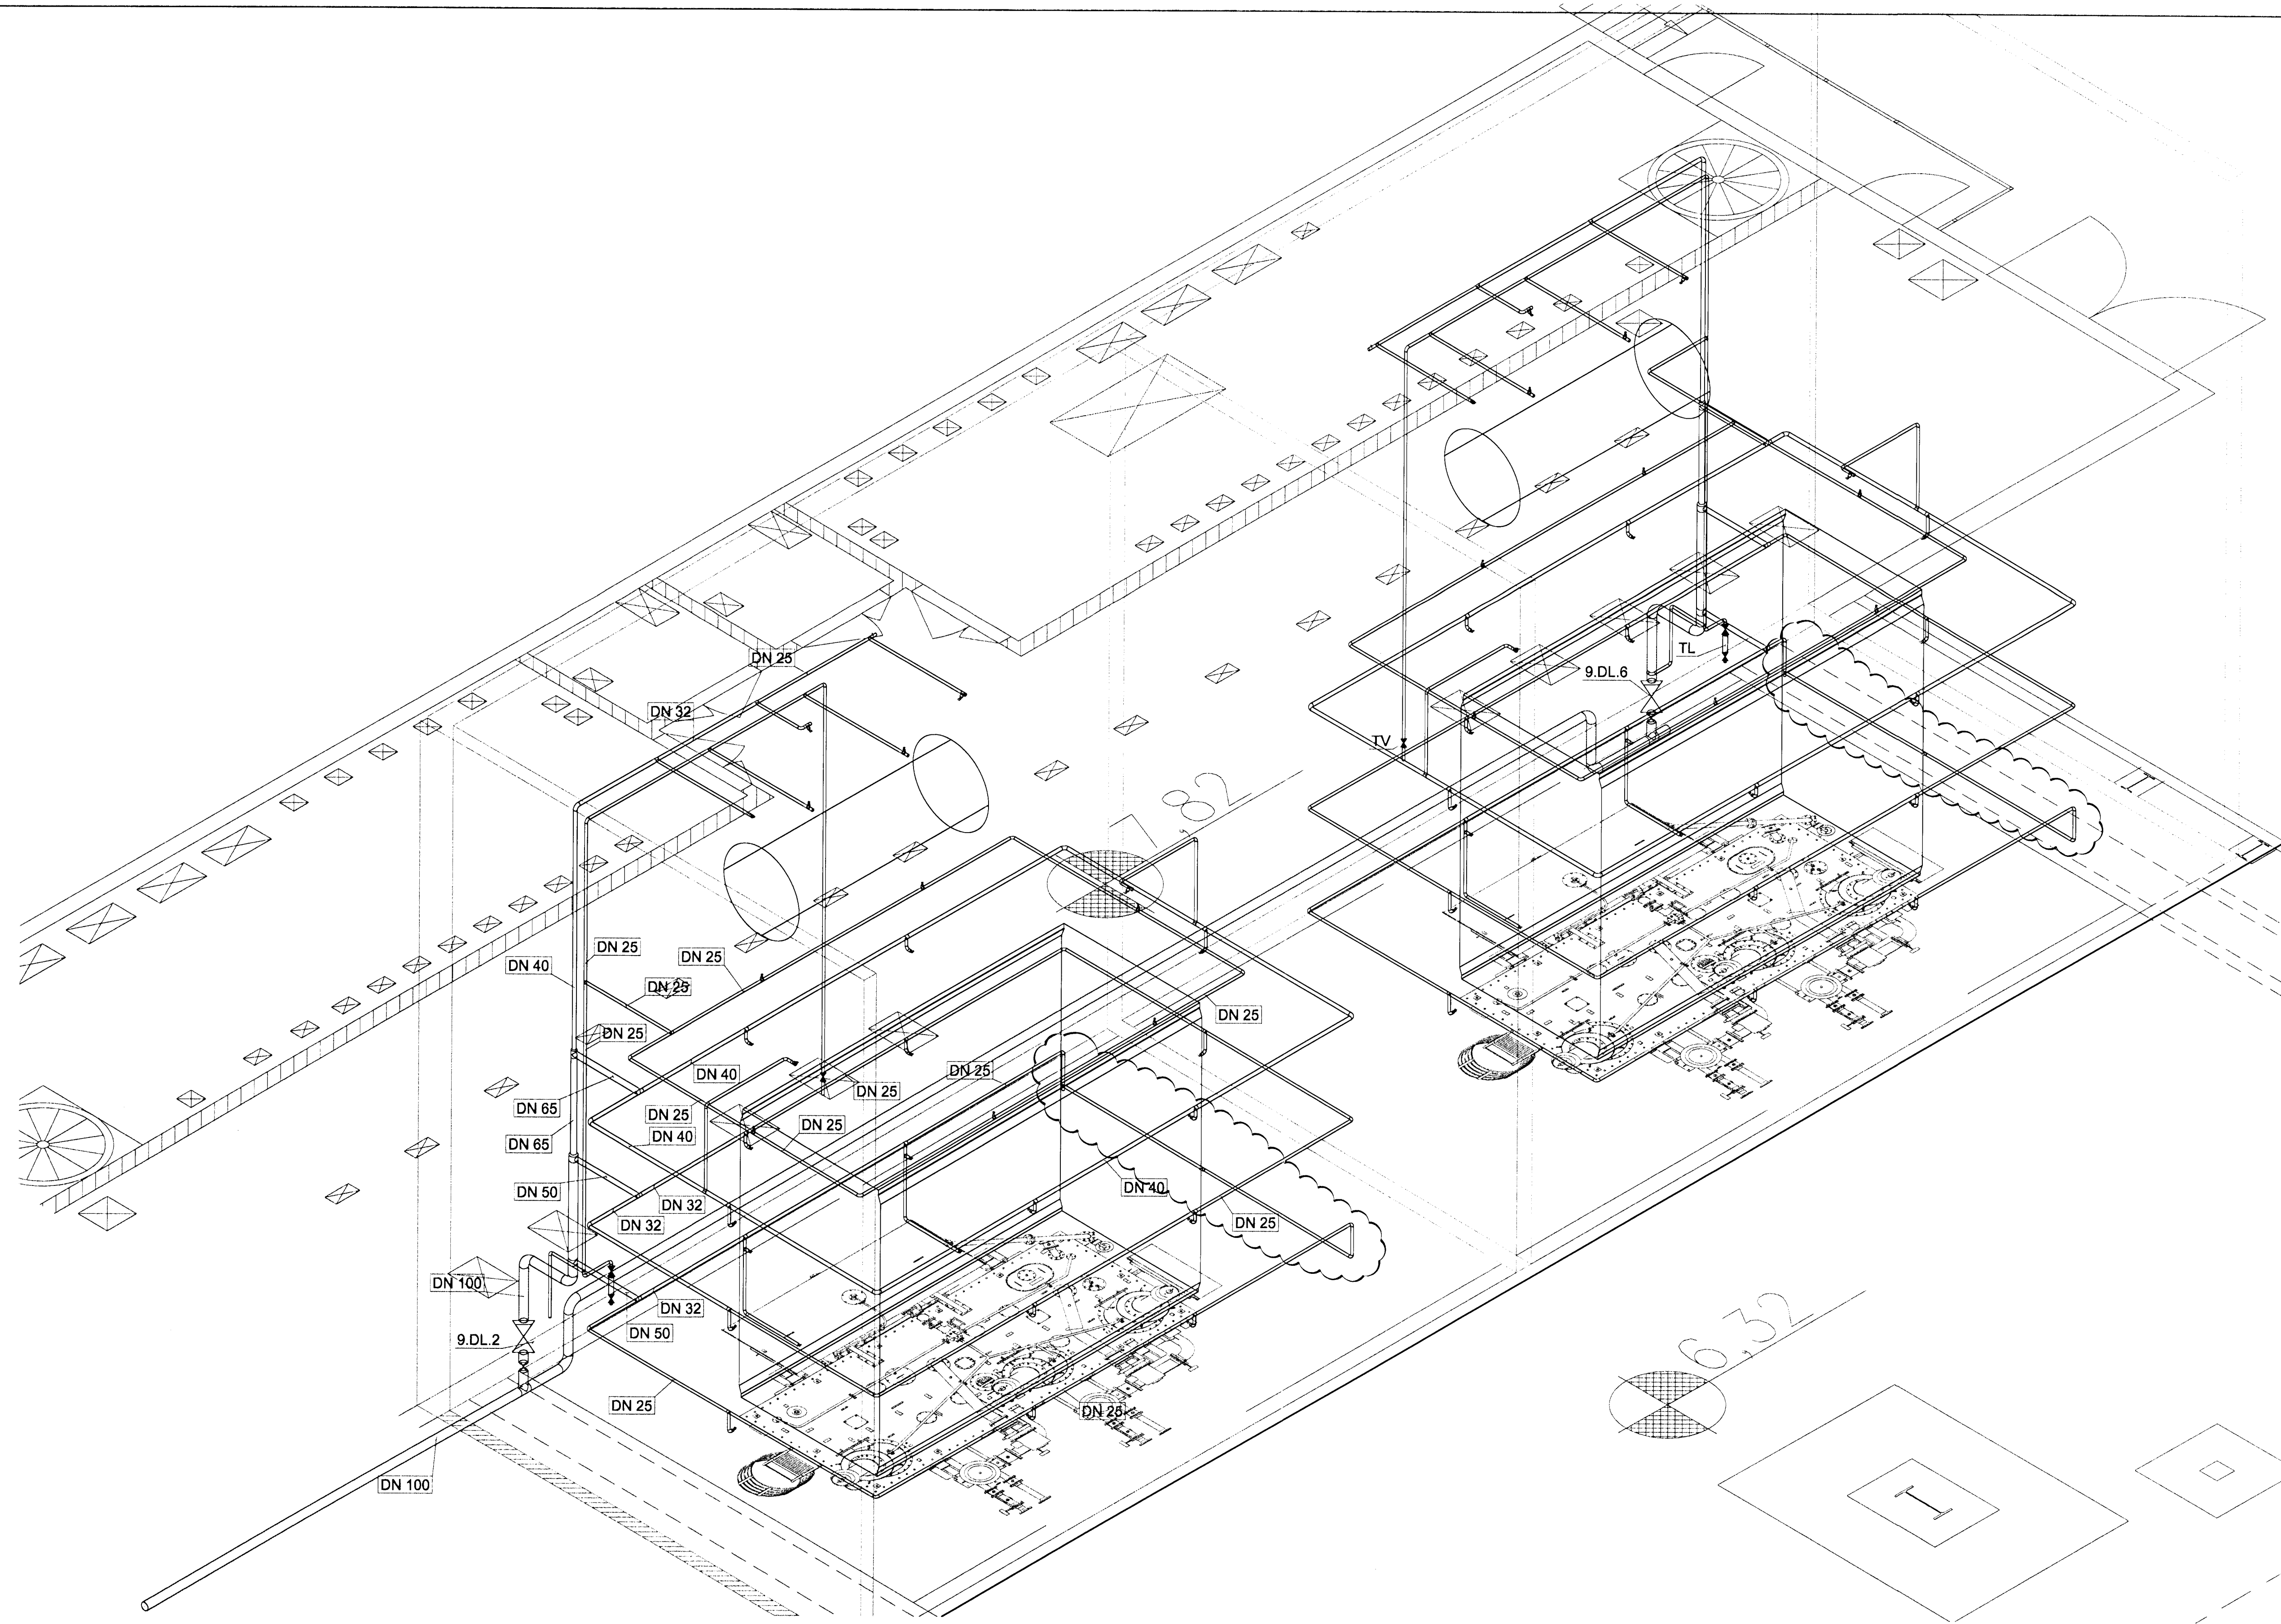

Skýringar:
 Legend:

Clg nr Rev no	Description	Dogetning Date	Har/Tni Des/Drw	Yfir Cld	Núla heim Suppl Rel	Núla heim ISAL Rel
4	PIPE MOVED DUE TO EL. CABINET	2011.12.05	PB	ÓS	ÓS	MCBW
3	ISSUED FOR CONSTRUCTION	2011.06.10	Slp	ÓS	ÓS	
2	ISSUED FOR TENDER	2011.02.28	Slp	ÓS	ÓS	
1	ISSUED FOR BLUE DESK REVIEW	2011.01.28	Slp	ÓS	ÓS	

This drawing is the property of Rio Tinto Alcan Iceland Ltd. and handed out for personal use only. It may neither be copied nor made available to others without permission of Rio Tinto Alcan Iceland Ltd. The receiver is liable for any misuse.

Starb: A1 Mkv: 1:50
 Formati: A1 Mkv: 1:50
 Dimensions without tolerances according to ISO 2768-1 medium.



Dogetning / Date
 2011.01.28
 Hannóð / Designed
 Slp
 Verktaki / Supplier
 HRV
 Tekn.nr.verktaka / Supplier drw.no.
 IDP-411-K2-092-002
 Samþykkt / Approved
 Eyvindur Guðnason
 Hluti af: / Part of:

IPU 410 - SUBSTATION
 SPRINKLER SYSTEM
 ISOMETRIC LAYOUT

TRANSFORM BAYS

RioTinto Alcan

ISAL Yfirfarið og skráð, dags / ISAL Checked, date
 ISAL Samþykkt, dags / ISAL Approved, date

Flokkur nr.: Blað nr.: Næsta bl.:
 Kostn.nr.-Cena. / Búna.-Eqno
 AKS
 ISAL Tekn.nr. ISAL /Drw.no. of ISAL. Breyt./Rev.
 Alcan Iceland Ltd. Símanúmer IS-222 Hafnarfordur Ísland
 C