

M N O P Q R S T U V W X Y Z A

9

10

11

12

13

14



15

16

17

18

19

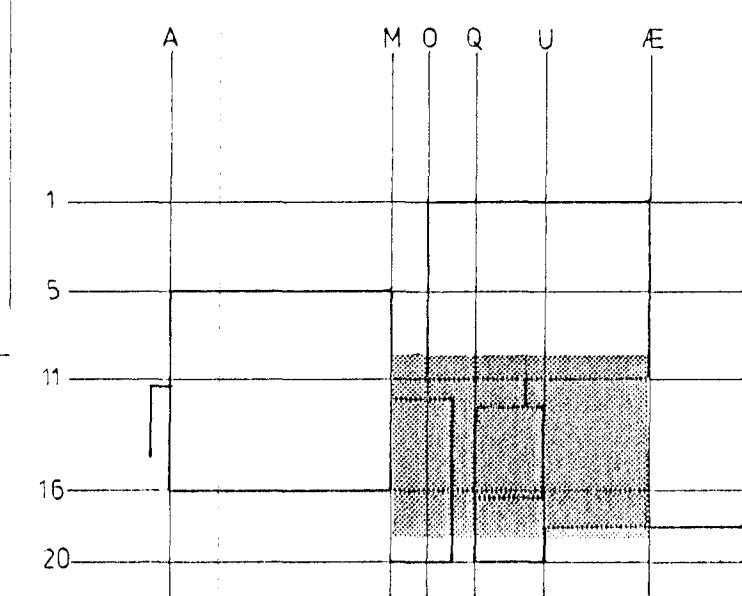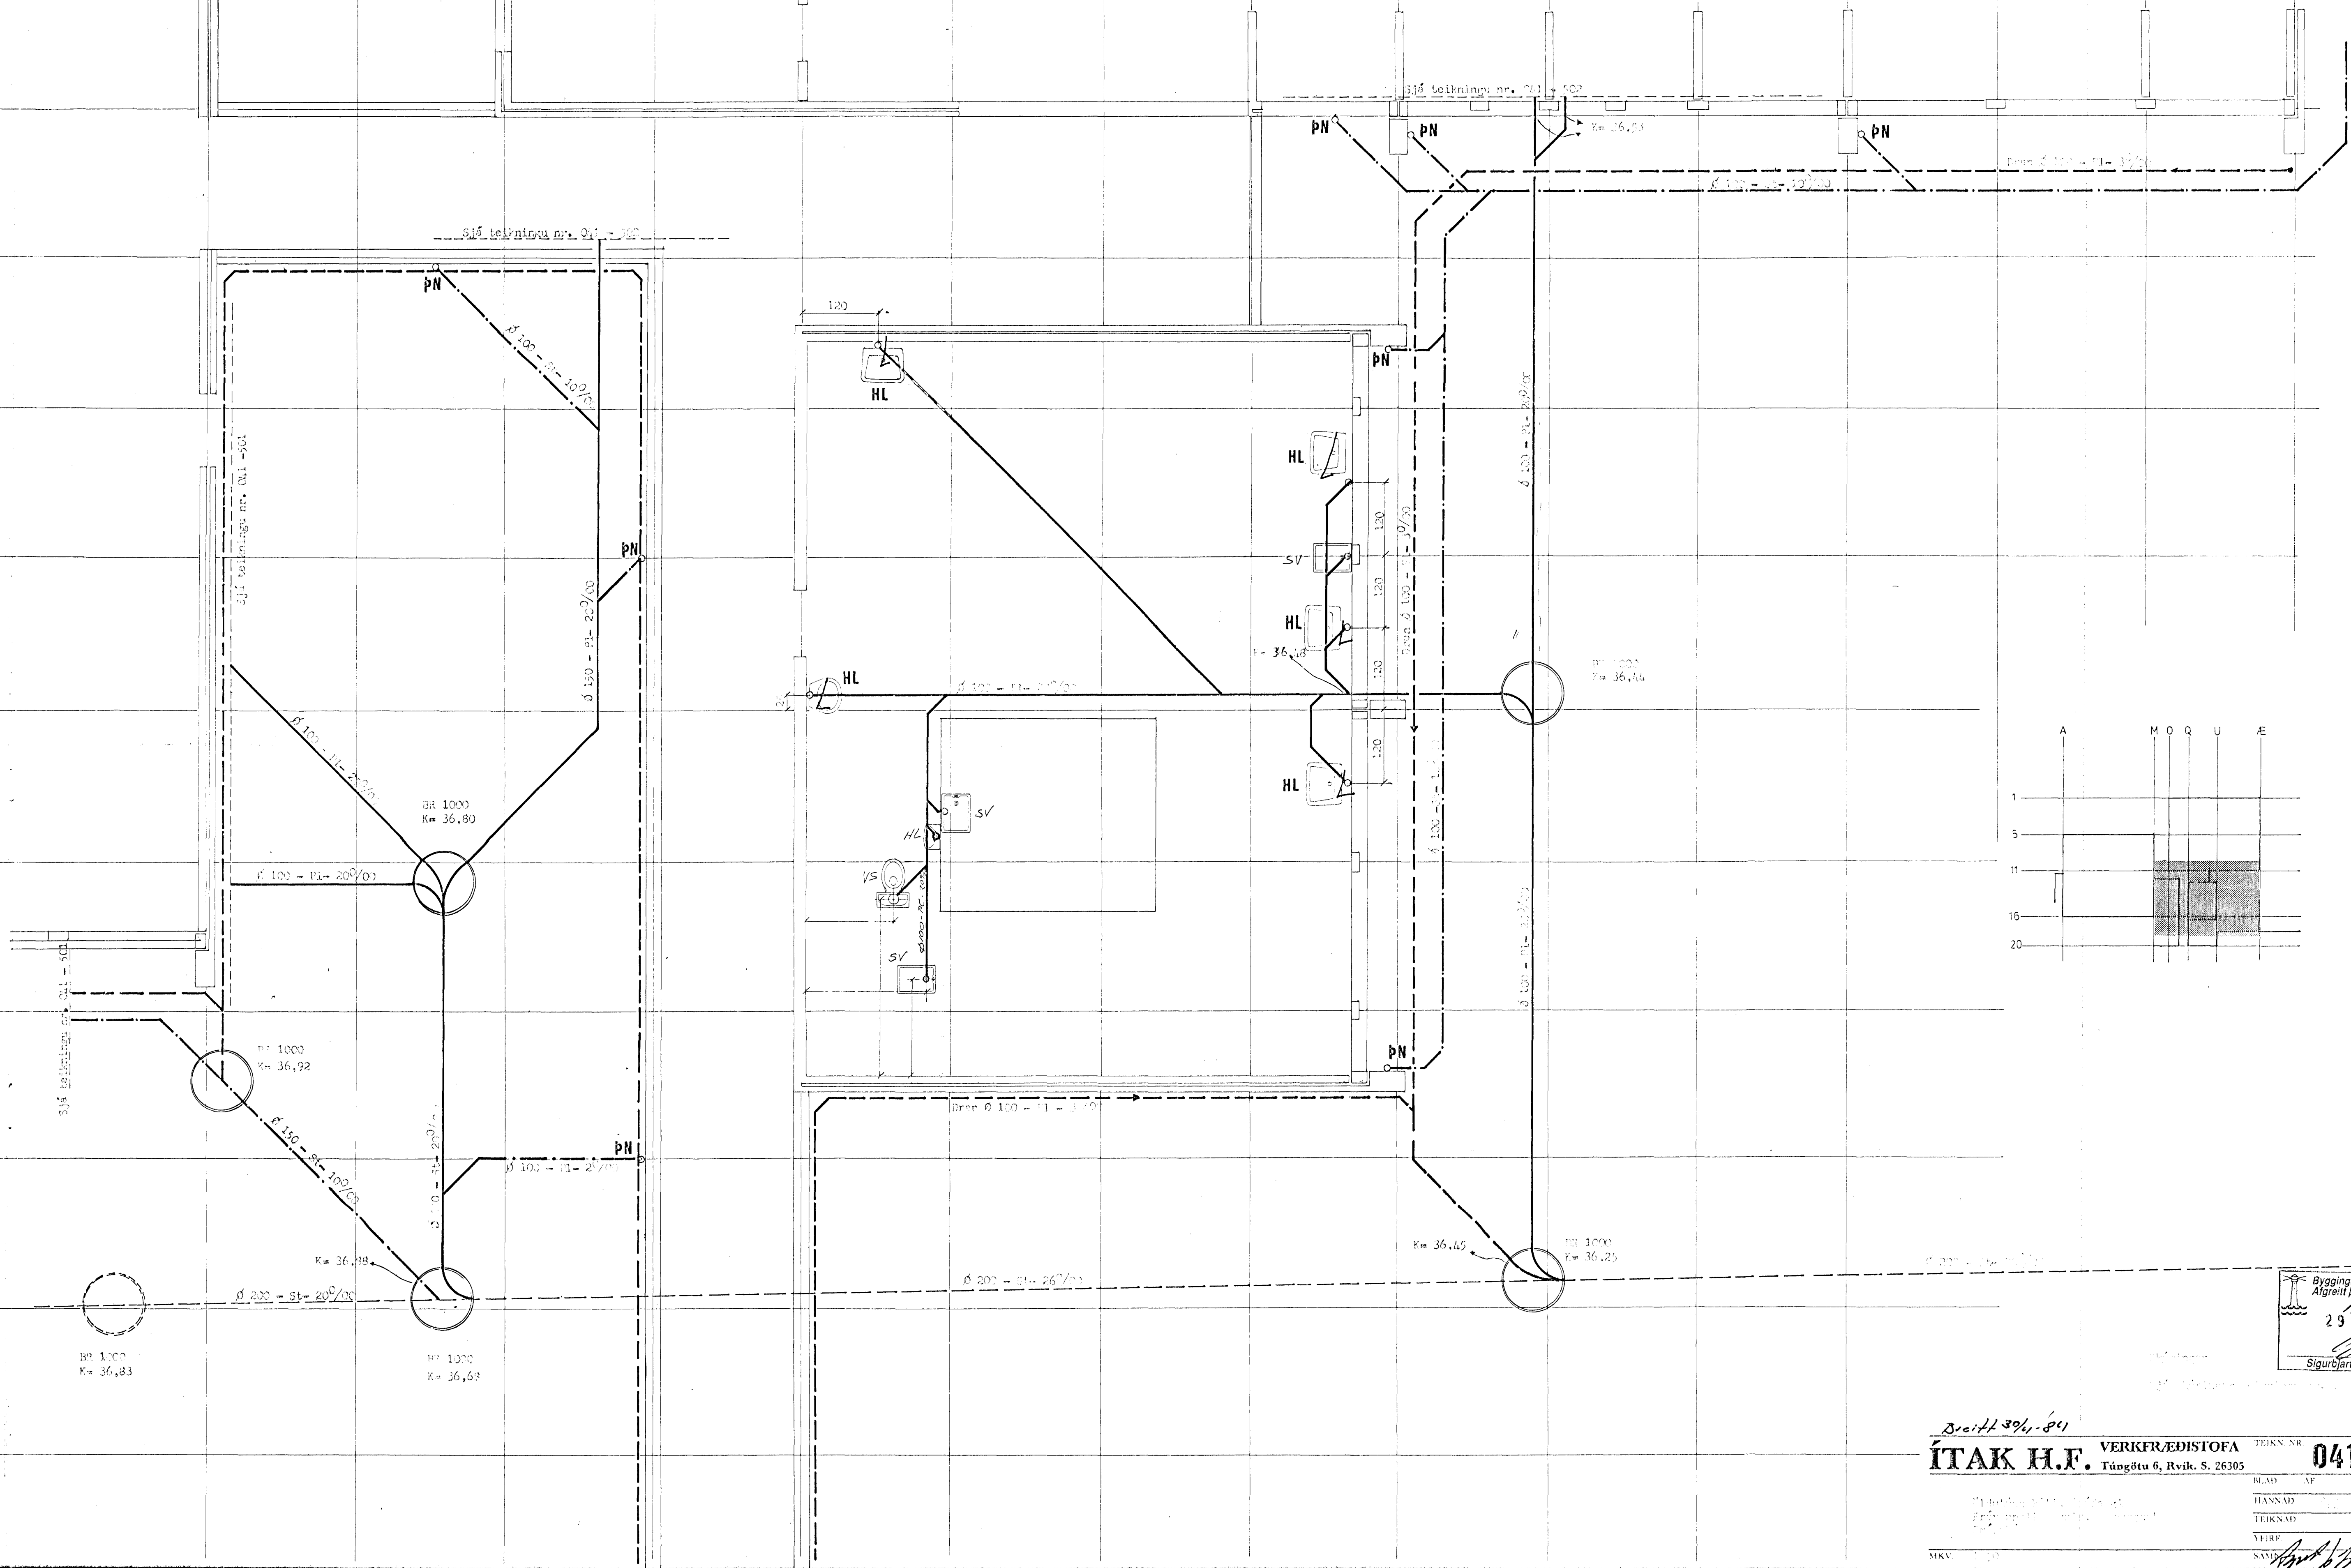

Byggingafultrúi Hafnarjardar
Algreitt þann
29 SEPT. 1997
Sigurbjartur Halldórsson

Breitl. 39/4-84
ÍTAK H.F. VERKFRÆDISTOFA TEIKN. NR. **041-503**
Túngötu 6, Rvík, S. 26305
BLAÐ AF
HANSAD
TEIKNAD
VEIÐ
SAND