


1 hæð 1:100

Samþykkt þann
08 JUN 2011
 Byggingarástafa
 F.h. Sigurður Steinsson

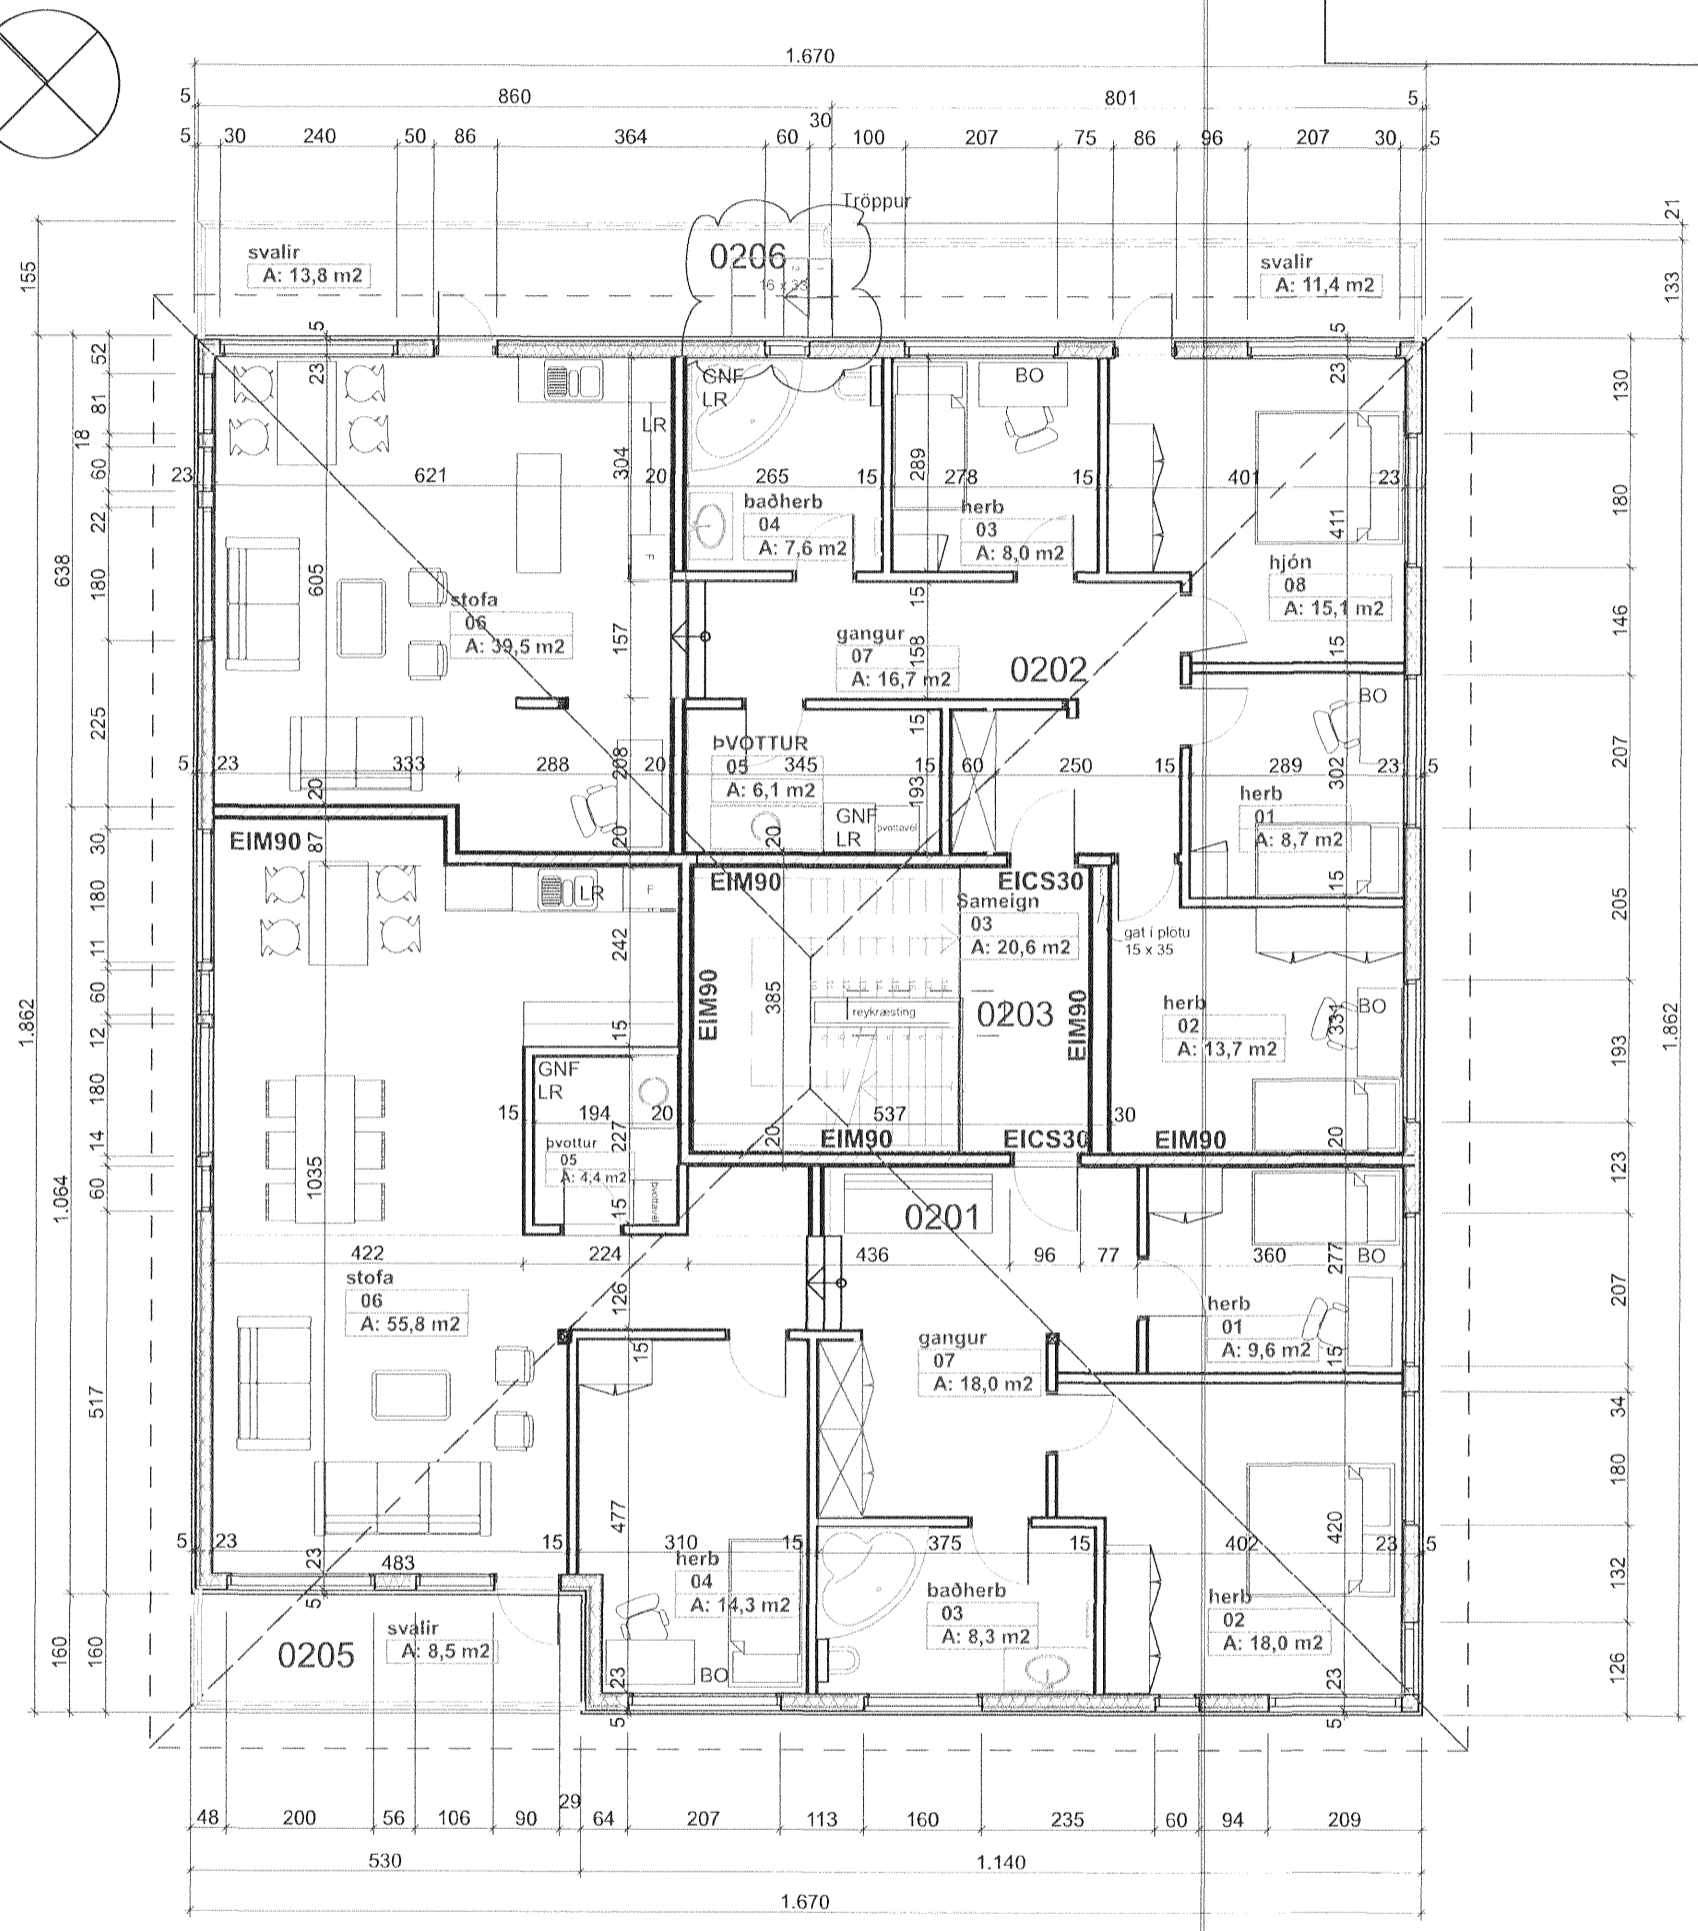

+ARKITEKTAR
 Álfaskeið 31
 reyndarteikning
 Grunnmynd 1.og 2. hæð

breyting, 31.05.2011
 Tröppur á svölum 2. hæð

dags. 19.09.08
 mkv. 1:100
 teikn. hi
 verknr. 0607

Haraldur Ingvarsson arkitekt 030956-3389
 Páll Hjaltason arkitekt 070859-2119
 Þormóður Sveinsson arkitekt 050653-5529

Laugavegur 59 101 Reykjavík 562-5959 www.plusark.is

A04