




490 3450 850
ÚTLIT AUSTUR
MKV 1:100

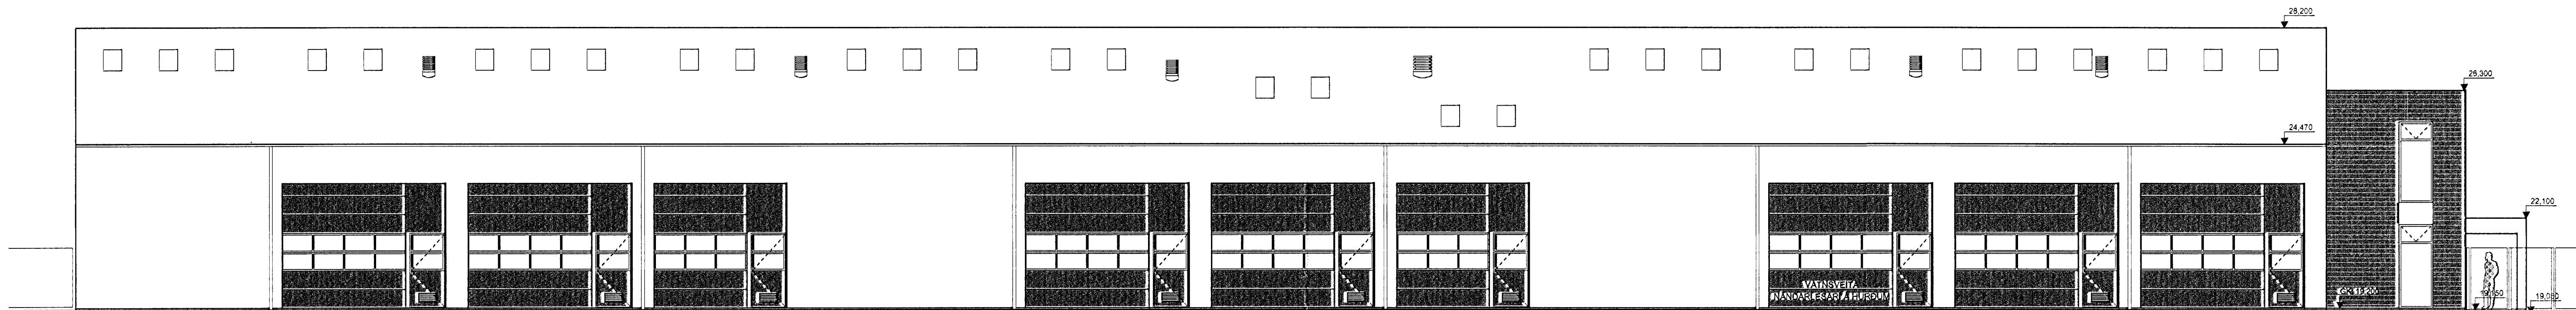

ÚTLIT VESTUR
MKV 1:100

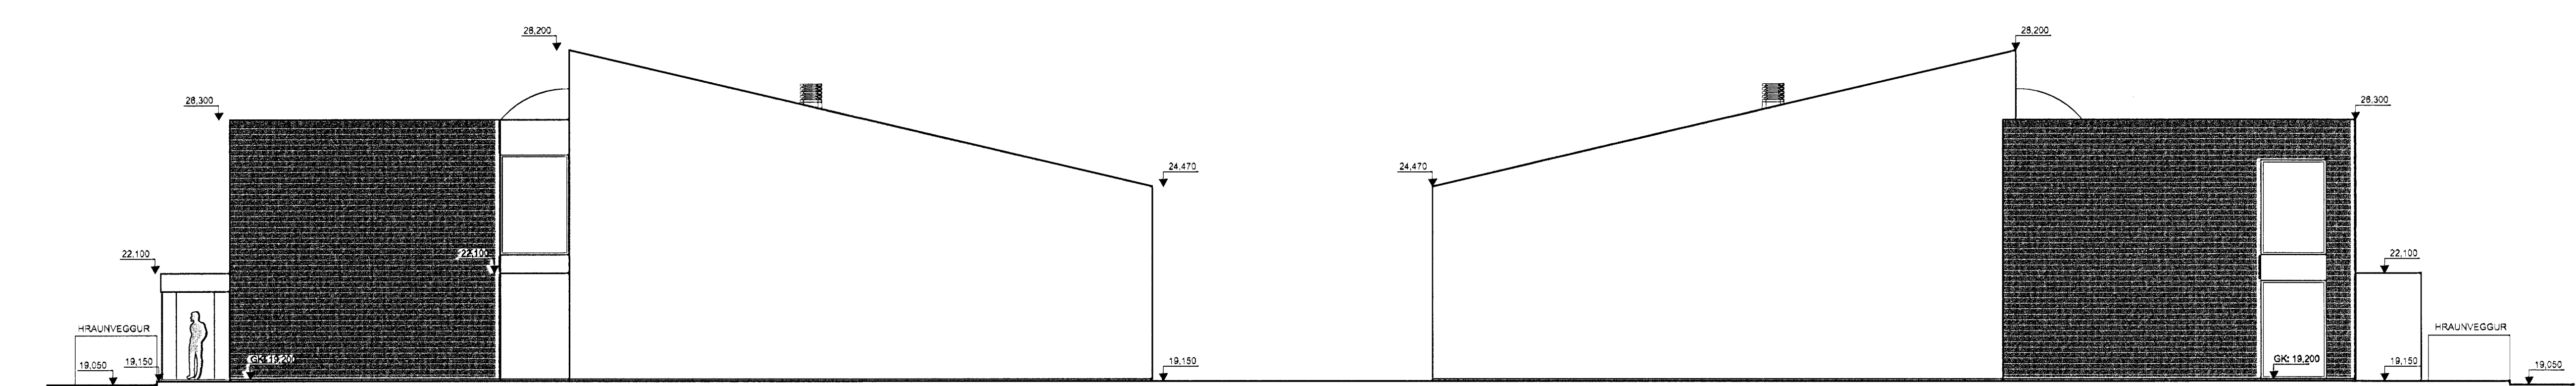

ÚTLIT SUÐUR
MKV 1:100

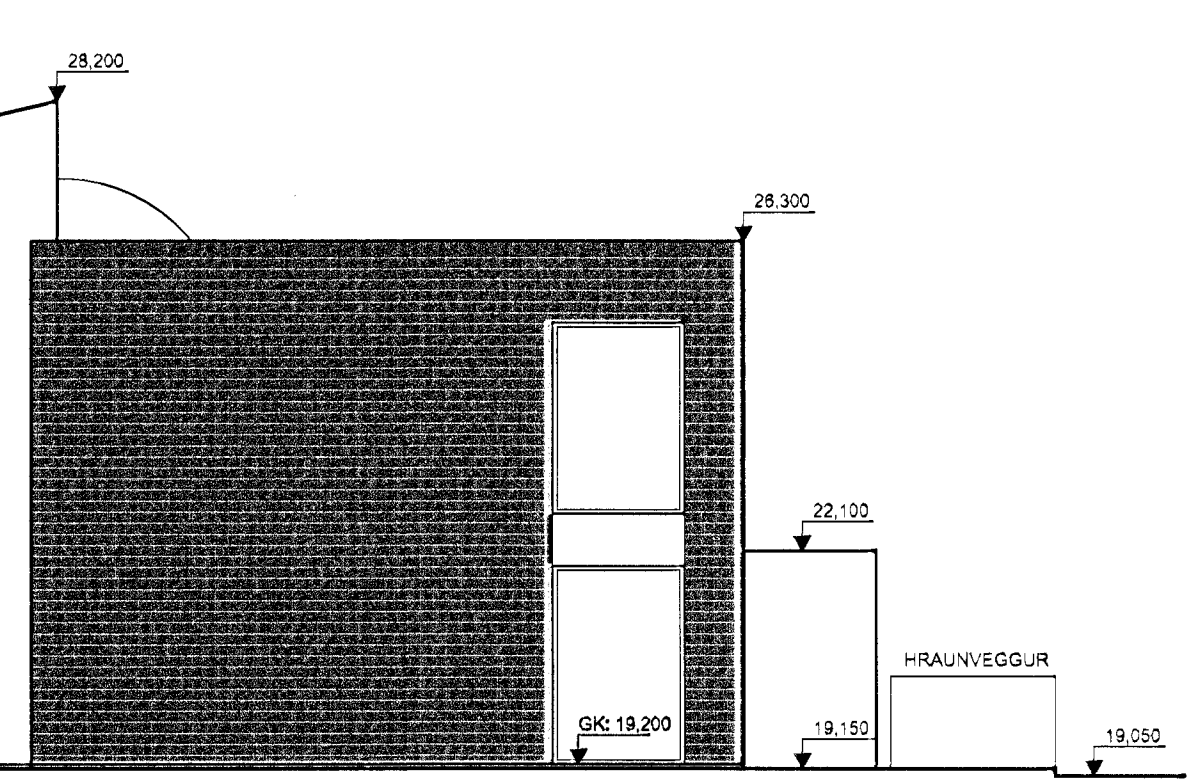

ÚTLIT NORÐUR
MKV 1:100



01 05.05.09 GS/BS Reyndarteikning
00 12.06.07 GS/SBJ Bygginguvaltrúinn
B 05.06.07 GS/SBJ Rýni og samþykkt verkaupa
A 01.06.07 GS/SBJ Innd rýni SH 04.06.07
Úg Daga Telk. Skýring / breyting Samp. af Daga.

FASTEIGNAFÉLAG HAFNARFJARÐAR
FRAMKVÆMDARSVIÐ HAFNARFJARÐAR

NORÐURHELLA 2 0651
Landsúmer: 204715
Stgr. 1490-1-6630020, MH. 01

ADALUPPDRÁTTUR
REYNDARTEIKNING
ÚTLIT 0651_0-(99)-A-306
MKV: 1:100
TEIKNAD: GS/BS
ÚTGÁFA DAGS: 05.05.09
STOFN, DAGS: 01.06.07
BLADSTÆRD: A1
ÚTGÁFA 01



Jón Ólafur Ólafsson FAJ
kt: 090658-4099
Sigurður Einarsson FAJ
kt: 110457-2789
Sigurður Harðarson FAJ
kt: 03348-3999
kt: 521291-1259
Tíðuhraunil 1
220 Hafnarfríð
S: 54 54 700 F: 54 54 701
Netfang: batteri@arkitekt.is
Hélmásíða: www.arkitekt.is

© BATTERIÐ EHF
ÖLL RÍMOT OG AFMÖTUNARTEIKNINGUR ER HJÚTA EÐA Í HEILD ER HÁG SKOPLESIU LEYFI HÖFUNDNA