

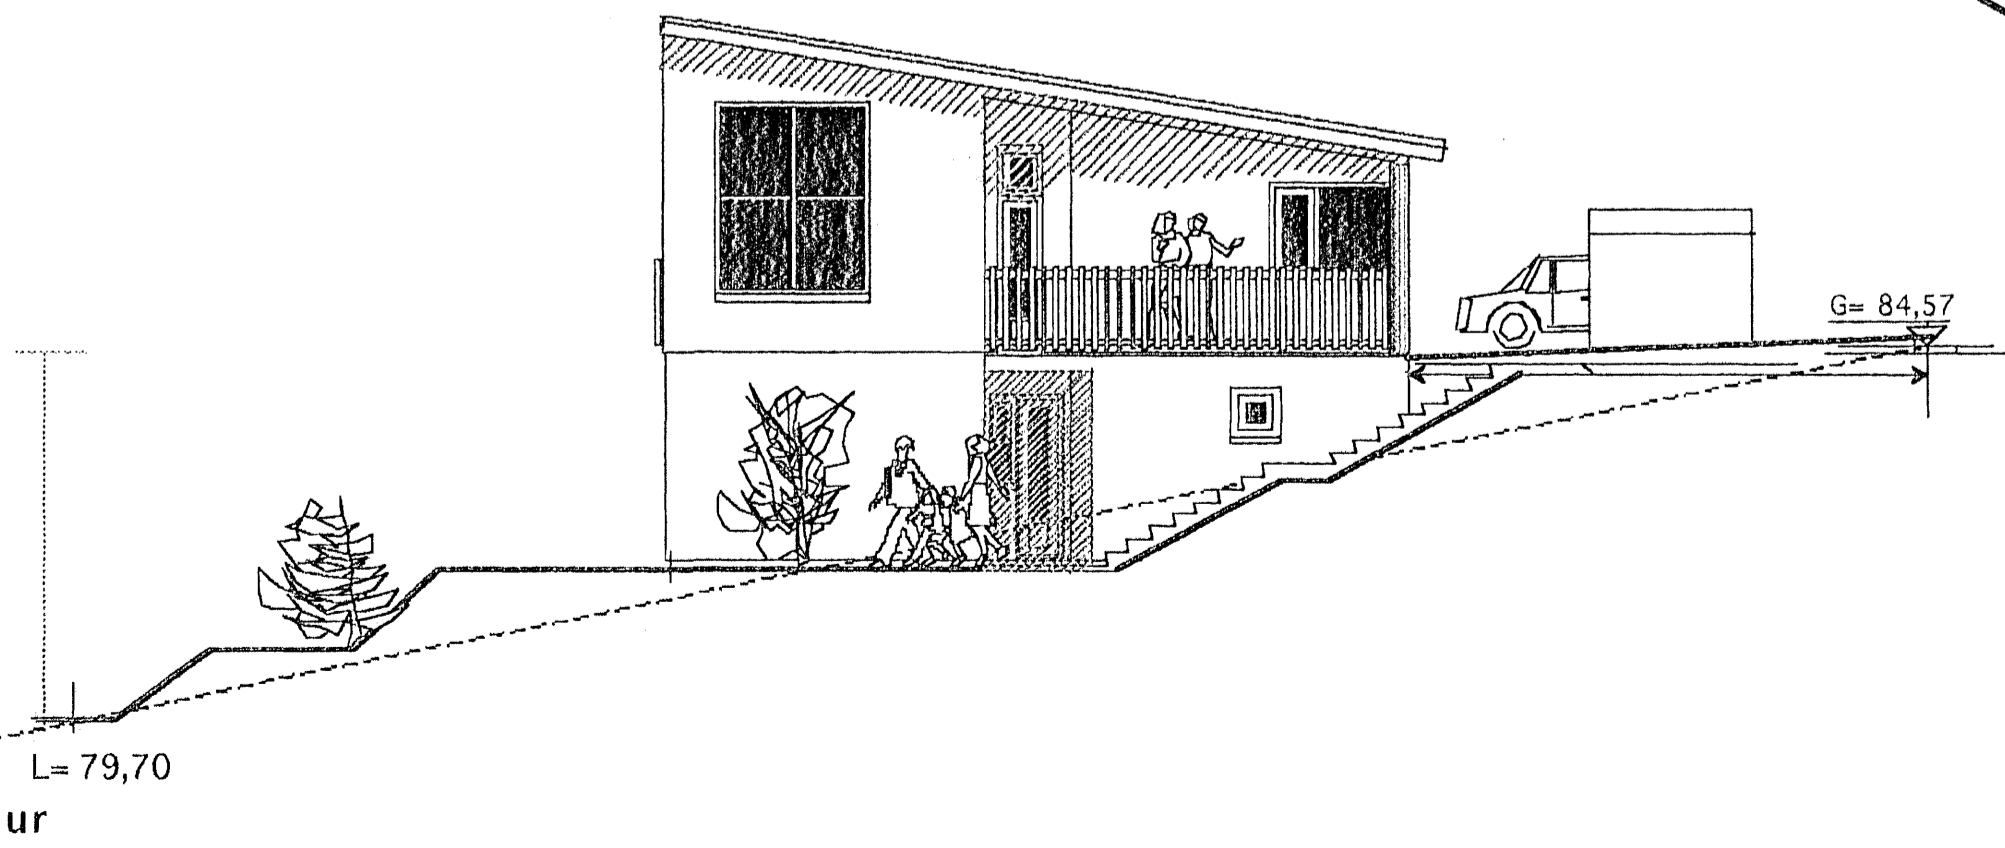
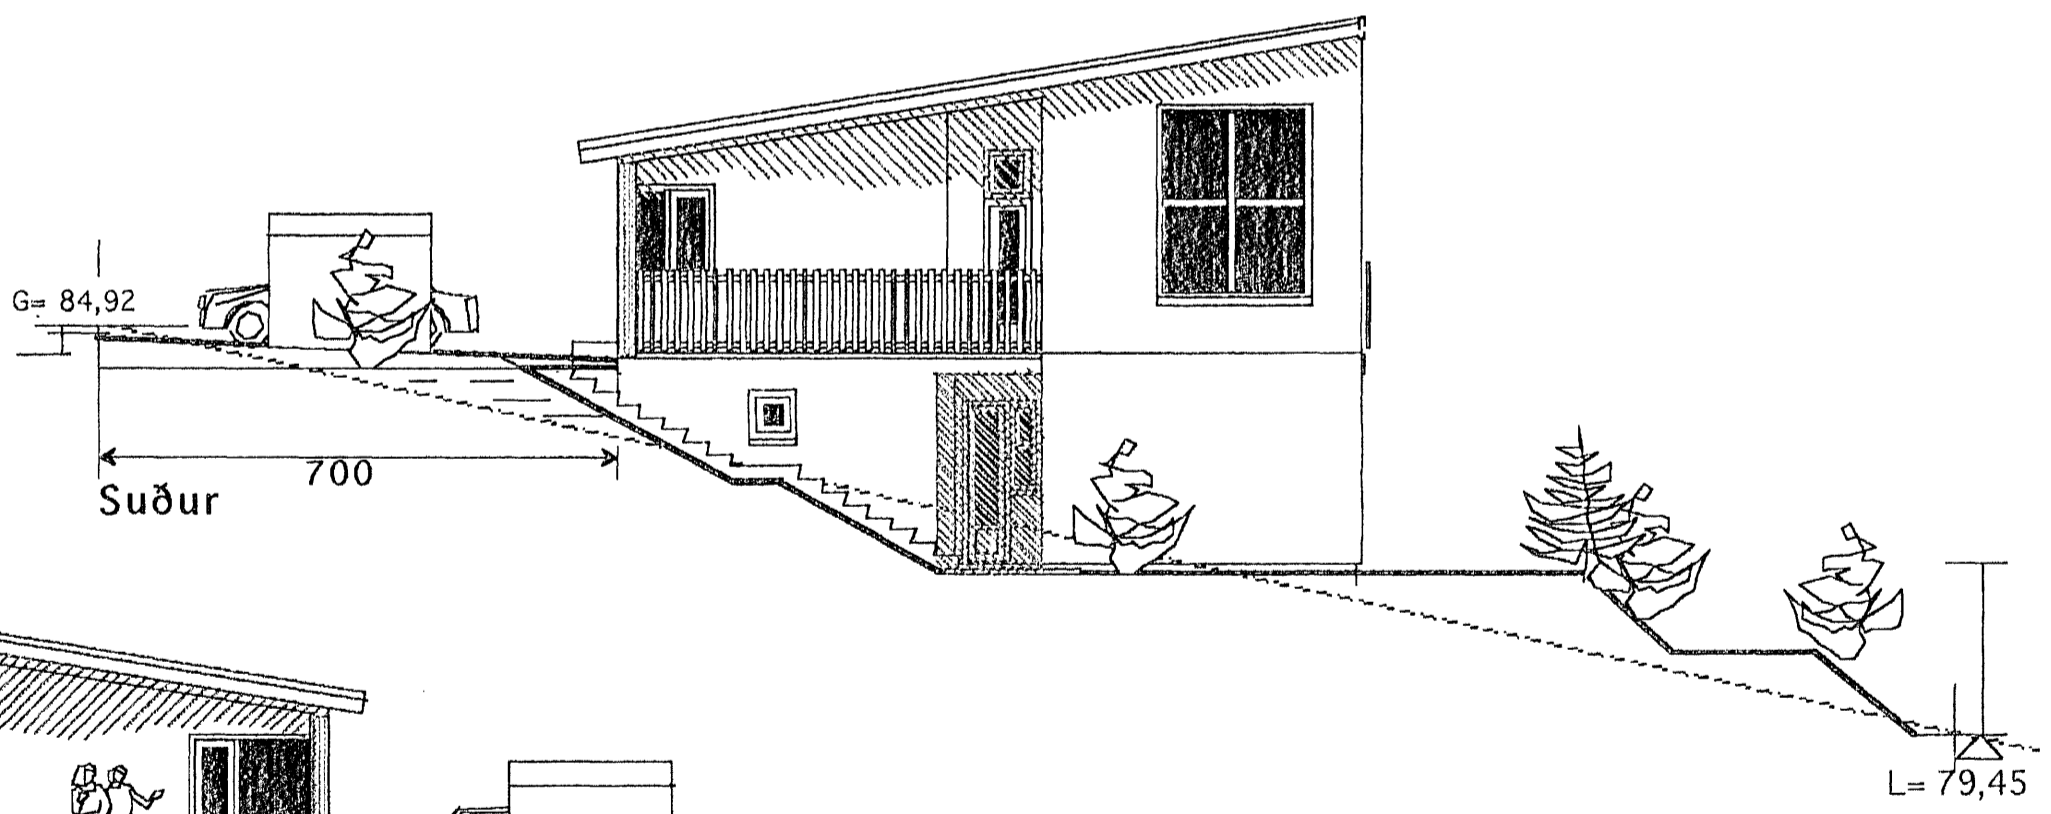


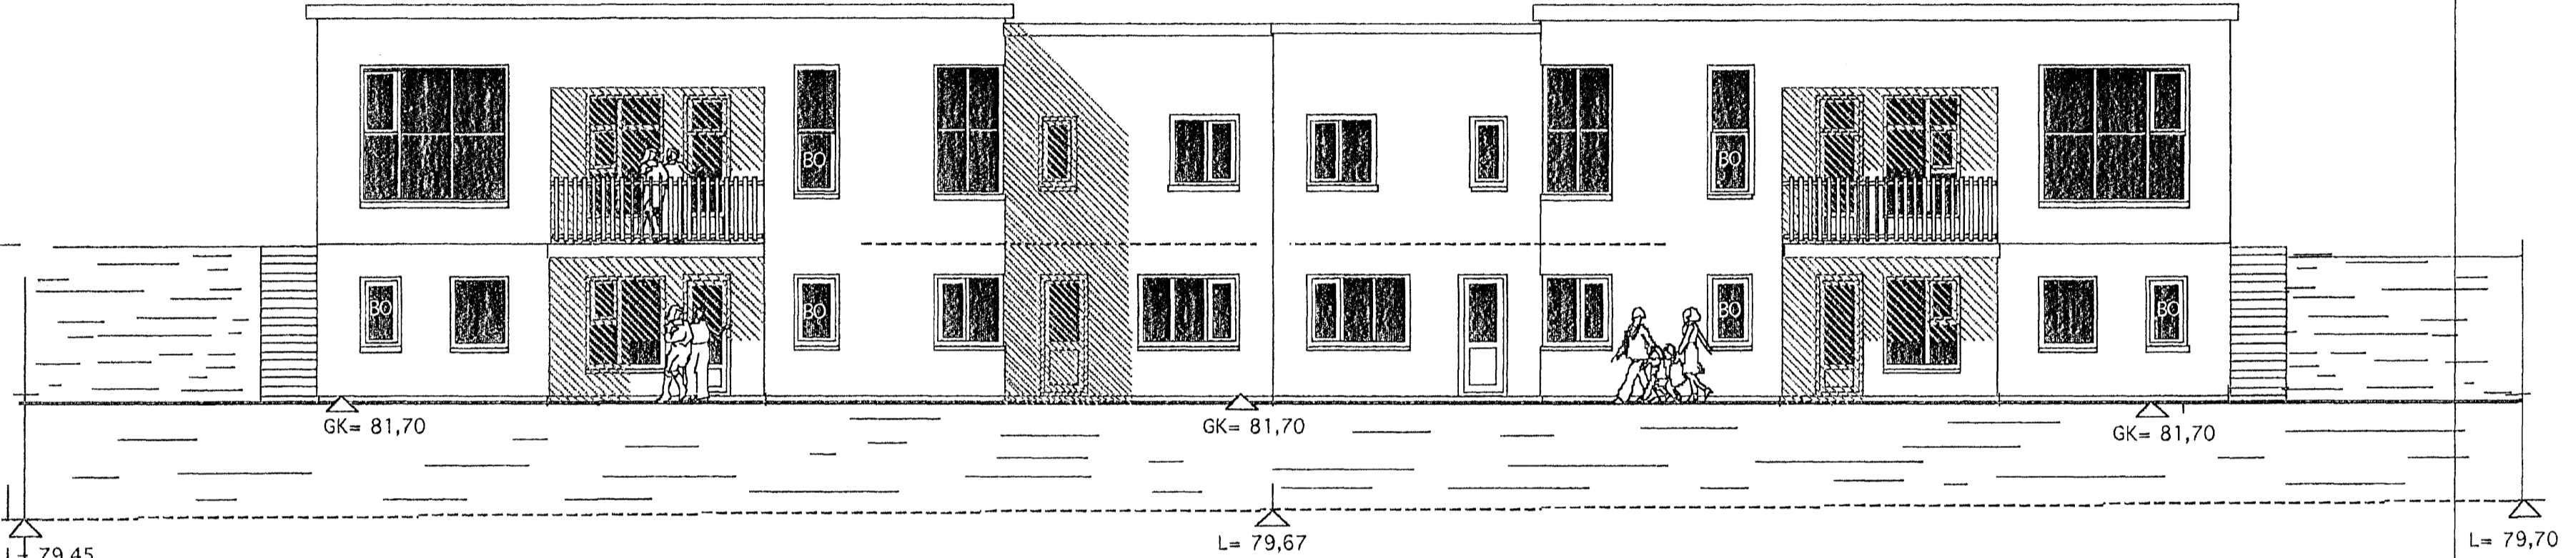

Samþykkt þann

8 FEB 2008

Bygging: *[Signature]* Hlíðarás 19-21
F.h. Jón Sigurðsson

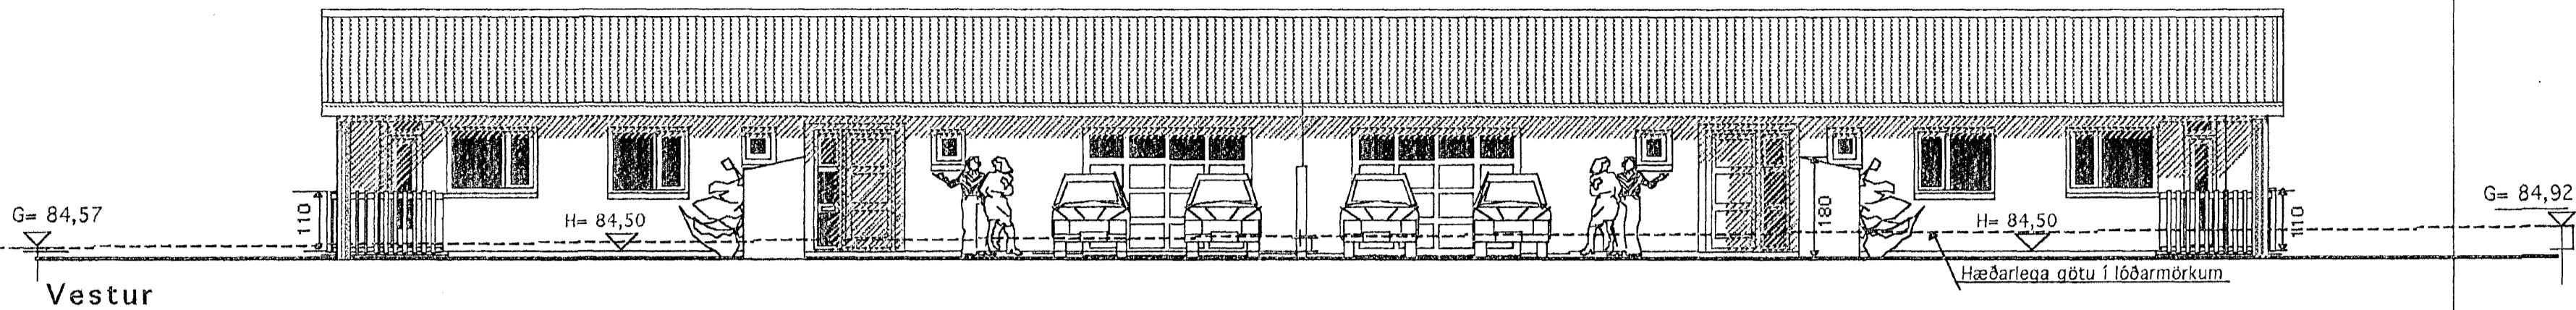

Breytt 23. SEPT. 2007
 Pak yfir svólum breytt.
 Lítilsháttar br. gluggum.
 Ný skráningartafla vegna, köld geymsla.

TEIKNISTOFAN 	Verkefni
	HLÍÐARÁS 19-21 HAFNARFIRÐI
	Heiti
	ÚTLITSMYNDIR

kvarði	1:100	verk.nr	
dags.	2.. JAN 2007	dags br.	23. SEPT. 2007
hönnun	G. G.	teikn nr	
teikn	G.G.		A-3

Hringbraut 17 220 Hafnarfirði
 s. 555-2020. fax 555-2021
 Gísli G. Gunnarsson BFI kt, 020649-2409
 netf. kvarði@vortex.is. www.kvardi.is

[Signature]