
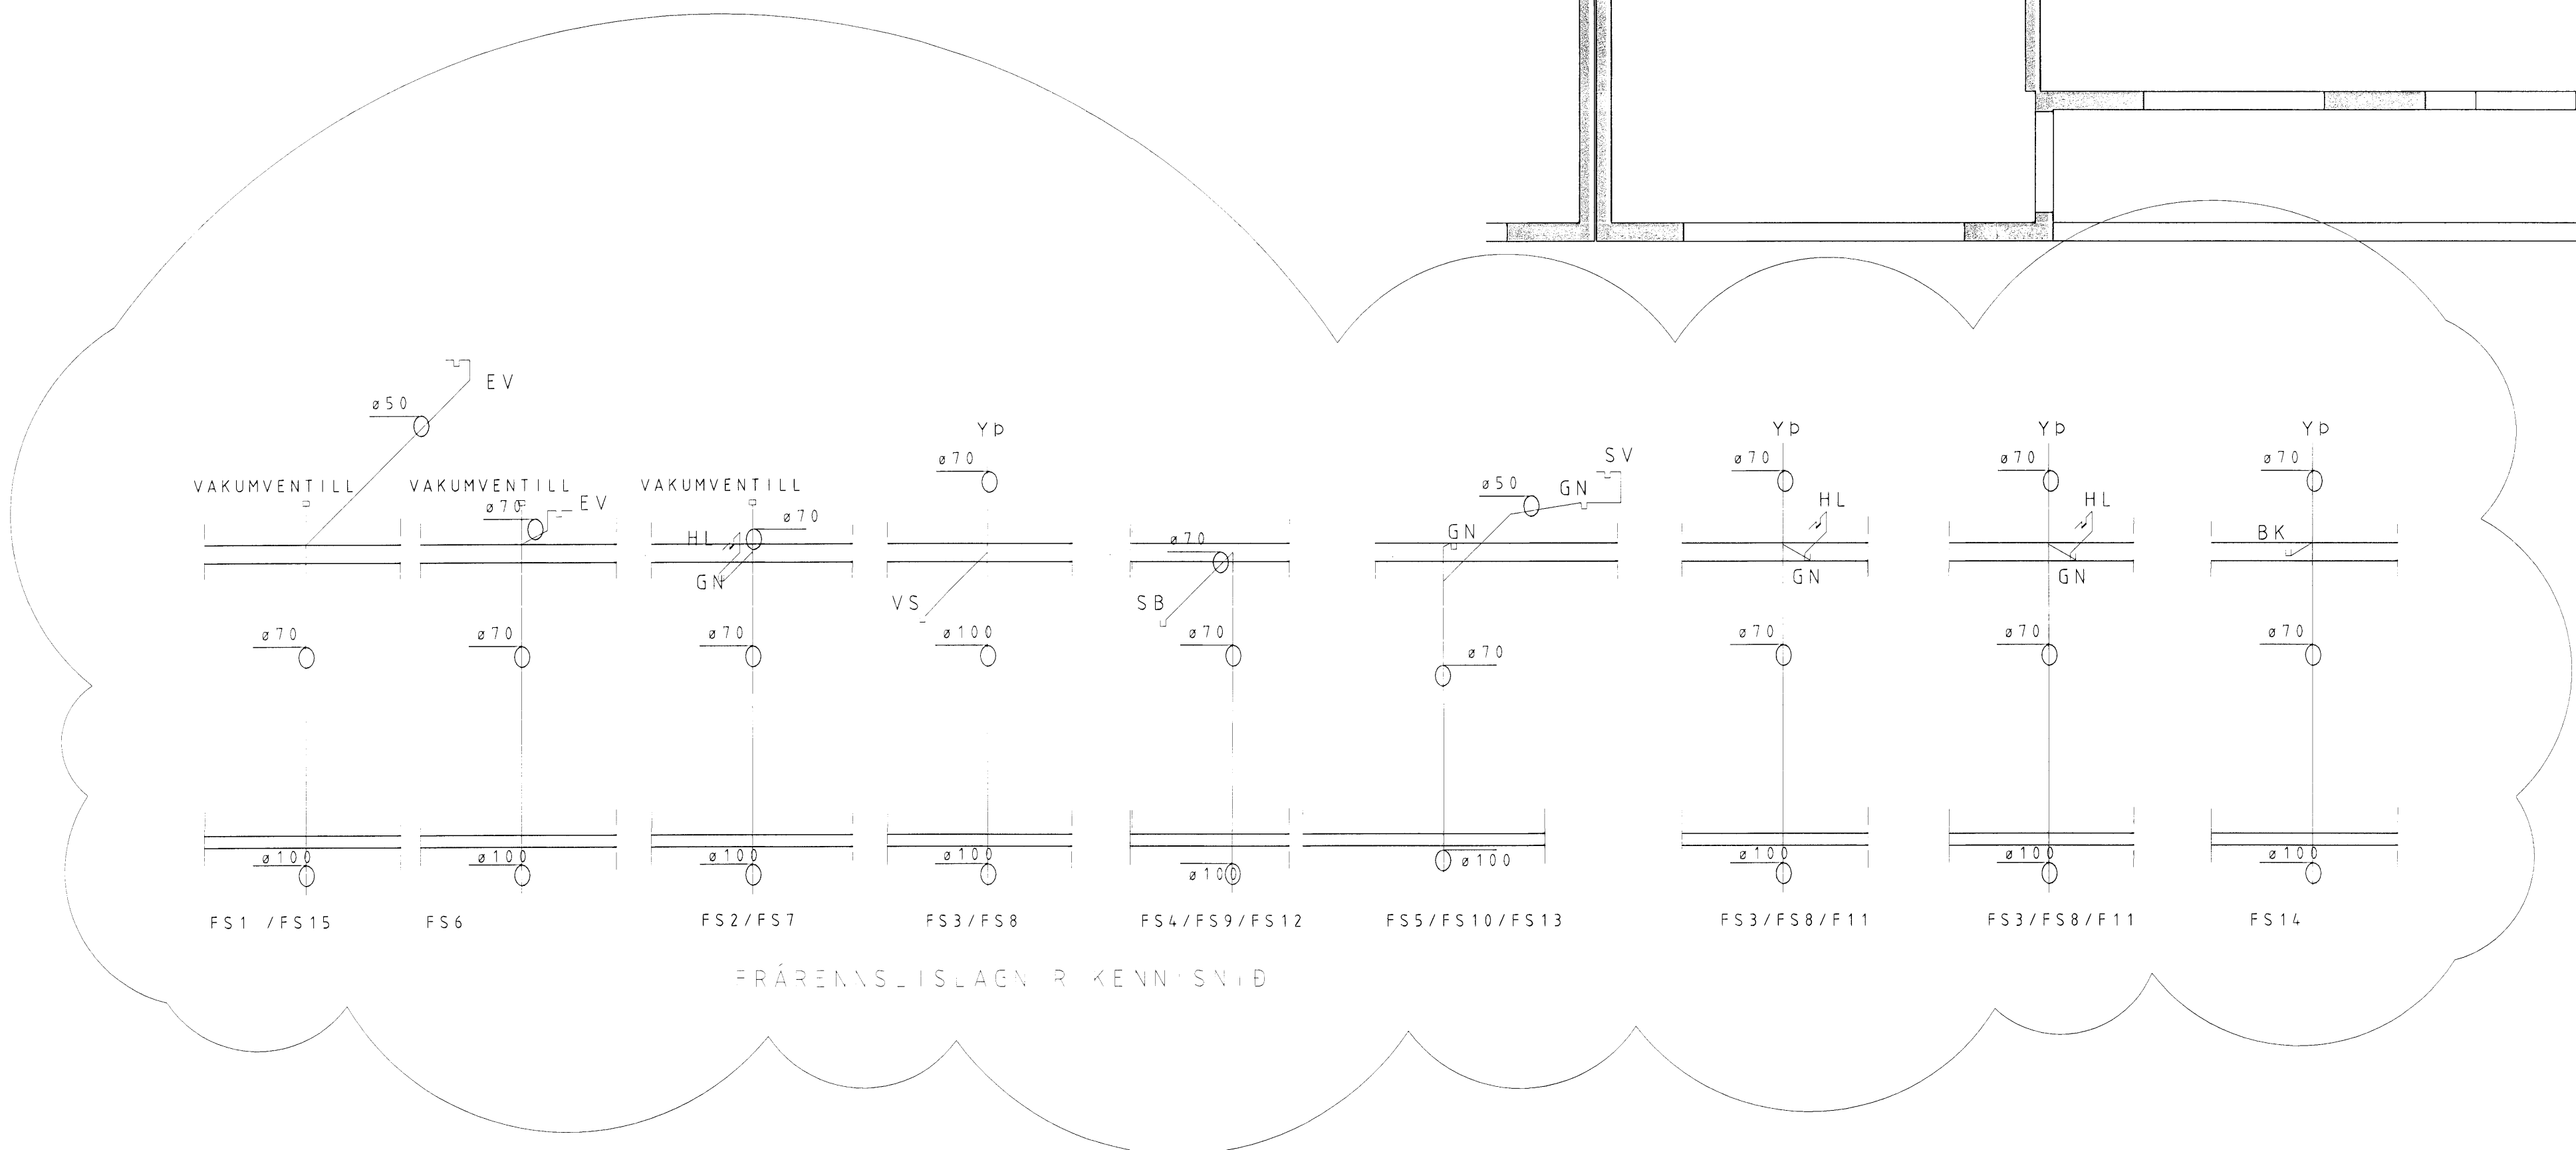


GATAPLAN DAKPLATA 1:50

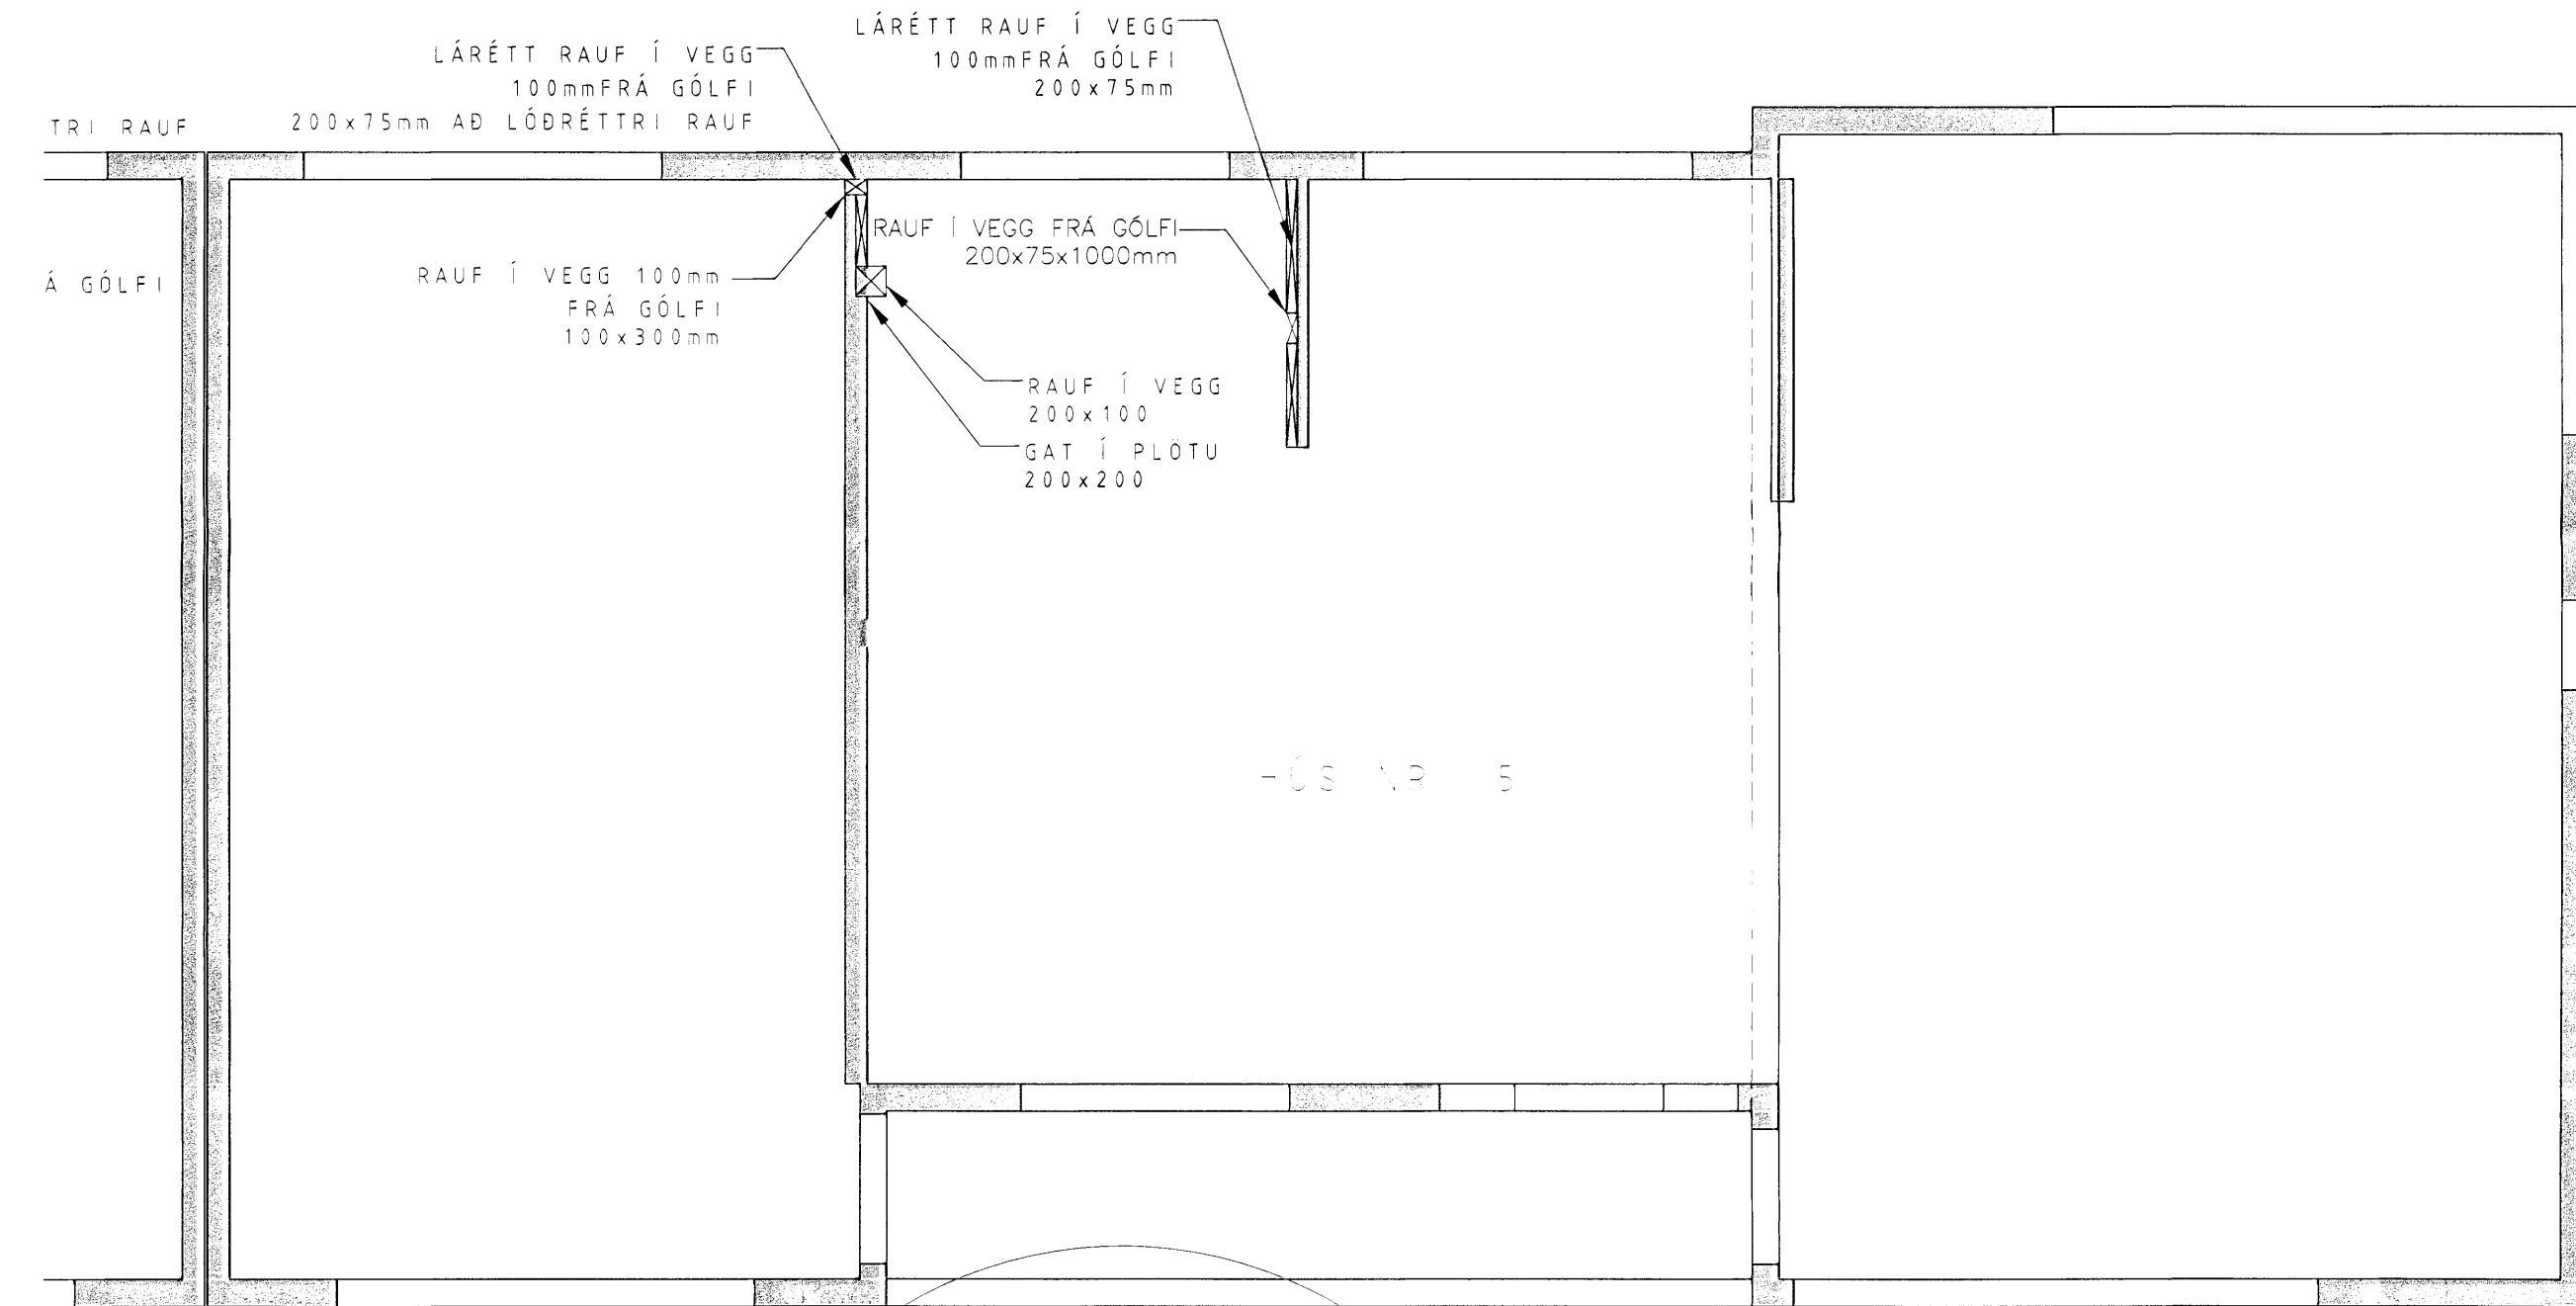

FRÆRENNS-ISLAGNIR KENNISNID

Tilvisun: Helti teikningar:			
X			
8			
7			
6			
5			
4			
3			
2	6.6.08	V.J. V.J.	BREYTING Á LÖGNUM Í HÓSI NR. 5
1	3.6.08	V.J. V.J.	BREYTING Á LÖGNUM Í HÓSI NR. 1
Br.	Dags.	Af.	Sam. Breyting:
<i>Margrjetta Langa 00872-5269</i>			
Vignir Jónsson Byggingatæknifráedingur			
Skipasundi 47 104-Reykjavík			
Sími: 564-0224			
e-mail: vignir1@solark.is			
FL. ÞARÁS 1-5			
HAFNAF JÖRÐUR			
LAGNIR			
GATAPLAN DAKPLATA			
OG FRÆRENNS-ISLAGNIR KENNISNID			
VERK NR	004	KVÁRDI	
TEIKN NR	0025	1:50	BL NR P5
V.J.	V.J.	V.J.	<i>Vignir Jónsson</i>
DAGS	27.07.2007	BYGGING	VIGNIR JÓNSSON
AF	020561-4759	BYGGING	<i>Vignir Jónsson</i>