


GRUNNMYND 3.HÆÐAR A-ÁLMA
 1:100

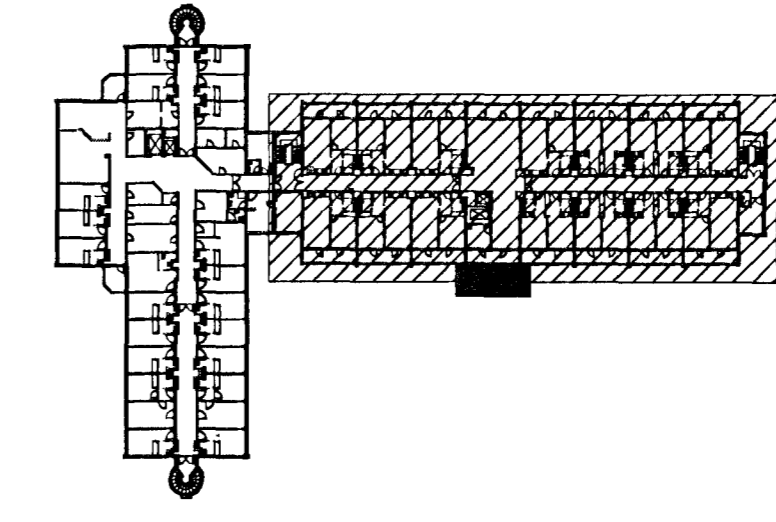

breytingar

Hrafnista Hafnarfríði
 Hraunvangi 7
 Gunnmynd 3.hæðar
 A-álma breytt skráning

31.12.2008 1:100
 dag. msk. breyting 05-03-A
 tokn.

TEKNISTOFA HALLDÓRS GUÐHUNDSSONAR FAF
 FAXAFEN 9 · 103 REYKJAVÍK · Sími: 545 1000
 Faxi: 545 1010 TH@TH.IS WWW.TH.IS