

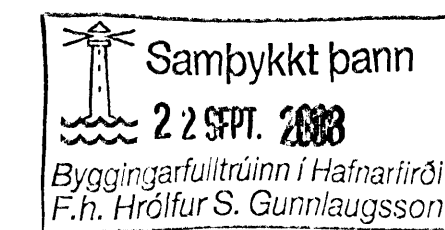


(teikn. nr. 21-06)

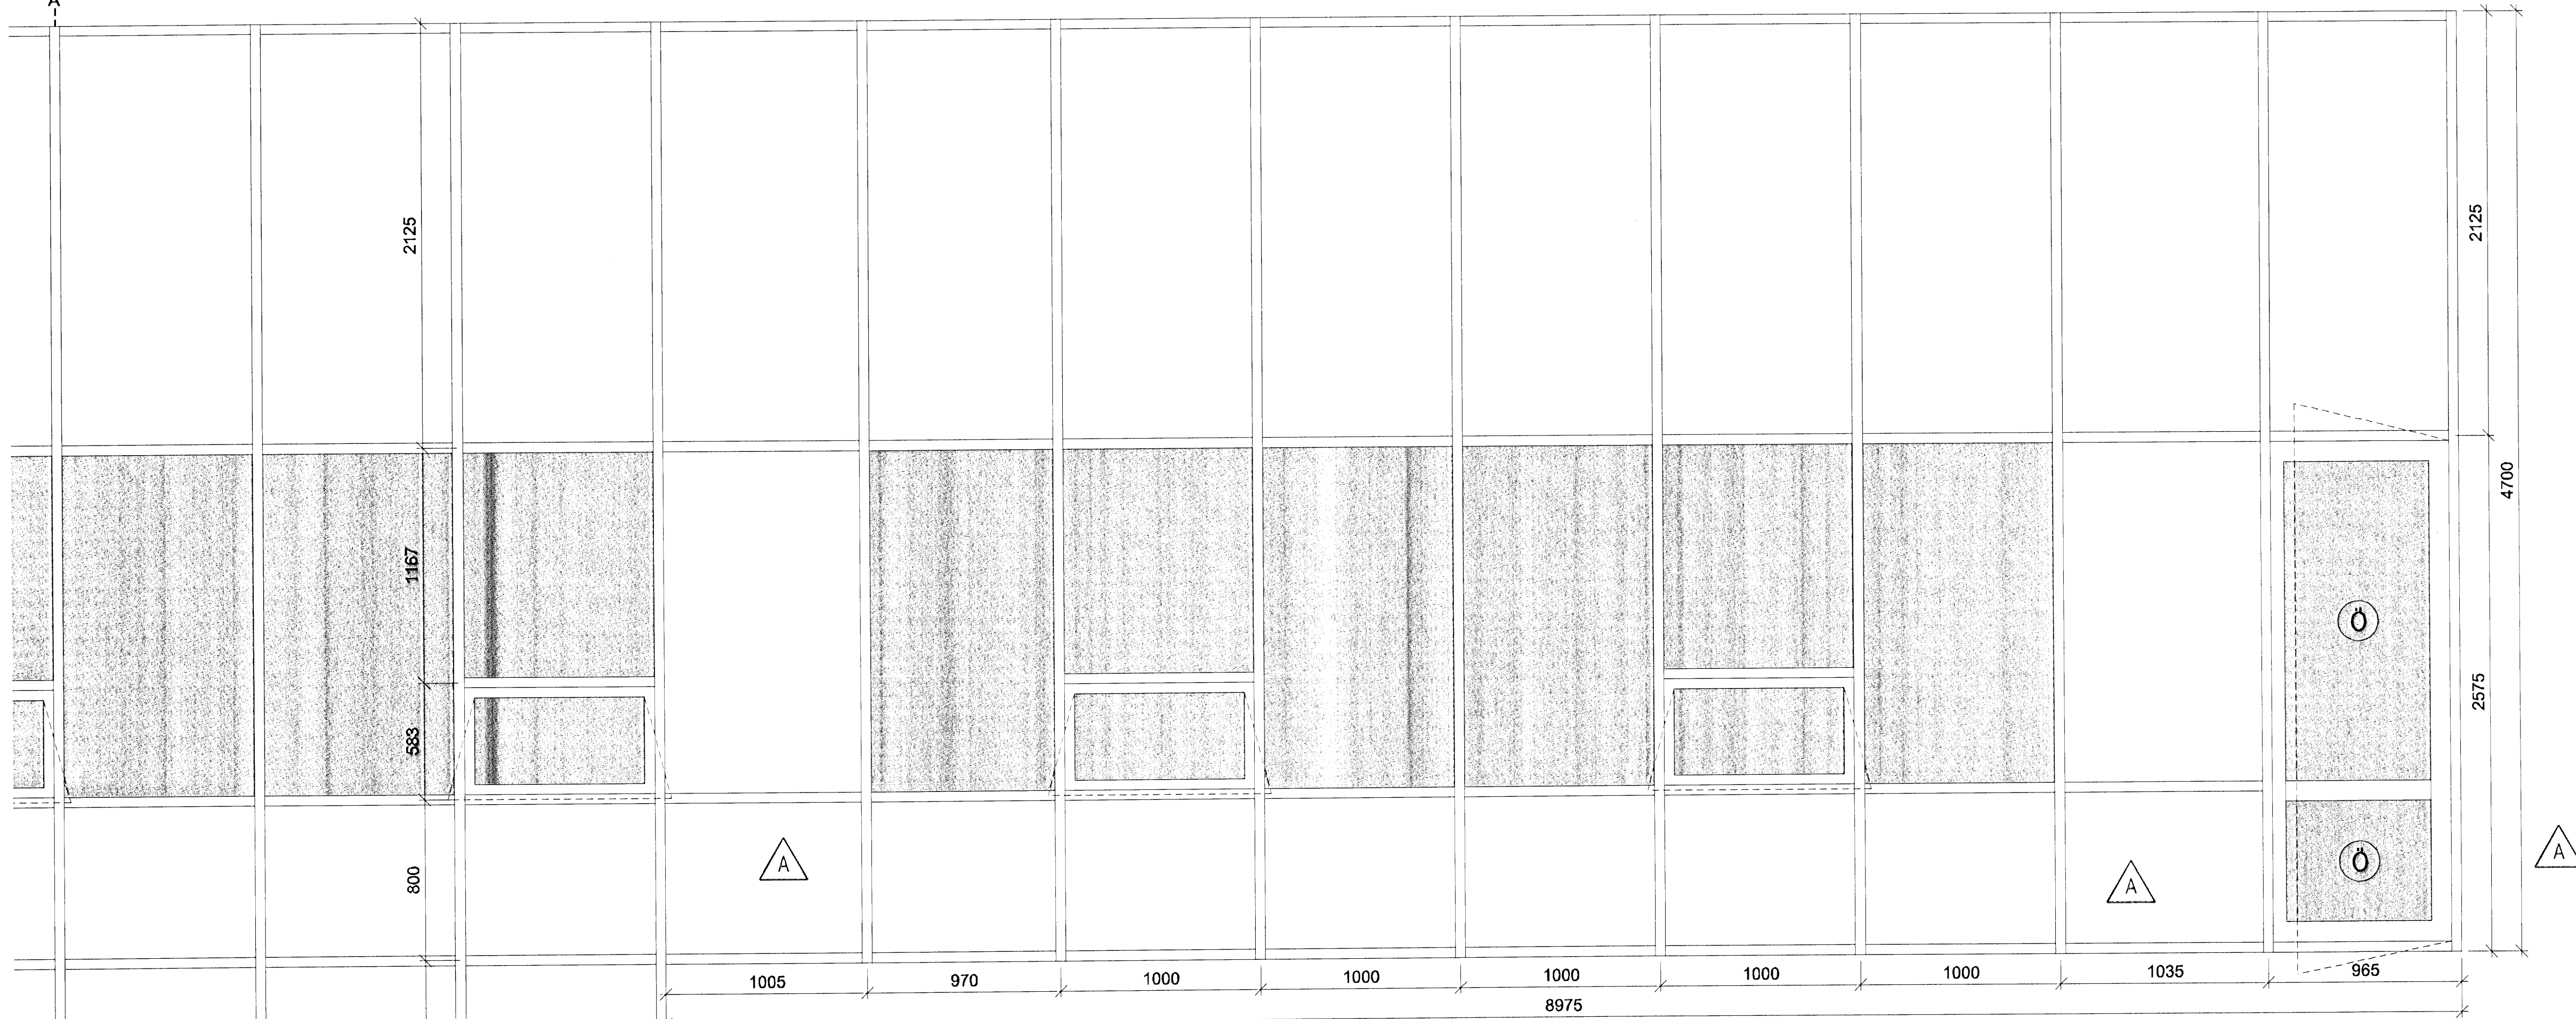

SKÝRINGAR
Sjá teikningu nr: 21-01 og 21-05

(teikn. nr. 21-08)

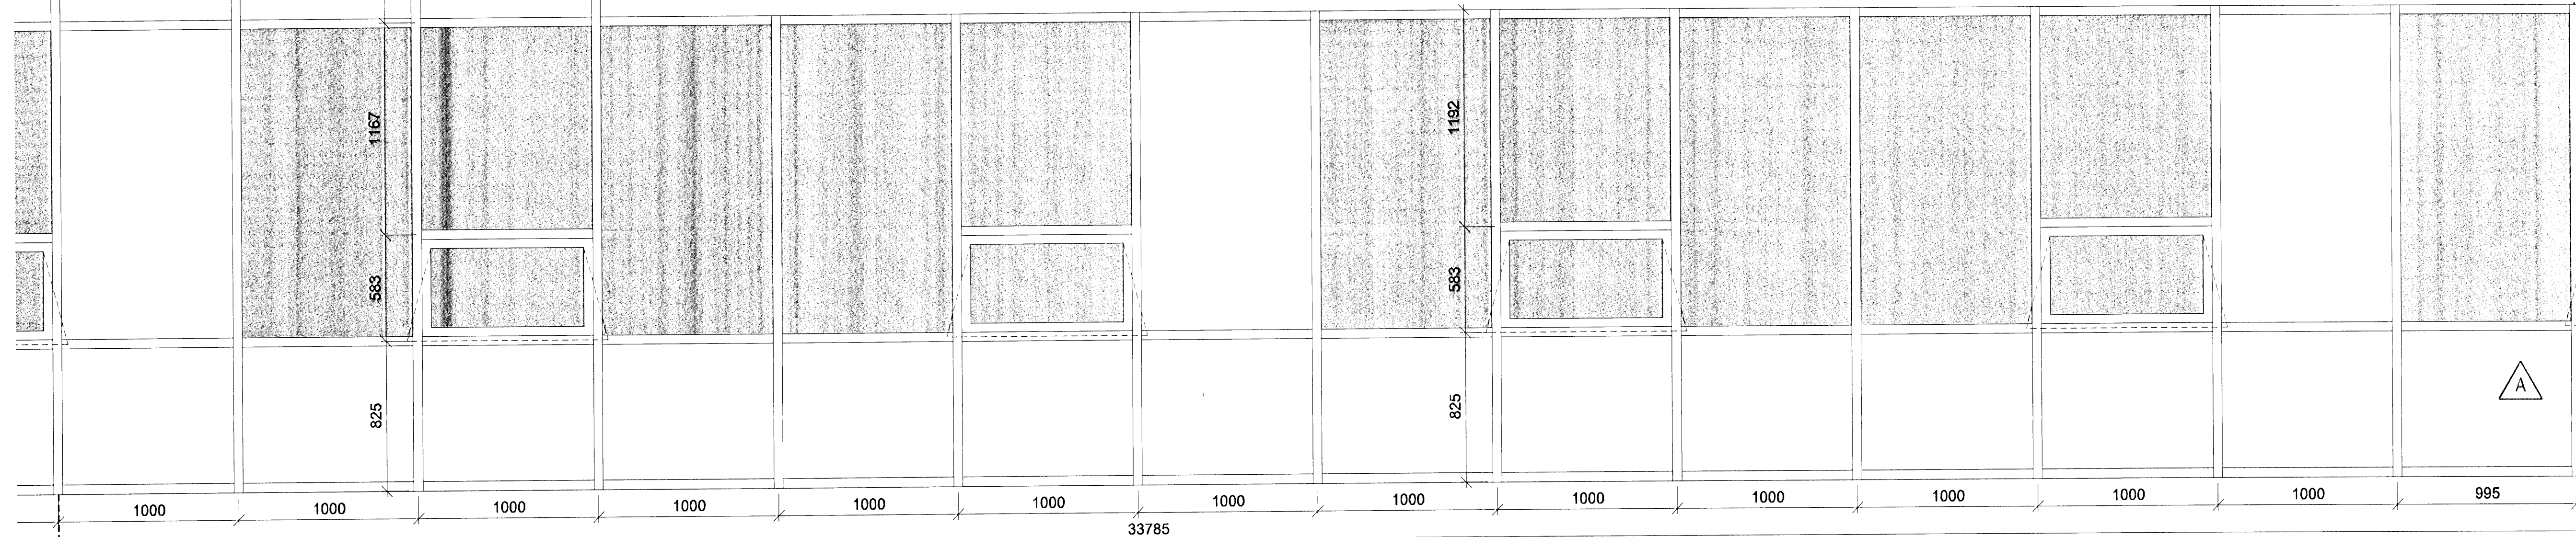


(teikn. nr. 21-06)

(teikn. nr. 21-08)

A OI HMH 09.07.2008
Póstum hlöðrað til samræmingar við uppsteypt gluggasög

ÚTGÁFA TEIKNAD SAMÞYKKT DAGS
BRIEFINGAR

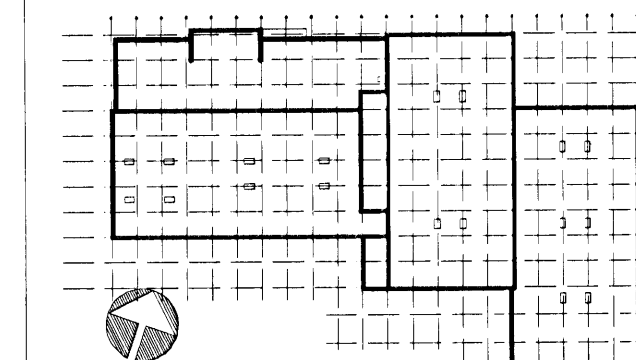

ASK Arkitektar
Gangsgölu 3
101 Reykjavík
Sími 515 0300
Fax 515 0319
www.ask.is

Áritun aðalhönnuðar:

Helgi Már Halldórsson
Helgi Már Halldórsson arkitekt FAI, st. 301258-7049

GJÁHELLA 4, HAFNARFIRÐI
HÉDINN

VERKENEFTI
HEITI TEIKNINGAR
VERKTEIKNINGAR
GLUGGAKERFI
NORÐUR HLÍÐ

VERK NR. 06124
NÚMÉR TEIKNINGAR 21-07
ÚTGÁFA A



ASK
ARKITEKTAR

MOV. T. A1
1:20
TEIKNAD HMH / OI
DAGS 28.03.2008
ÚTGÁFA A