


YFIRLITSMYND LÓÐAR

1:500

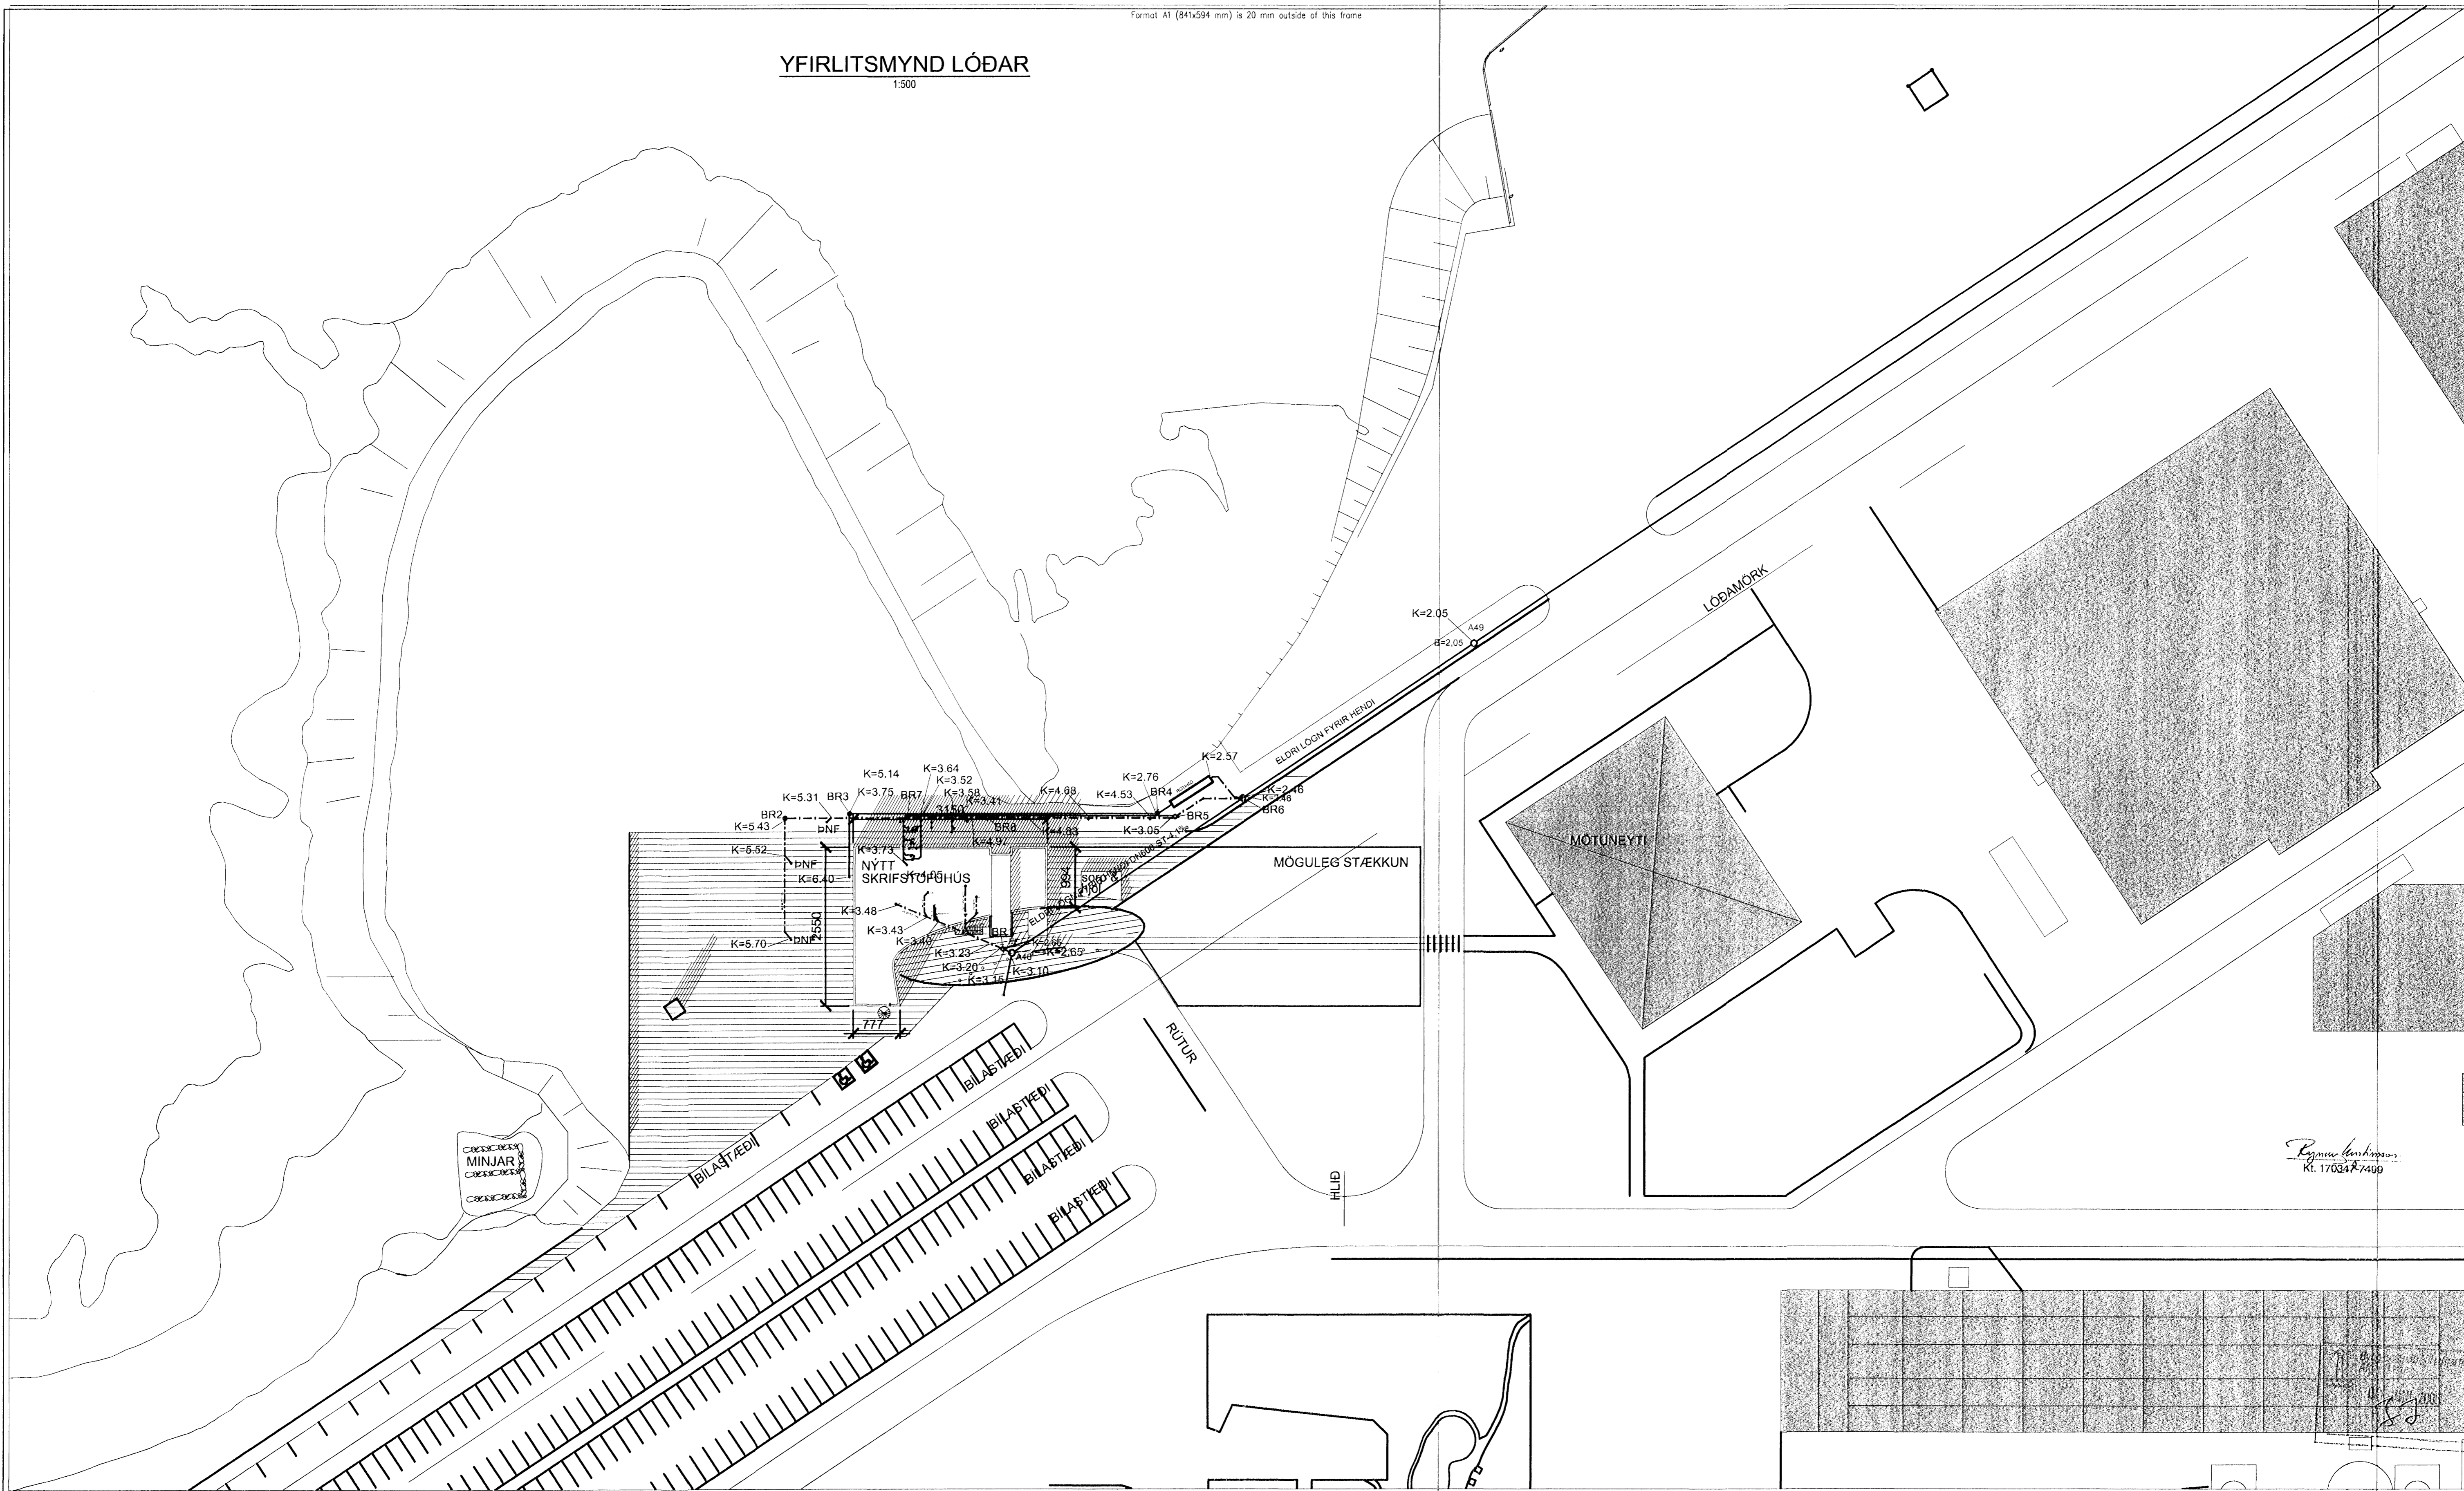

Egmaður
Kl. 170317-1409

Skýringar:
Explanations:

[Handwritten signature]



Breyt. Rev.	Breyting / Revision	Daga / Date	Samb. / Approved	Nöfn. heimil. / Released
2	EFTIR FRAMKVÆMD	28.09.04	ÓS.	
1	VINNUTEKNING	09.09.'03	RK.	

This drawing is the property of the Alcan Iceland Ltd. and handed out for personal use only. It may neither be copied nor made available to others without permission of the Alcan Iceland Ltd. The receiver is liable for any misuse.

Fjöldi stúkja / Number of pieces	Hlutur / Object	Atriði / Item	Efni / Material	eo-stk / Weight (kg)	total fjöldi / Total pieces	Athugasemdir / Remarks
IV III II I	SKRIFSTOFUHÚS ALCAN				Mhl. 94	
	AFSTÖÐUMYND LÓÐAR				AKS no. 4110	1:500
	FRÁRENNISLAGNIR	<i>Meurgata 3</i>			UM10	
	VGG CONSULTING ENGINEERS LTD.				9K-61	2
	ALCAN PRIMARY METAL EUROPE				168802	2