


GRUNNMYND KJALLARA - HREINLÆTISLAGNIR

1:50

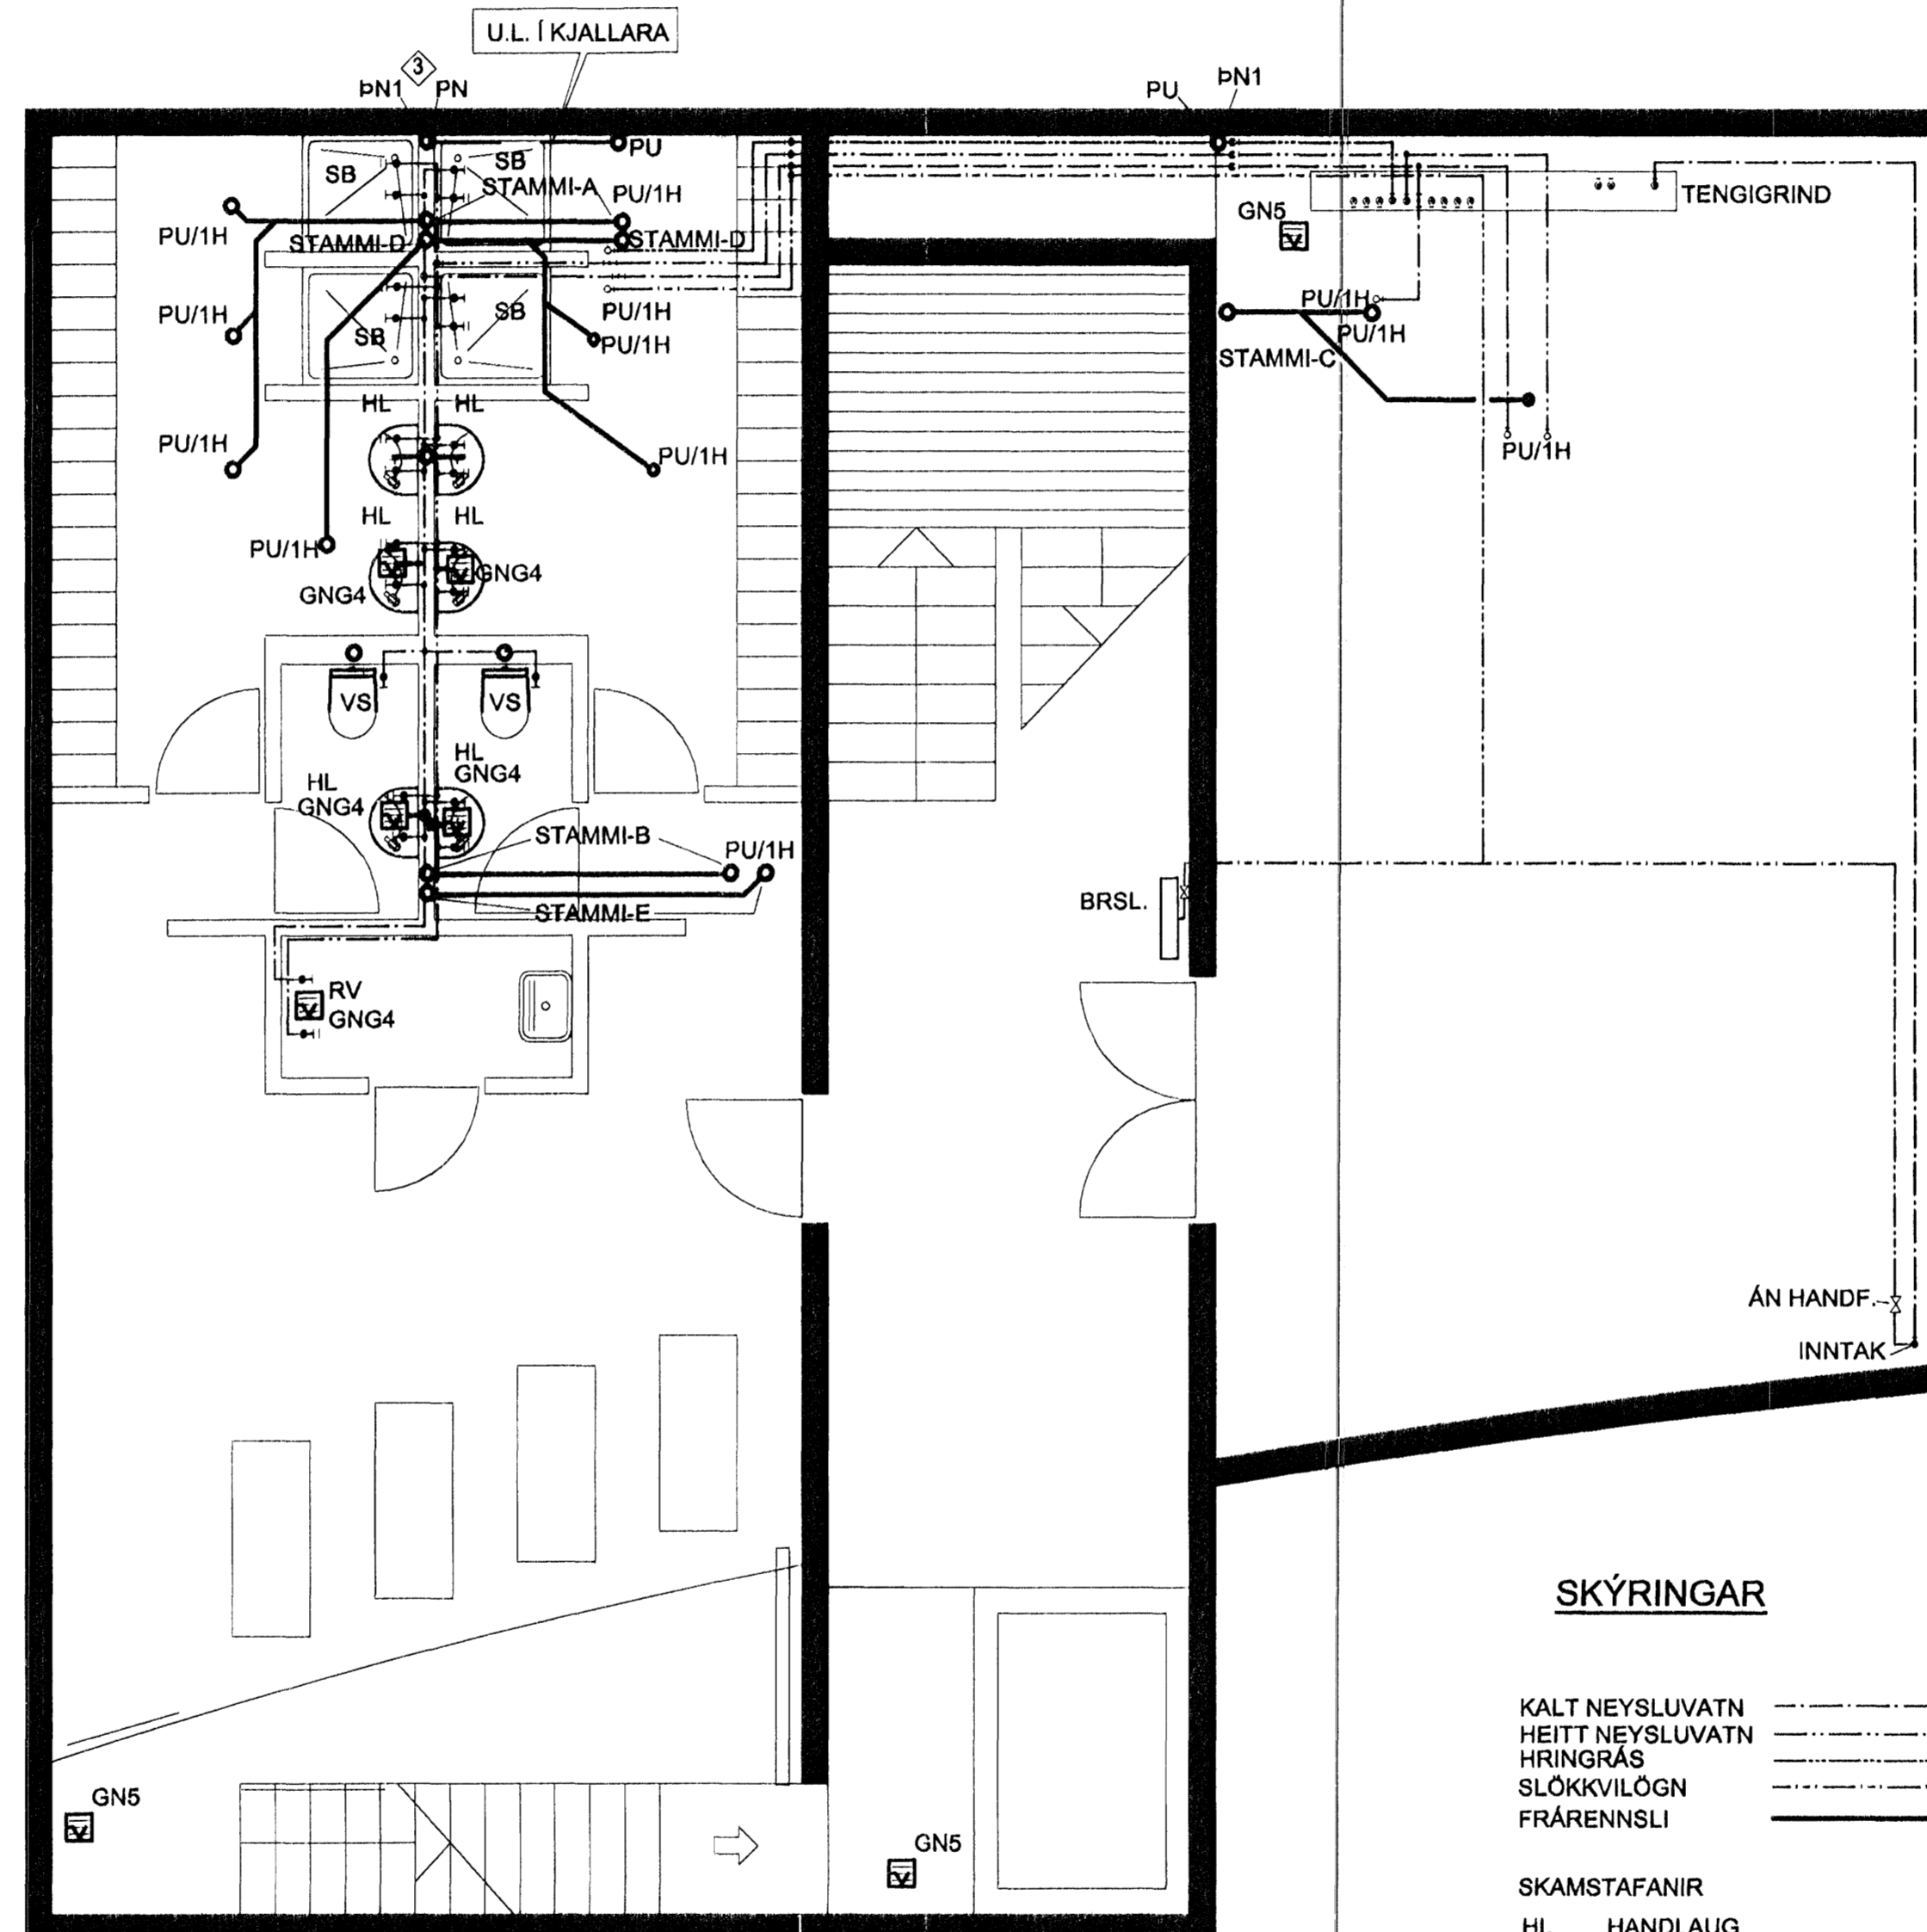

SKÝRINGAR

KALT NEYSLUVATN
 HEITT NEYSLUVATN
 HRINGRÁS
 SLOKKVILOGN
 FRÆRENNSLI

SKAMSTAFANIR

HL HANDLAUG
 HR HREINSIGREIN
 SB STEYPIBÁÐ
 UP UPPÞVOTTAVÉL
 VS VATNSSALERNI
 ÞS ÞVAGSKÁL
 ÞT ÞAKTÚÐA
 ÞV ÞVOTTAVÉL
 GNG4 GÓLFNIDURFALL DN70 M. GEGNUMRENNSLI
 GNG5 GÓLFNIDURFALL DN100
 PN1 ÞAKNIDURFALL DN110x18,3 - PPR 80 - PN20
 EINANGRIST MED ÁDRAGSEINANGRUN
 OG PLASTVEFJIST.

Skýringar:
 Explanations:



Breyt. Rev.	Breyting Revision	Dags Date	Samb. Approved	Notk. heiml. Released
5	EFTIR FRAMKVÆMD	28.09.04	ÓS.	
4	NÝR GRUNNUR	07.05.04	ÓS.	
3	ÞAKNIDURFÖLL PN1 KOMA INNANHÓSS	31.03.04	RK.	
2	ÓTLOFTUN FÆRÐ TIL LEGU LAGNA UNDIR STIGAPALLI BREYTT	17.12.03	ÓS.	
1	VINNUTEIKNING	09.09.03	RK.	

This drawing is the property of the Alcan Iceland Ltd. and handed out for personal use only. It may neither be copied nor made available to others without permission of the Alcan Iceland Ltd. The receiver is liable for any misuse.

Fjöldi stykja Number of pieces	Hlutur Object	Atrol Item	Efni Material	eo. stik Weight (kg)	Stærð Form Scale	Alfúlgissæmi Remarks
IV III II I	SKRIFSTOFUHÓÐ ALCAN GRUNNMYND KJALLARA HREINLÆTISLAGNIR				Mhl. 94 4110 01199	
	Virkni / Supplier VGG CONSULTING ENGINEERS LTD.				AKS no. UM10	
Teknið Drawn	ÓS	Virkið Checked		Sambýkt Approved	9K-64	5
Teknið Drawn	ALCAN PRIMARY METAL EUROPE ISAL Alcan Iceland Ltd	Virkið og skráð Checked and Released			168805	5

Byggingarritun
 Kt. 170347-7498
 01.11.2005