


RÚMMYND - HITALAGNIR

1:100

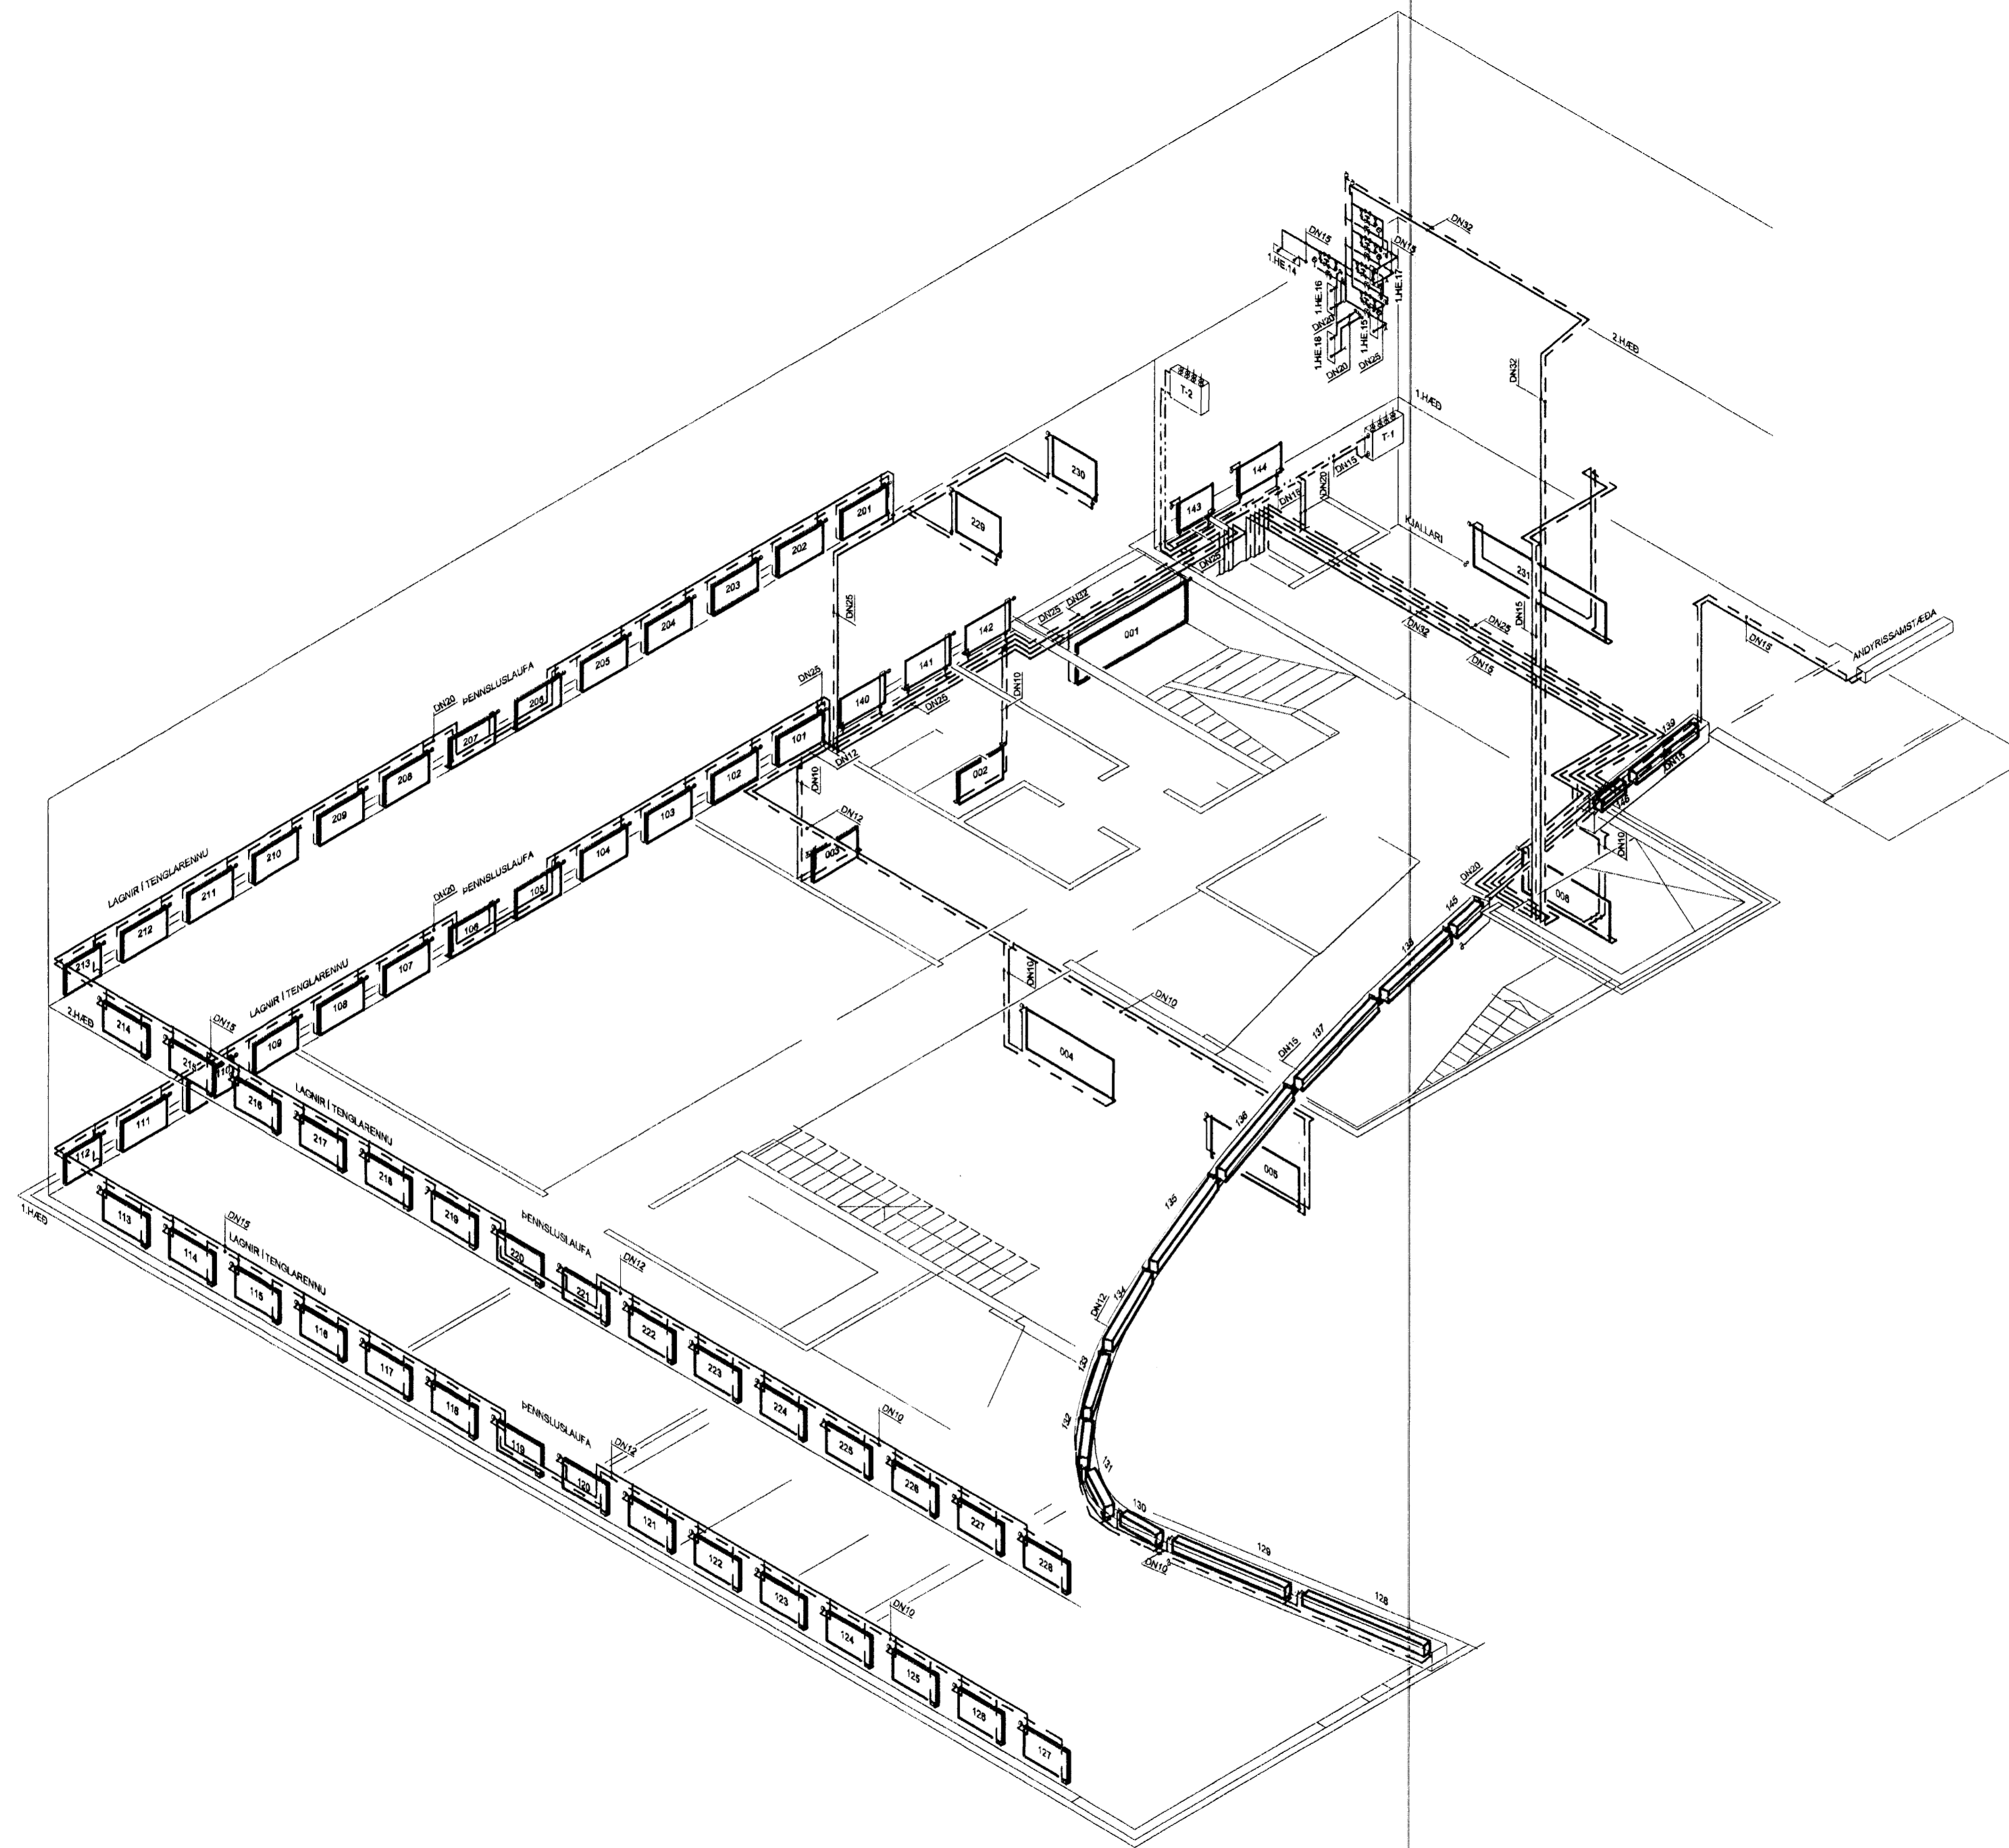

SKÝRINGAR

FRAMRÁS HEITT VATN _____
 BAKRÁS HEITT VATN _____
 FRAMRÁS GÓLFHITA _____
 BAKRÁS GÓLFHITA _____

STOFNPÍPUR SKULU VERA ÚR ÞYKKVEGGJA SVÖRTU STÁLI SAMKVÆMT DIN 2440 OG ÍST-EN 10025, EINANGRAÐAR AÐ UTAN MEÐ STEINULLARHÖLKUM, AF VIÐURKENDRI GERÐ, MEÐ TREFJASTYRKTU ÁLYFIRBORDI. SÝNILEGAR OFNALAGNIR Á VEGGJUM ERU ÚR PUNNVEGGJA STÁLI MEÐ EINANGRUNARHÚÐ OG EINANGRÁST EKKI AÐ ÖÐRU LEITI. LAGNIR SEM TENGJAST OFNUM ERU DN10 NEMÁ ANNAD SÉ TEKID FRAM. OFNAR UTAN OFNAGRYFJU ERU MEÐ FRAMRÁSARLOKA OFNAR Í OFNAGRYFJU ERU MEÐ TVÍSTILLILOKA Á FRAMRÁS ALLIR OFNAR ERU MEÐ STILLITTE OG -LOFTSKRUFU

SAMANBURDARTAFLA FYRIR PUNNVEGGJA STÁLROÐR
 DN10 = $\varnothing 12 \times 1,2$
 DN12 = $\varnothing 15 \times 1,2$
 DN15 = $\varnothing 18 \times 1,2$
 DN20 = $\varnothing 22 \times 1,5$
 DN25 = $\varnothing 28 \times 1,5$
 DN32 = $\varnothing 35 \times 1,5$
 DN40 = $\varnothing 42 \times 1,5$
 DN50 = $\varnothing 54 \times 1,5$

01 JULI 2005
 30

Skýringar:
 Explanations:

[Handwritten signature]

Breyt. / Rev.	Breyting / Revision	Dags / Date	Samþ. / Approved	Notk. / Released
3	EFTIR FRANKVEMD	28.09.04	ÓS.	
2	OFNUM Í OFNAGRYFJU BREYTT	28.01.04	ÓS.	
1	VINNUTEIKNING	09.09.03	RK.	

This drawing is the property of the Alcan Iceland Ltd. and handed out for personal use only. It may neither be copied nor made available to others without permission of the Alcan Iceland Ltd. The receiver is liable for any misuse.

Titillur / Object	Stærð / Size	Skala / Scale	Althugasemdir / Remarks
SKRIFSTOFUHÚS ALCAN RÚMMYND HITALAGNIR	Mhl. 94	1:100	
Varkali / Supplier	Vegvagn 3		
Teiknað / Drawn	ÓS.		
Yfirforð / Checked	ÓS.		
Samþykkt / Approved	ÓS.		
Greitt af ISAL / Taken by ISAL	1688013		
Greitt af ISAL / Taken by ISAL	9K-73		
Greitt af ISAL / Taken by ISAL	3		