


RÚMMYND - HITALAGNIR  
1:50

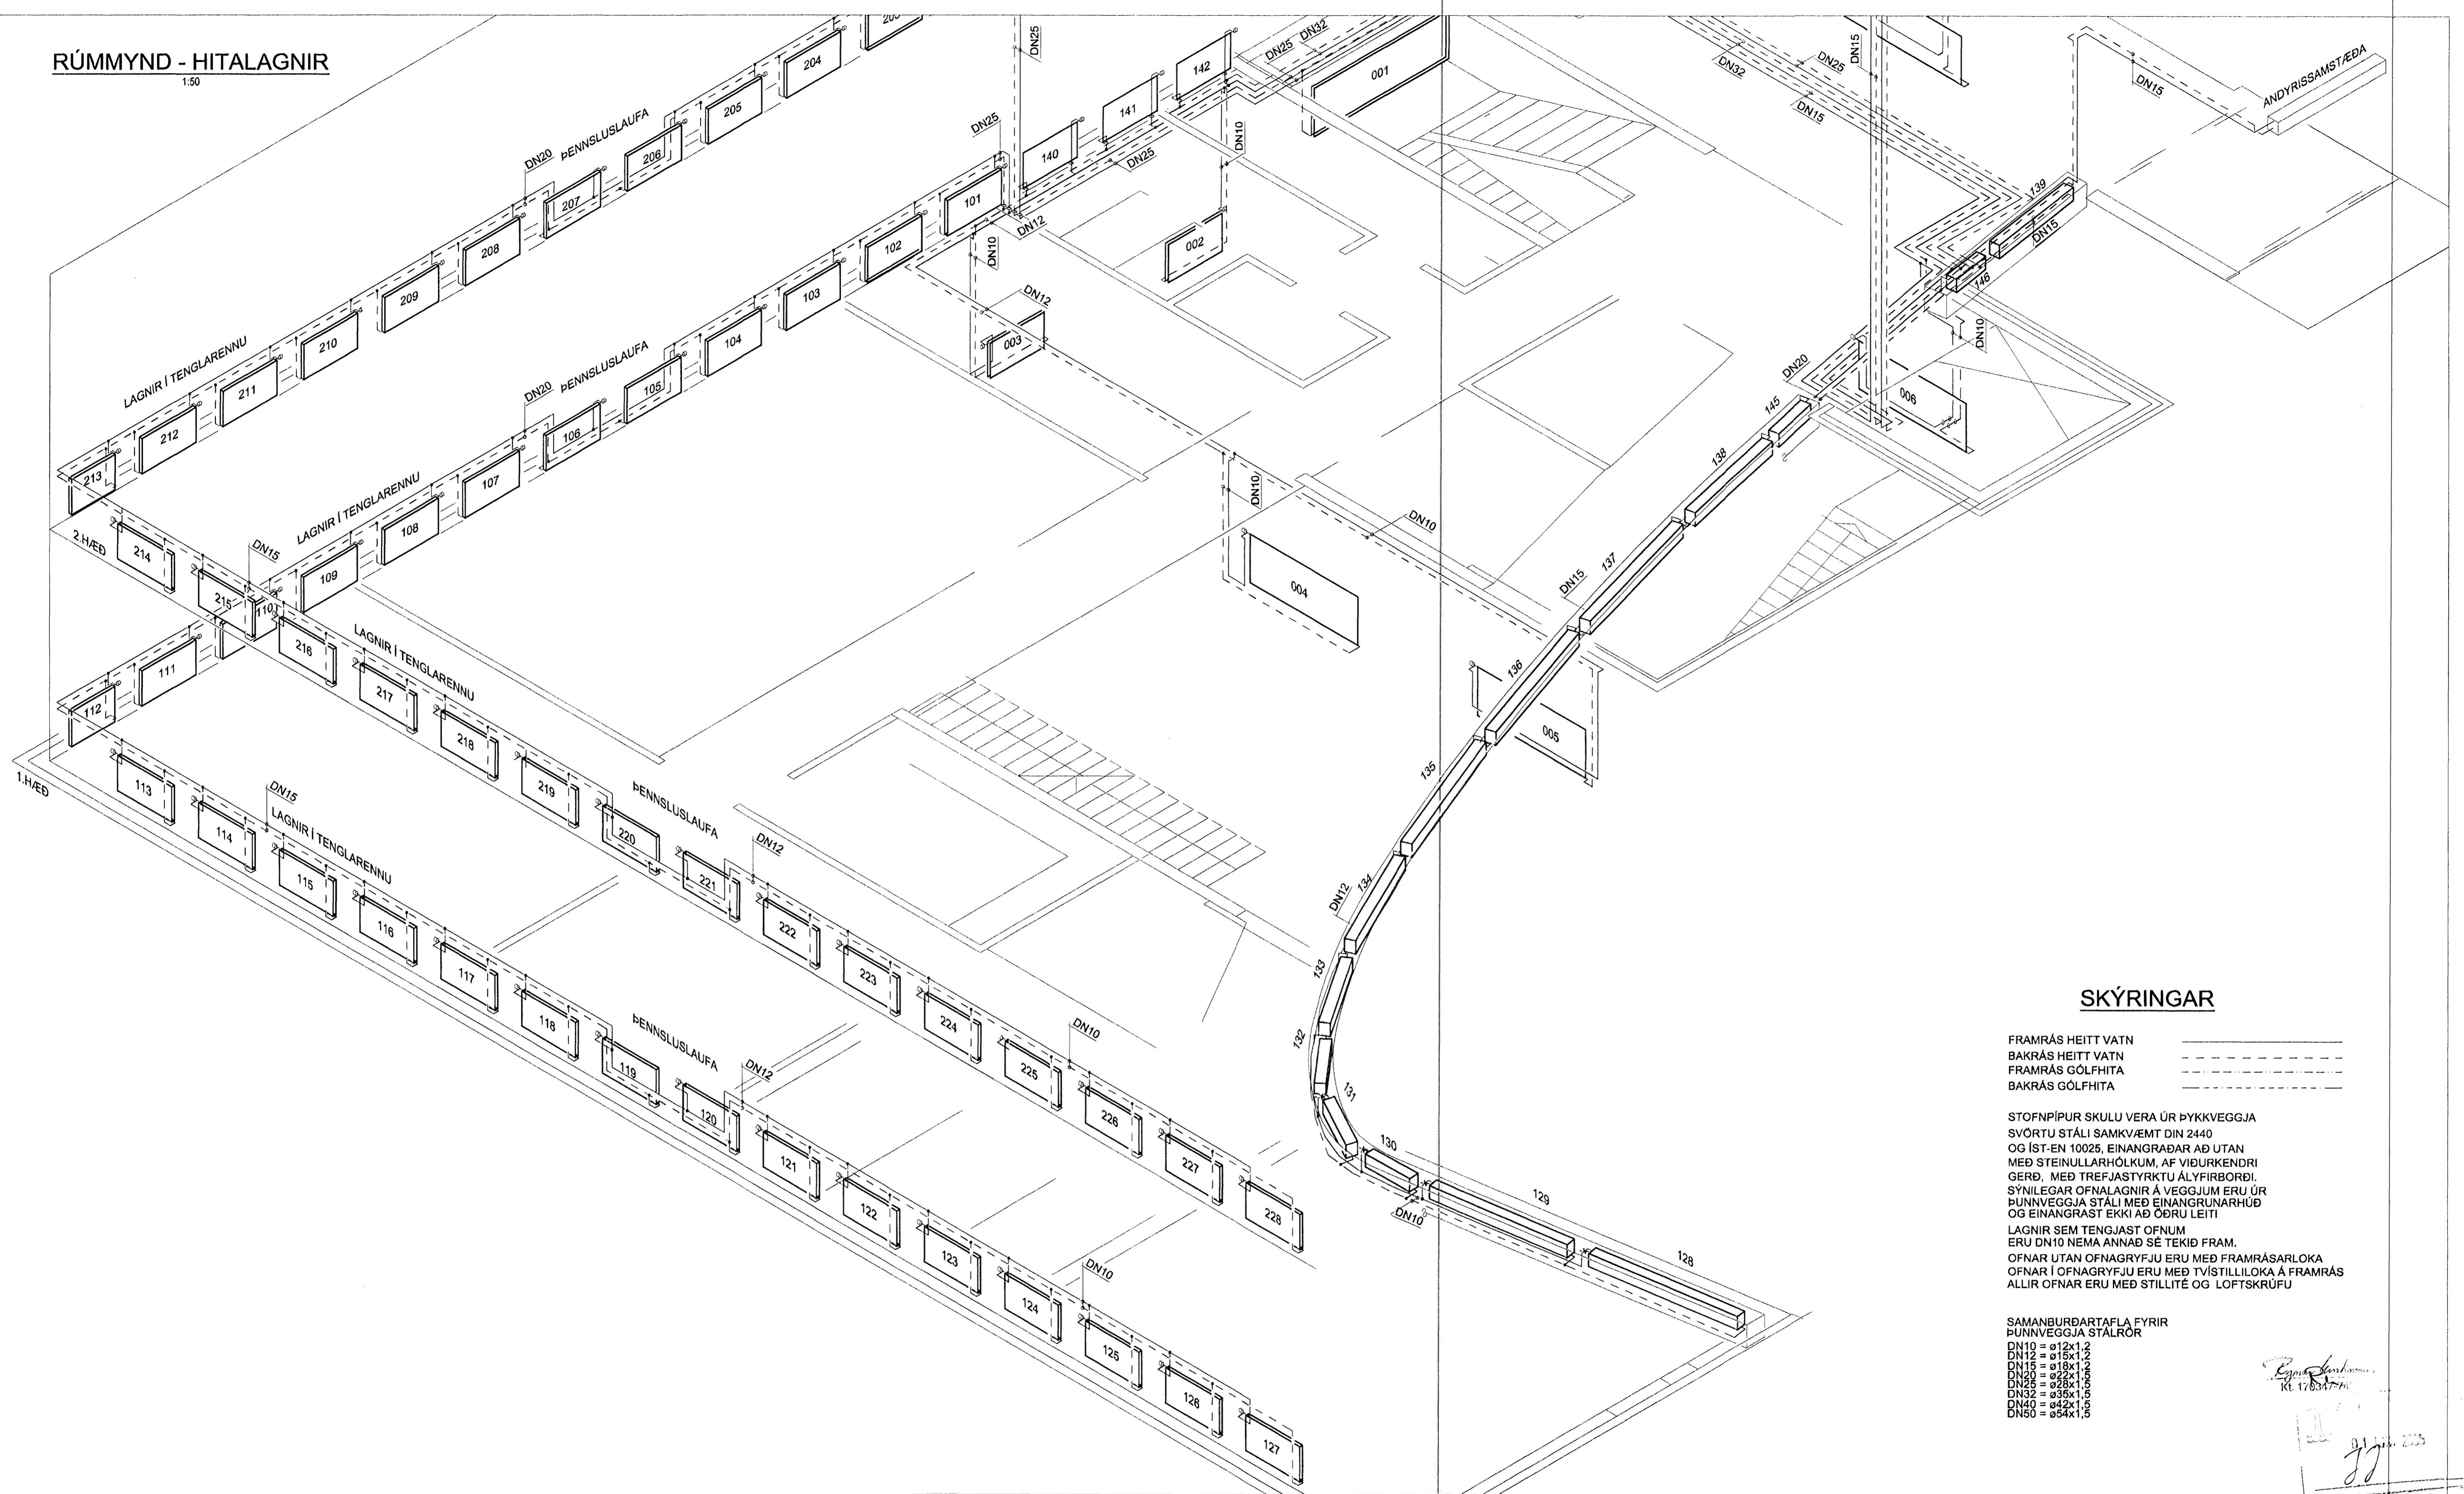

SKÝRINGAR

- FRAMRÁS HEITT VATN \_\_\_\_\_
- BAKRÁS HEITT VATN \_\_\_\_\_
- FRAMRÁS GÖLFHITA \_\_\_\_\_
- BAKRÁS GÖLFHITA \_\_\_\_\_

STOFNPÍPUR SKULU VERA ÚR ÞYKKVEGGJA SVÖRTU STÁLI SAMKV/EMT DIN 2440 OG ÍST-EN 10025, EINANGRADAR AÐ UTAN MEÐ STEINULLARHÓLKUM, AF VIÐURKENDRI GERÐ, MEÐ TREFJASTYRKTU ÁLYFIRBORDI. SÝNILEGAR OFNALAGNIR Á VEGGJUM ERU ÚR ÞUNNVEGGJA STÁLI MEÐ EINANGRUNARHÚÐ OG EINANGRAST EKKI AÐ ÖÐRU LEITI. LAGNIR SEM TENGJAST OFNUM ERU DN10 NEMA ANNAD SÉ TEKID FRAM. OFNAR UTAN OFNAGRYFJU ERU MEÐ FRAMRÁSARLOKA OFNAR I OFNAGRYFJU ERU MEÐ TVIÐSTILLILOKA Á FRAMRÁS ALLIR OFNAR ERU MEÐ STILLITE OG LOFTSKRUFU

SAMANBURDARTAFLA FYRIR ÞUNNVEGGJA STÁLROÐR  
 DN10 = ø12x1,2  
 DN12 = ø15x1,2  
 DN15 = ø18x1,2  
 DN20 = ø22x1,6  
 DN25 = ø28x1,6  
 DN32 = ø35x1,6  
 DN40 = ø42x1,6  
 DN50 = ø54x1,6

*[Handwritten signature]*  
 Kt. 17.03.04  
*[Handwritten initials]*

Skýringar: Explanations:

3	EFTIR FRAMKVEMD	28.09.04	ÓS.
2	OFNUM I OFNAGRYFJU BREYTT	28.01.04	ÓS.
1	VNNUTEIKNING	09.09.03	RK.

Breyt. / Rev.      Breyting / Revision      Dags. / Date      Samp. / Approved      Notk. heiml. / Released

Tilv. teikningar nr. ISAL / Ref. drawing no. of ISAL      Samsetn. teikningar nr. ISAL / Assembly drawing no. of ISAL

Fjöldi stúkkja / Number of pieces		Hlutur / Object		Atrið / Item		Efni / Material		Sv. st. / Weight		Totalt í heild / Total in total		Athugasemdir / Remarks	
IV	III	II	I										
This drawing is the property of the Alcan Iceland Ltd. and handed out for personal use only. It may neither be copied nor made available to others without permission of the Alcan Iceland Ltd. The receiver is liable for any misuse.												Mhl. 94 Stað / Format: A1 Mkv. / Scale: 1:50 Kostn. nr. / Order no.: 4110 01199 AKS no.: UM10 Tekn. nr. / Order of suppl. / Draw. / Rev.: 9K-88 3 Vorkau. / Supplier: VGK CONSULTING ENGINEERS LTD. Tekn. / Drawn: ÓS      Hefir / Checked:      Samp. / Approved:      Draga. / ISAL / Tekn. nr. ISAL / Draw. / Rev.: ISAL Alcan Iceland Ltd      Straumavík / IS-222 Hafnarþorur      ALCAN 168828 3 Tekn. / Drawn:      Vefir / Checked and filed:      Notkun heiml. / Released:	