



VERKJALPI:

actavis
 REYKJAVÍKURVEGUR 80,
 R-RANNSÓKNARHÖS


VERKTEIKNING
 ÚTLIT-NORÐVESTUR

VERK: DAGS: 25.07.2005
 KVARDI: 1:50 TEIKNAD:
 SKRÁ: .DWG

ÚTI INNI
ARKITEKTAR

ÞINGHOLTSSTRETI 27 101 REYKJAVÍK
 Símar 5527660 & 5627660 FAX 5527661
 NETFANG: u@u.is
 VEFBANKI: http://www.u.is
 BALDUR G. SMARSSON ARKITEKTAR F.H.

JÓN ÞÓR ÞORVALDSSON ARKITEKTAR F.H.
 021236-7379
 TEIKNINGANR: **A-R-208** BREYTING: **A**

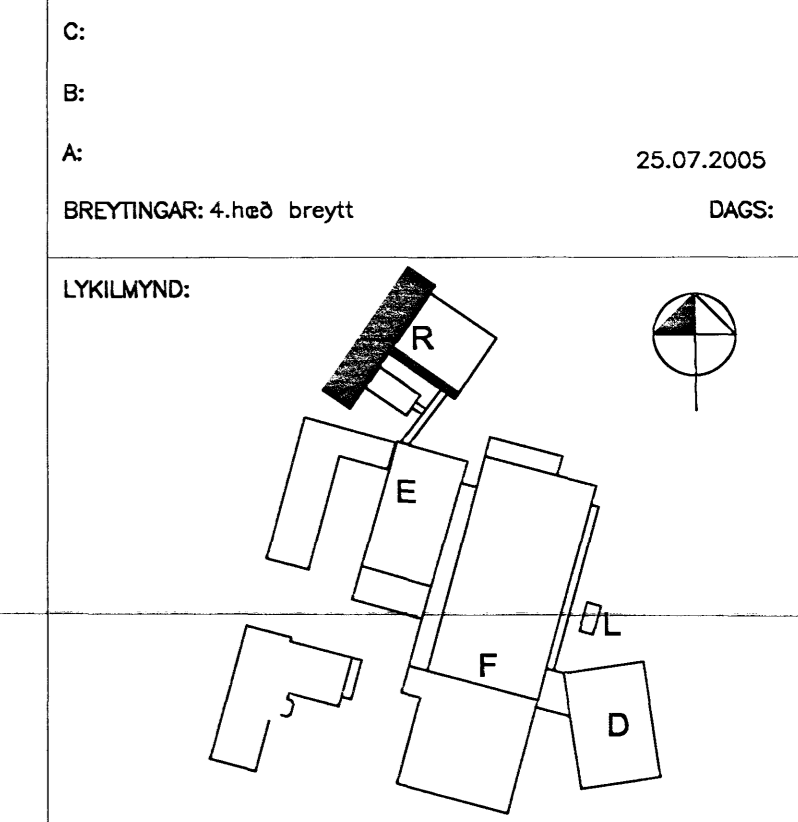

25.07.2005

[Handwritten signature]