

B-B  
20-22

8  
41-02

5-6  
41-02

7  
41-02


A-A  
20-21

5-6  
41-02

8  
41-02

GRUNNMYND 1:50  
1. HÆÐ

B	SS	SS	30.10.2008
Brýting á kjallarauga.			
A	SS	SS	18.09.2008
Lýfustúkkur tengdur.			
GTÓGAFA	TEKNAÐ	SRAMYKKT	10A08
BRÉYTINGAR			

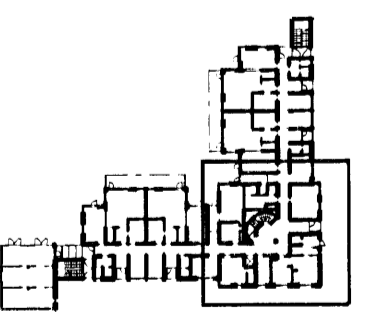

ASK Arkitektar  
 Geirgötu 9  
 101 Reykjavík  
 Sími 515 3300  
 Fax 515 0319  
 www.ask.is



Árþingaráðgjafi:  
*Sigrún Sigrúnardóttir*  
 Sigrún Sigrúnardóttir arkitekt, FAL N. 060767-0819

LEIK OG GRUNNSKÓLI BJARKAVÖLLUM 3  
 VERKTEIKNINGAR

VERK nr.	0736	NUMER TEIKNINGAR	20-03	MAK. 1 A1	1:50
HEITI TEIKNINGAR	Grunnmynd 1. hæðar		TEKNAÐ	ASK	
DAGS	06.09.08		GTÓGAFA	B	