


Gaslögn, sjá teikn. B203 frá Hönnun hf

*: Táknar yfirborðsmælingar í maí 2003

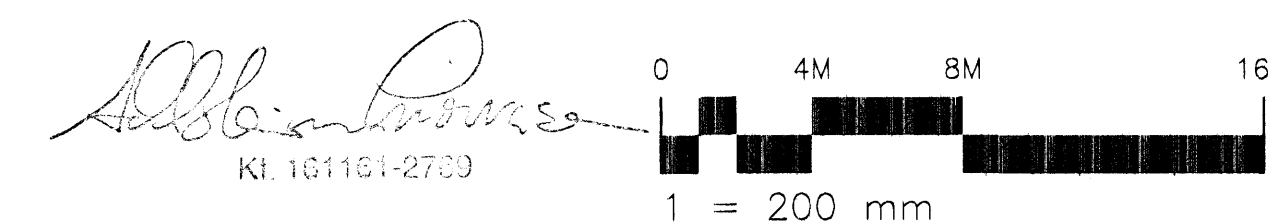

Skýringar:
Explanations:

Breyt. / Rev.	Breyting / Revision	Dags. / Date	Samb. / Approved	Nök. heiml. / Reused
A	Reyndartekningar	05.07.05	SG	
1	Breyttar hæðir	8-12-03	SG	

Tilvitn. / Ref. drawing no. of ISAL: _____
Samsættn. / Assembly drawing no. of ISAL: _____

Fjöldi stúkkja / Number of pieces	Hiður / Object	Atriði / Item	Efni / Material	ea. stak / Weight (kg)	totalt / heild / Þyngd	Afhugsanir / Remarks
IV III II I	Mhl.01 Víkurgata 3 / ál- og tækjageymsla					
	Graftarplan					
	Skýringar					
	Strendingur ehf. verkfræðipjónusta					
	ALCAN PRIMARY METAL EUROPE					
	ISAL Staunsvík					
	ALCAN Iceland Ltd					

Stærð / Format	A1	Máskala / Scale	1:200
Kostnaður / Cost	7510	AKS númer / No.	12094
US33		AKS númer / No.	101
168900		AKS númer / No.	A