
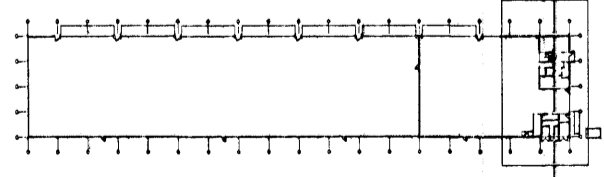


*Alþing*  
Kl. 101101-2703

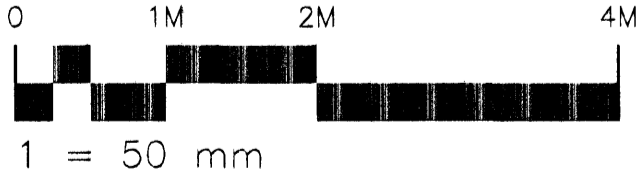

20 JULI 2003  
*[Signature]*

Skýringar:  
Explanations:

Breyt. / Rev.	Breyting / Revision	Dagur / Date	Sömp. / Approved	Nösk. / Released
A	Reyndartekningar	05.07.05	SG	
2	Endurskoðuð göt	15-12-03	SG	
1	Gólfhæð og hæð á götum hákkæð	8-12-03	SG	

This drawing is the property of the Alcan Iceland Ltd. and handed out for personal use only. It may neither be copied nor made available to others without permission of the Alcan Iceland Ltd. The receiver is liable for any misuse.

Fjöldi stykka / Number of pieces	Hlutur / Object	Atriði / Item	Efni / Material	eo:stæ / Weight	total: í heild / Total (kg)	Athugasemdir / Remarks
IV III II I	Mhl.01 Víkurgata 3 / ál- og tækjageymsla					
	Gataplán - sökkjar					
	Grunnmynd 3/3					
	Verkjav / Supplier	Strendingur ehf. verkfræðipjónusta				
	Teknað / Drawn	JW	Prófað / Checked	SG	22.09.2003	Sambærkt / Approved
	ALCAN PRIMARY METAL EUROPE		Straumsvík			
	ISAL		IS-222 Hafnarfordur			
	Teknað / Drawn		Prófað og skilað / Checked and filed			Nöskun heimild / Released

Stað / Scale: A1  
Kostn. nr. / Cost no.: 7510  
ÁKS no.: 12094  
US33  
Tækn. / Drawn: 222  
Dra. no. of ISAL / Tekn. no.: 168914  
Breyt. / Rev.: A