

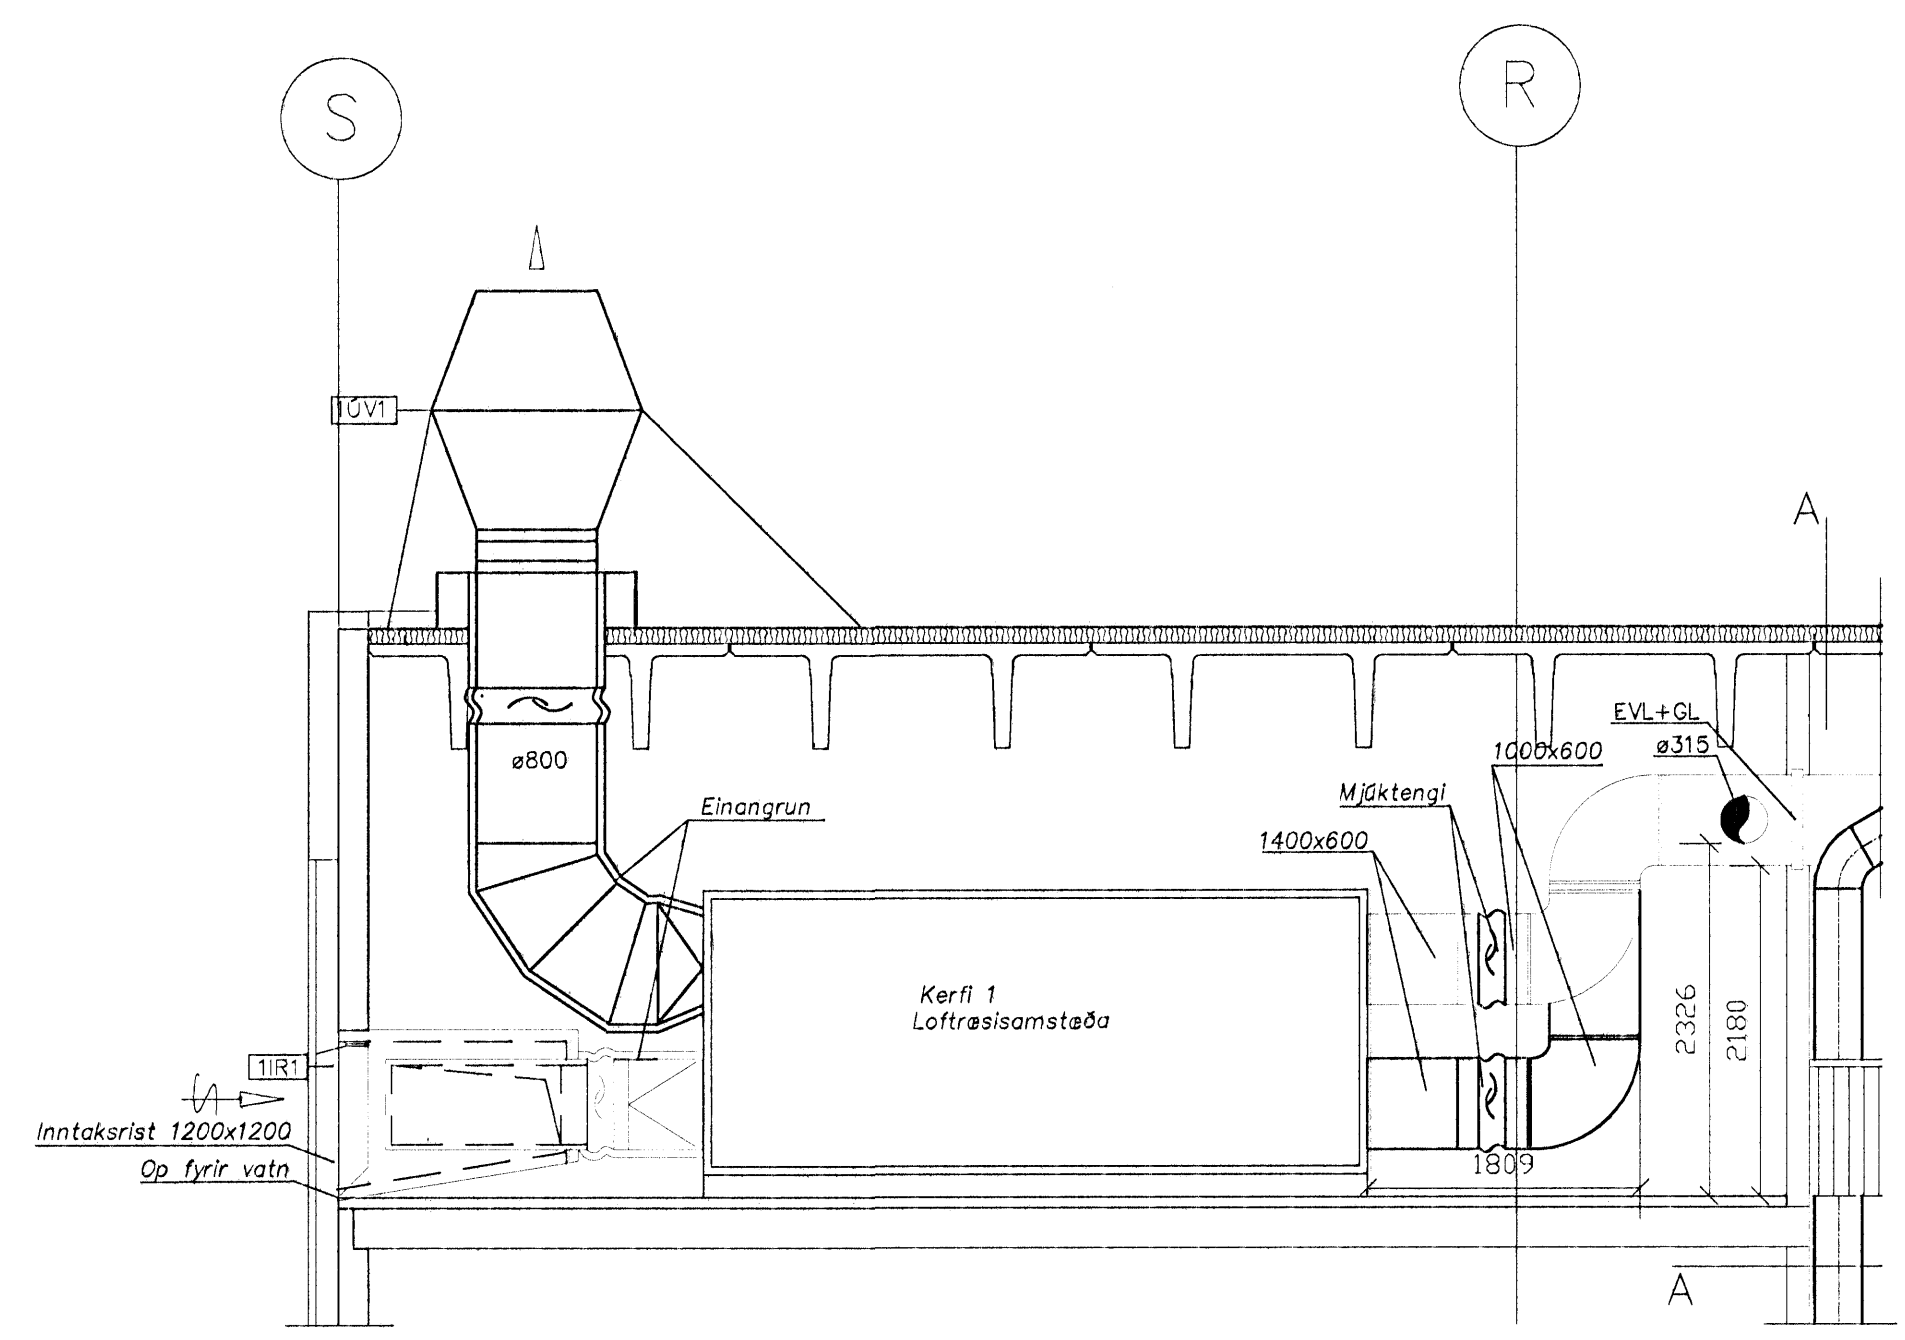


Snið B-B

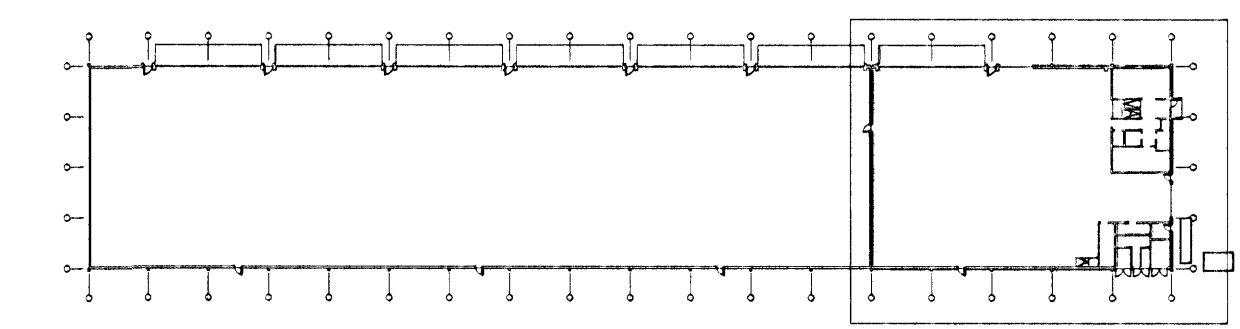


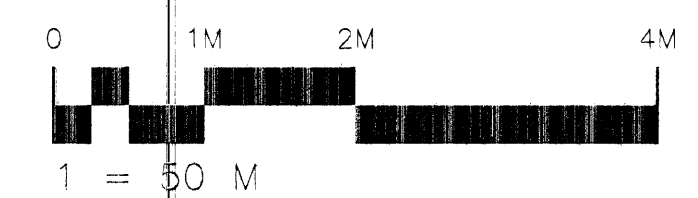

Handwritten signature and date: 2005

Handwritten signature: Alcan

Skýringar:
Explanations:

Revt.	Rev.	Breyt.	Date	Samb.	Appr.	Nok.	Releas.
A		Reyndartekningar	05.07.05	SG			
1		Breyting á ótsogskerfi	22.12.03	SG			

This drawing is the property of the Alcan Iceland Ltd. and handed out for personal use only. It may neither be copied nor made available to others without permission of the Alcan Iceland Ltd. The receiver is liable for any misuse.

Fjöldi stúkkja	Hlutur	Atriði	Efni	ea:stg	totalt í heild	Althugsamerki
Number of pieces	Object	Item	Material	Weight (kg)	Bygging	Remarks
IV III II I	Mhl.01 Víkurgata 3 / ál- og tækjageymsla					
	Loftrésing					
	Snið					
	Strendingur ehf. verkfræðipjónusta					
	ALCAN PRIMARY METAL EUROPE					
	ISAL					
	IS-222 Hafnarþorur					

Starfsnúmer / Draw. no.: 7510 12094
 Msk. / Scale: 1:50
 Afskrá / Rev. no.: US33
 334
 168933
 A