


SUÐUR

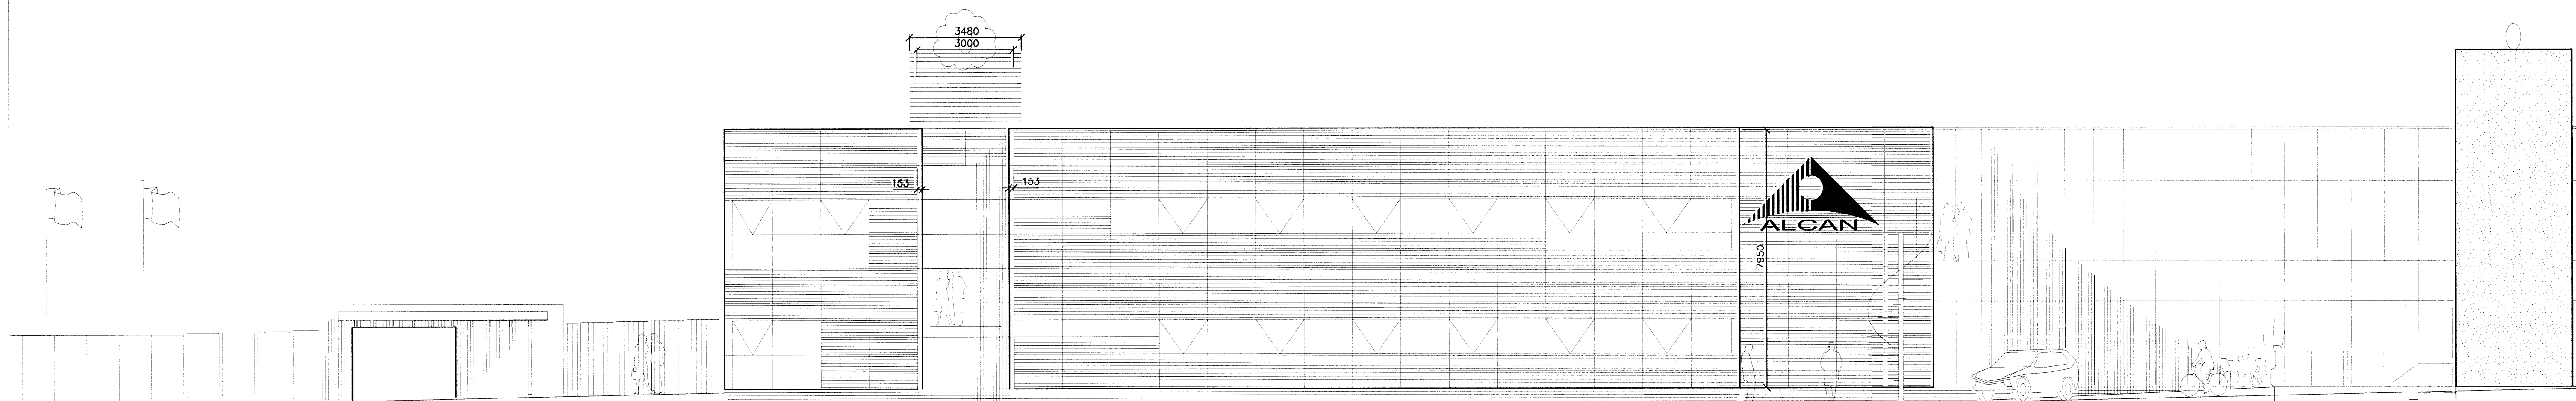

NORÐUR

*J. Jónsson*

Skýringar:  
Explanations:

INGIMUNDUR SVENSSON  
JÓHANN EINARSSON  
ÓLAFUR ÓSKAR AXELSSON



**Ingimundur Sveinssonar**  
Tæknistofa  
Ingólfsstráti 3  
101 Reykjavík  
Sími 5204900  
Fax 5204901  
tís @ tís.is  
www.tís.is

Breyt. Rev.	Daggs. Date	Samb. Approved	Nötk. heimil. Released
B	140909	140909	
A	211105	211105	
2	130104	130104	
1	010703	010703	

Tilvitnæðing nr. ISAL  
Ref drawing no. of ISAL

Samsættning nr. ISAL  
Assembly drawing no. of ISAL

This drawing is the property of the Alcan Iceland Ltd. and handed out for personal use only. It may neither be copied nor made available to others without permission of the Alcan Iceland Ltd. The receiver is liable for any misuse.

Fjöldi stúkkja Number of pieces	Hlutur Object	Atriði Item	Efni Material	eo. stik Weight (kg)	totalt held Total weight	Athugasemdir Remarks
IV III II I	SKRIFSTOFUHÚS ALCAN VIKURGATA 3 ÓTLIT	Mnl. 01				
	Vertikal / Supplier	Tæknistofa Ingimundur Sveinssonar ehf				
	Teknað / Drawn	JE 01072003	Yfirfarið / Checked	JE 01072003	Sambýkt / Approved	JE
					ISAL Straumvirk Alcan Iceland Ltd IS-222 Hafnarfróður	Dr. no. of ISAL / Tekn. nr. ISAL
					163606	B
						Stað Format A1 Mkv. Scale 1:100 Kostn. nr. -bú. nr. / Óbno.-Eq. no. 12093 AKS no. UM10 Tekn. nr. vertika / Dr. no. of suppl. Breyt./Rev. 606
						Nötkun heimilid / Released