



16/6 '10 JL

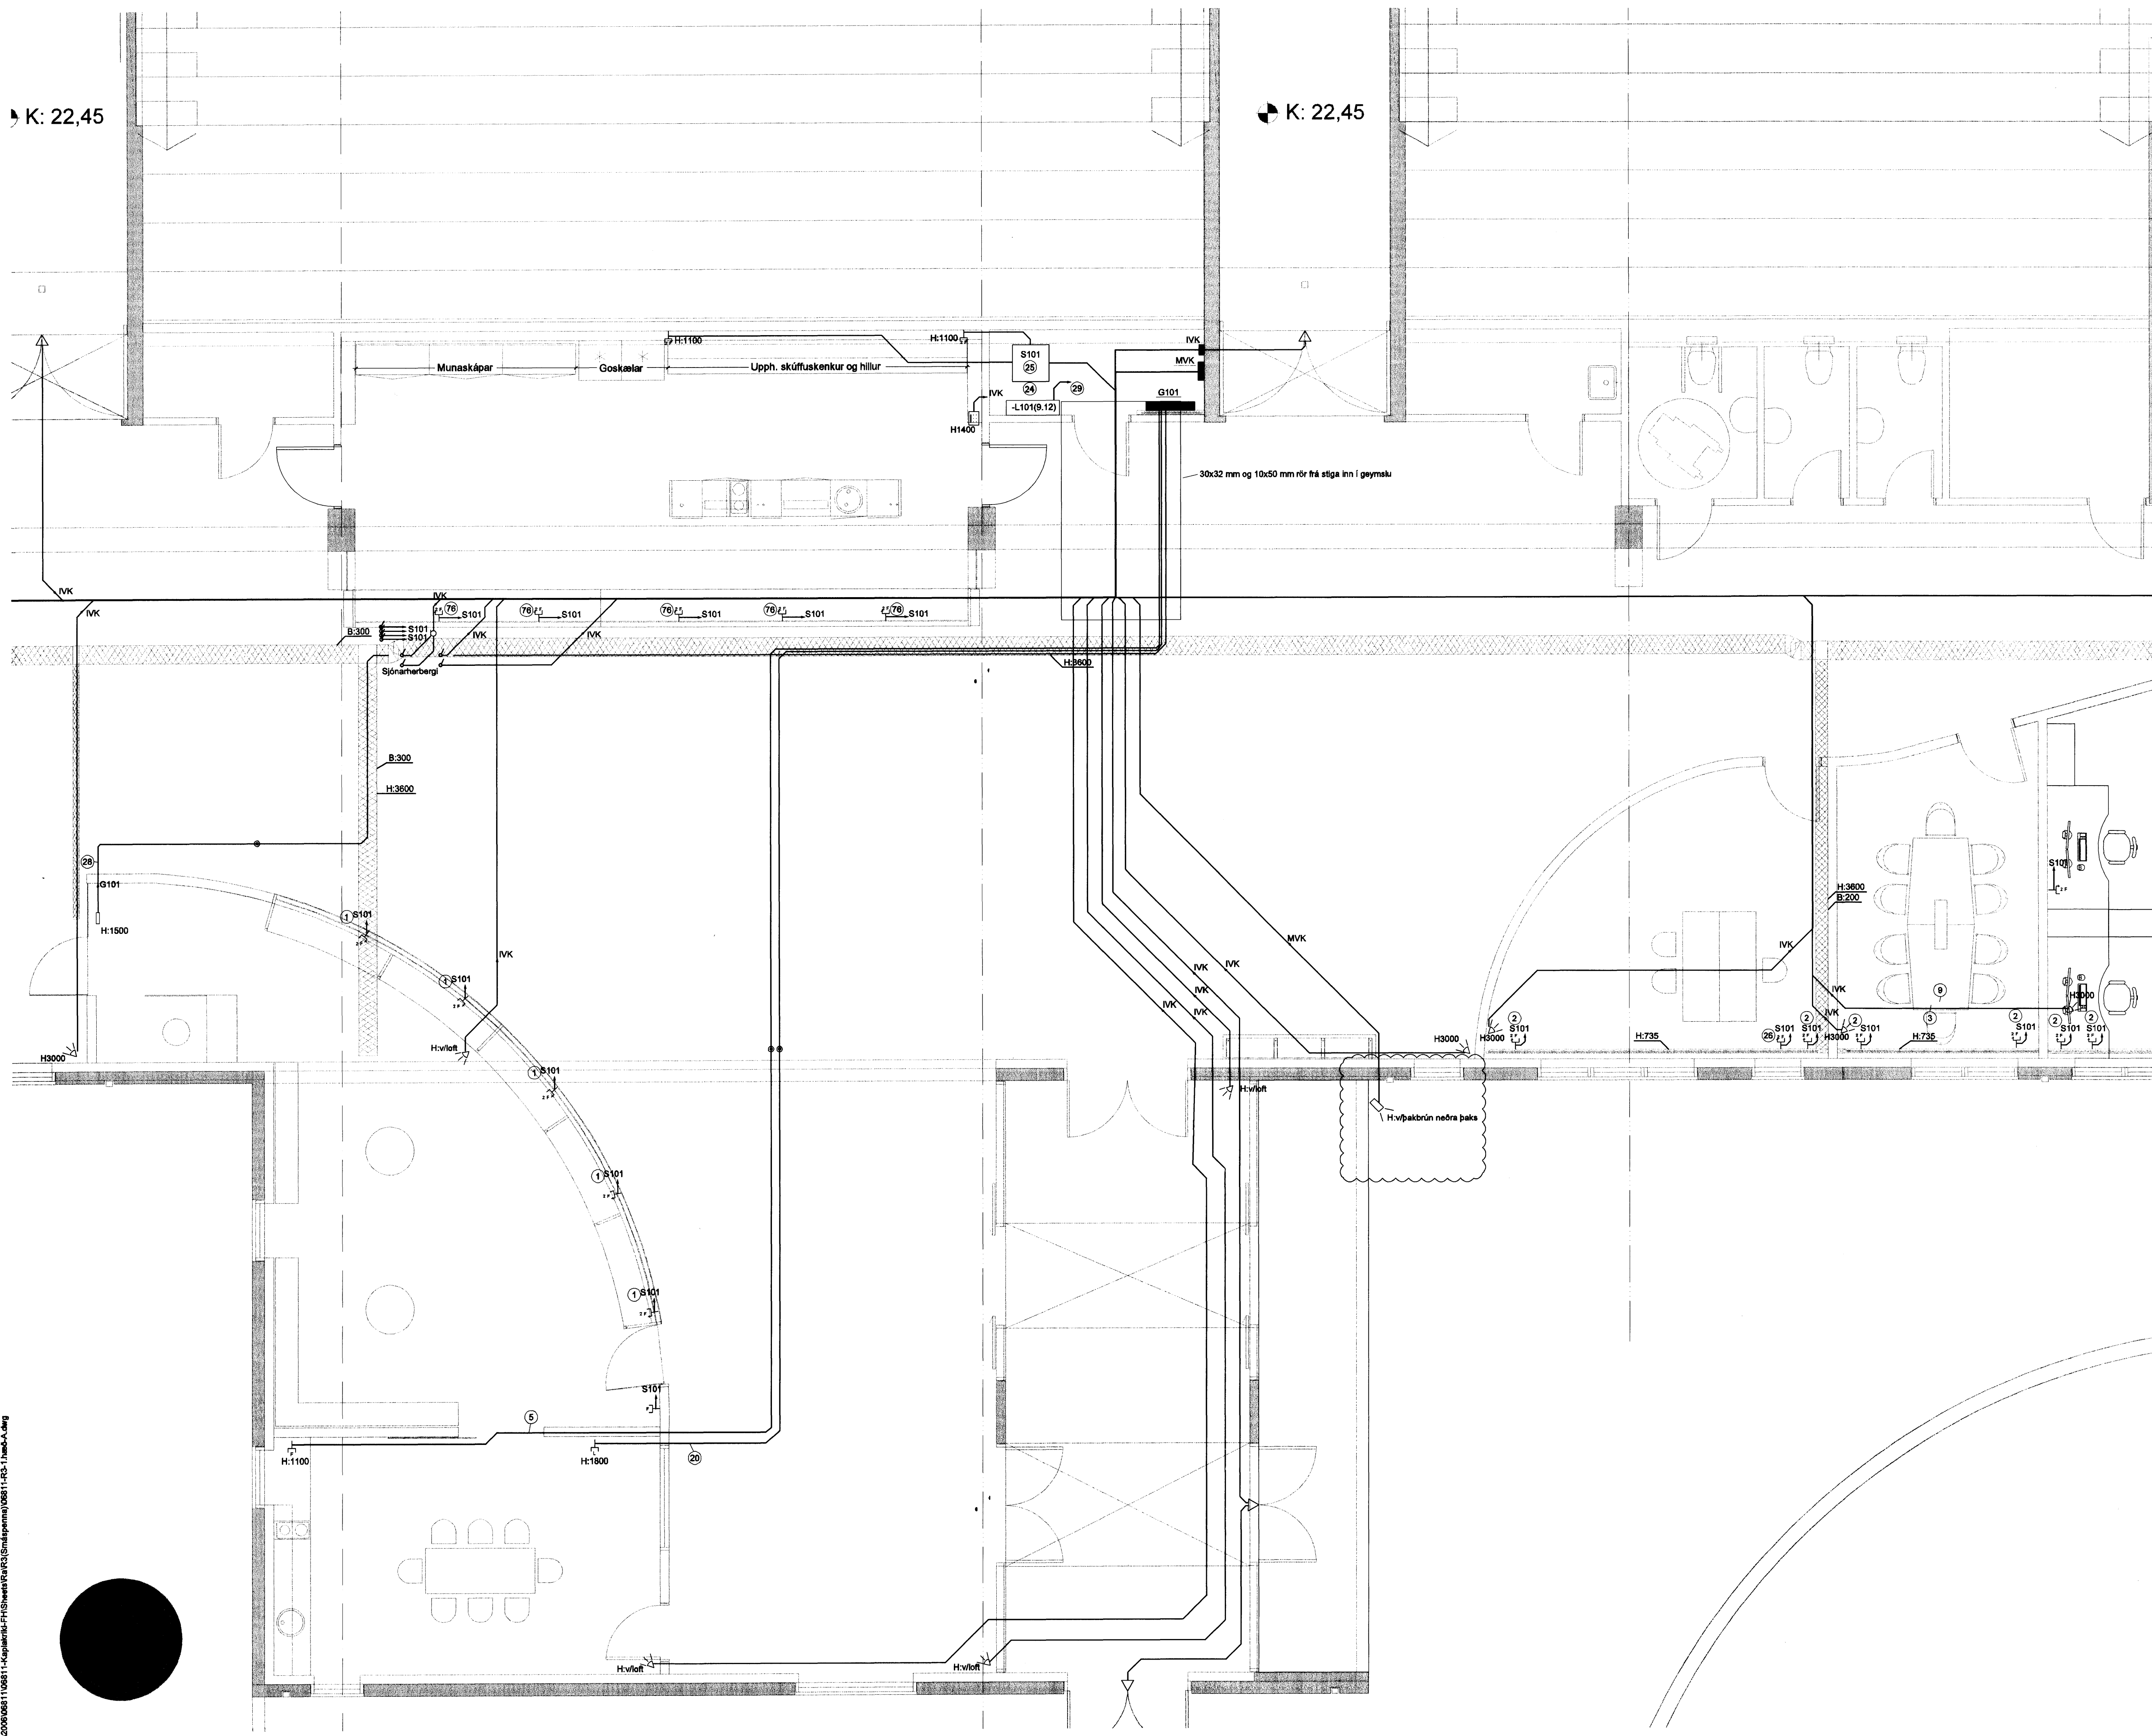

[Signature]
 KAPLAKRIKI 110457-2789

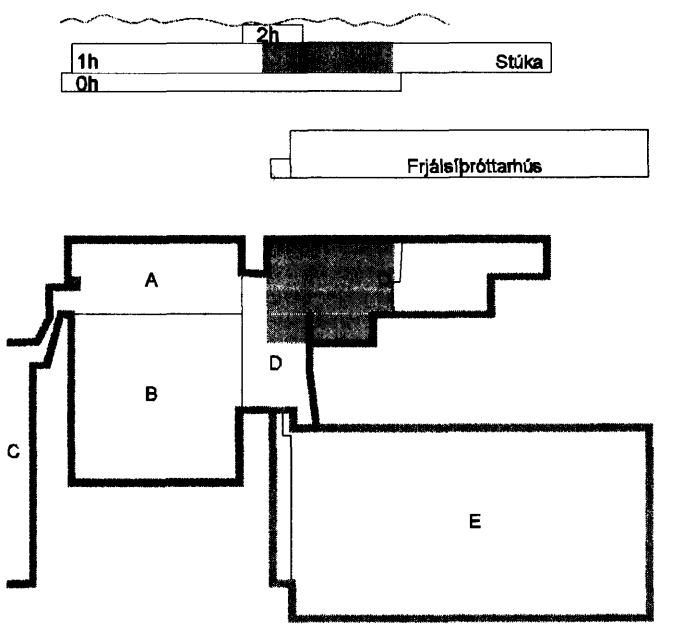

D	15.06.10	Myndavélaferill	BSG/ÓG
C	14.01.10	Innbrotavöðrunarkerfi	BSG/ÓG
B	12.06.09	Ný varslun, breytt herbergi	SF/BSG
A	27.11.07	Verkefning	RVK/HJ
Útg. Daga.	Skýring		Hannað/Yfirráð



VERKFRÆÐISTOFA
 BÚEJARIHRAUN 20 · 220 HAFNARFJÖRÐUR · KENNIT. 710796-2890
 veb@vab.is · Sími 585 8600 · Fax 585 9610 · www.vab.is

Artun sérhönnuðar
 Örn Guðmundsson Kt: 220961-2739 *[Signature]*

Verkefni
KAPLAKRIKI
HAFNARFIRÐI

Verkefni
 Rafkerfi
 Smáspenna 1.hæð
 Grunnmynd

Hannað	Teknað	Yfirráð	Kvarði	Síða
RVK/HJ	RVK/HJ	RVK	1:50	/ A1
Daga.	Verkefni	Tekning	Útgáfa	
30.04.2007	06811	A R313	D	

V:\20060681\06811-KaplaKriki-FH\nefndar\RS(Smáspenna)\06811-R3-1-hæð-A.dwg