
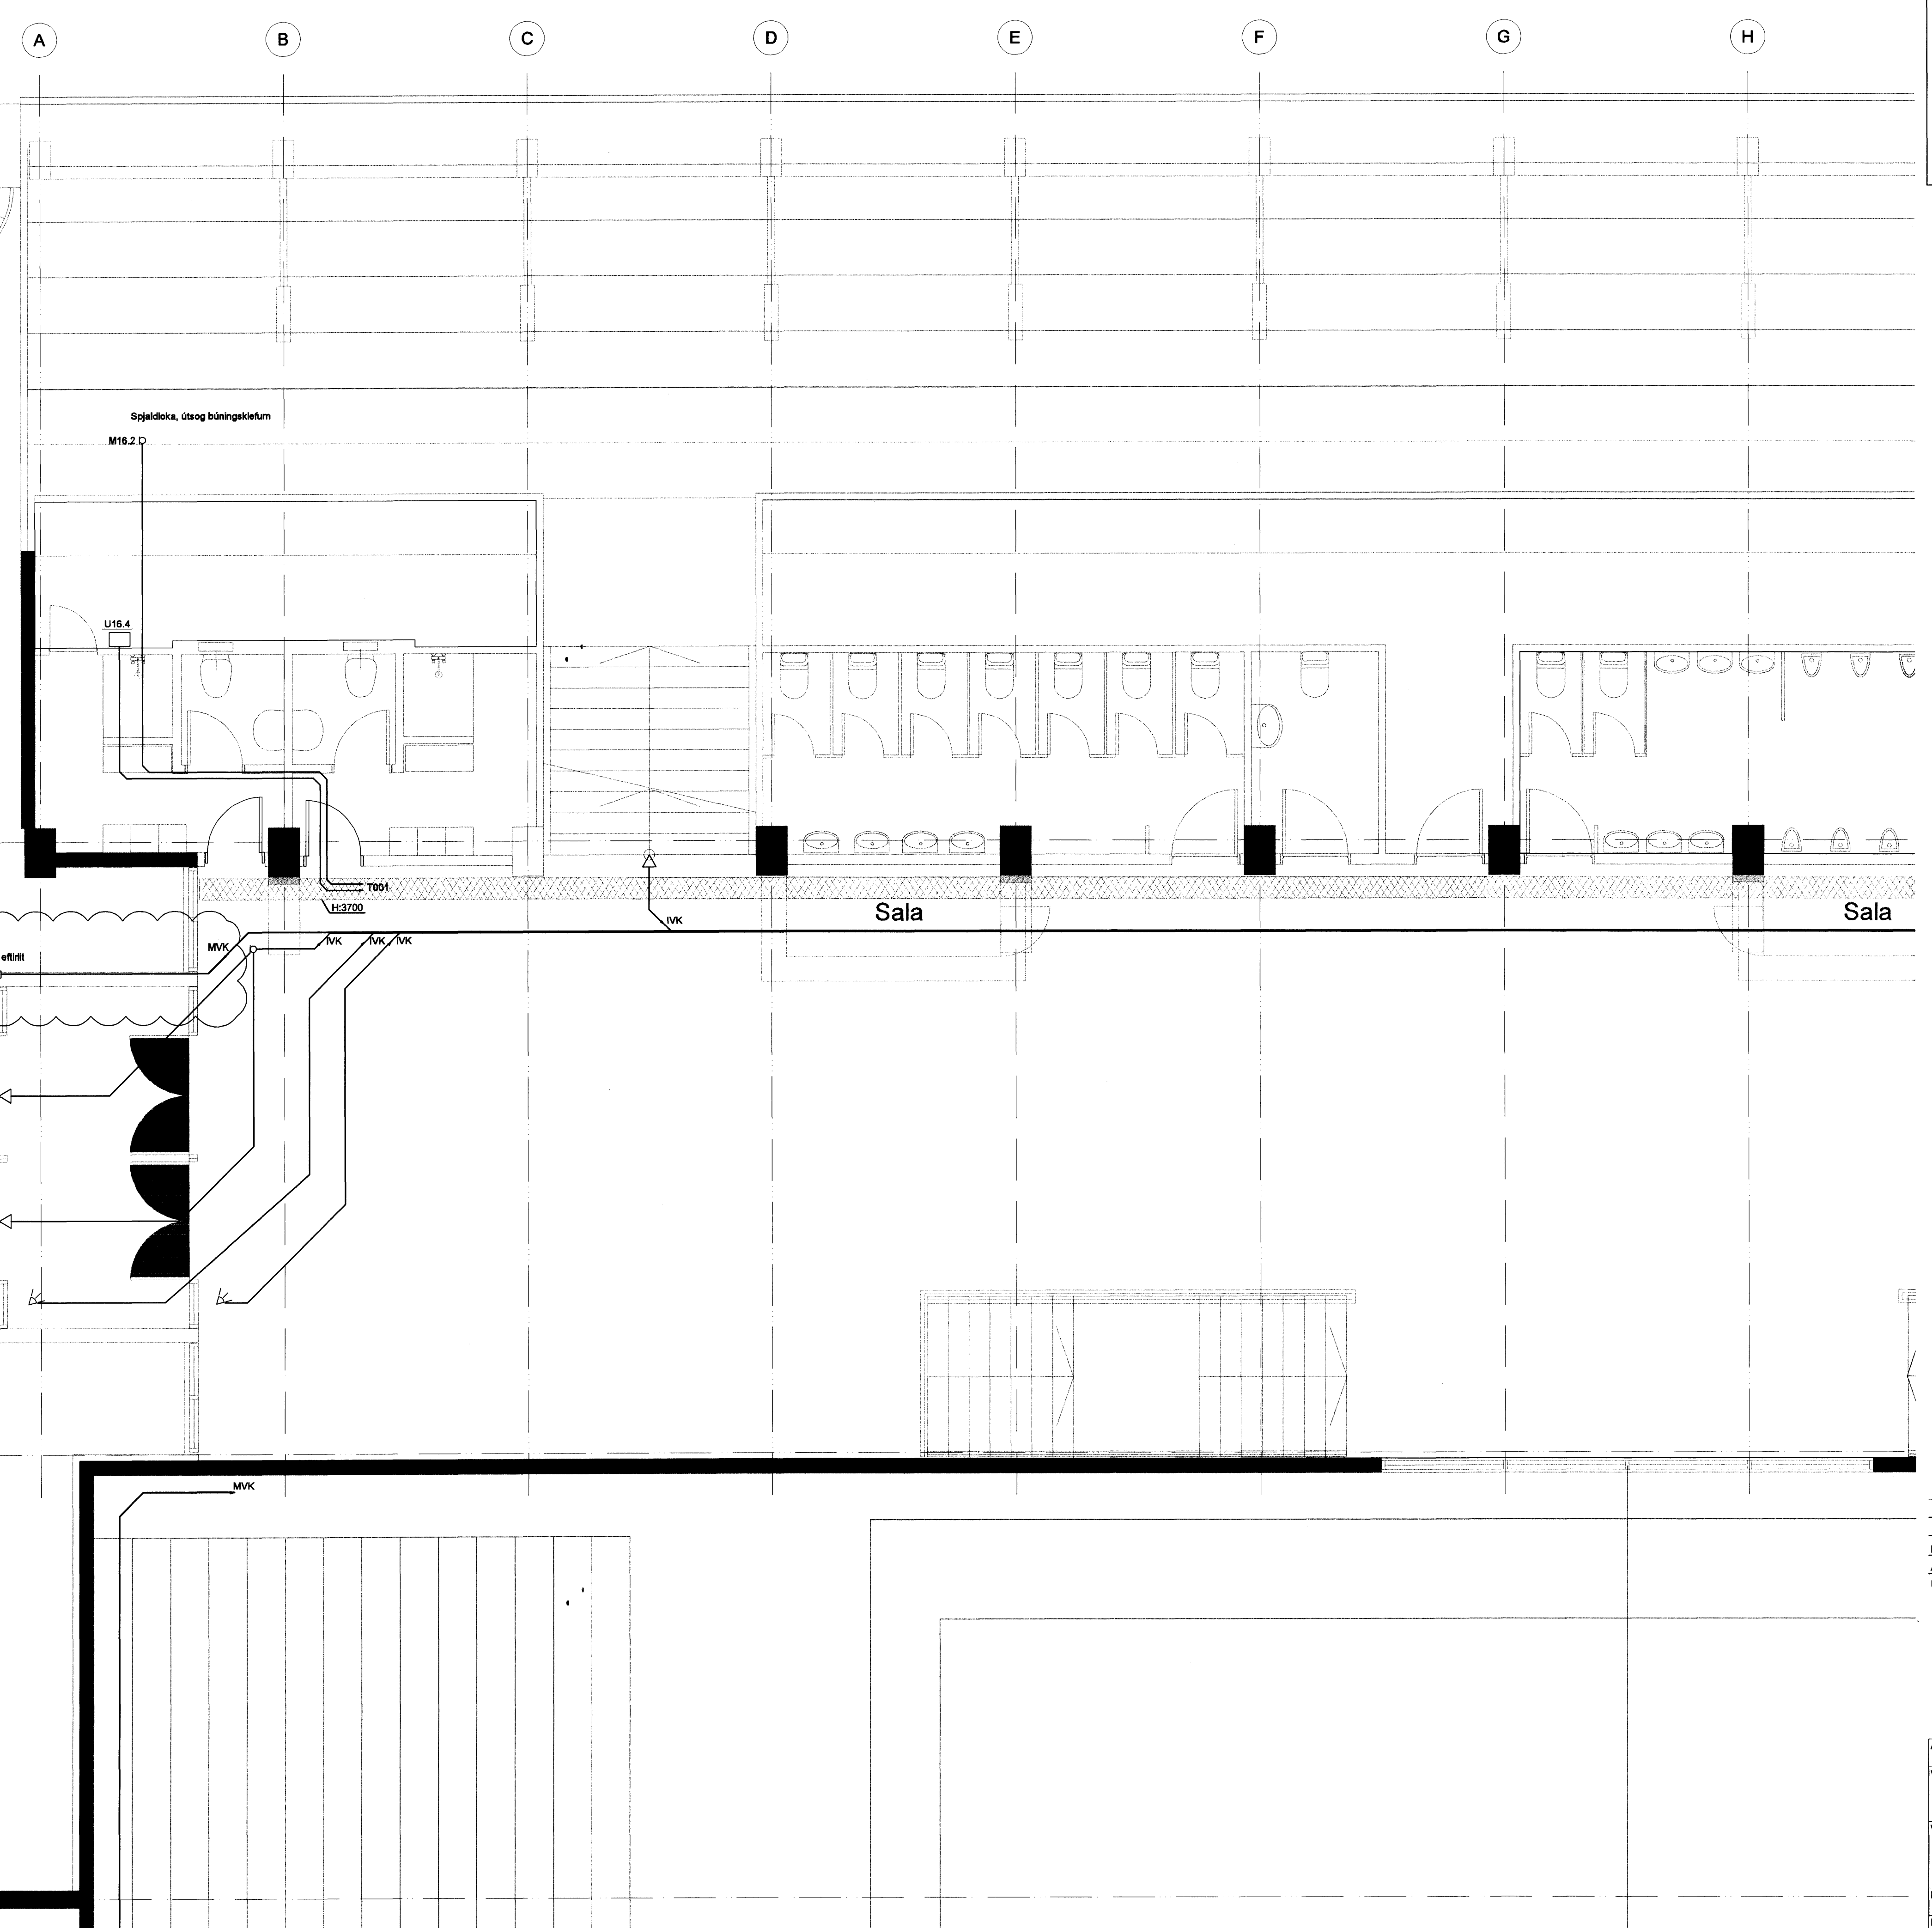


16/6 '10 H

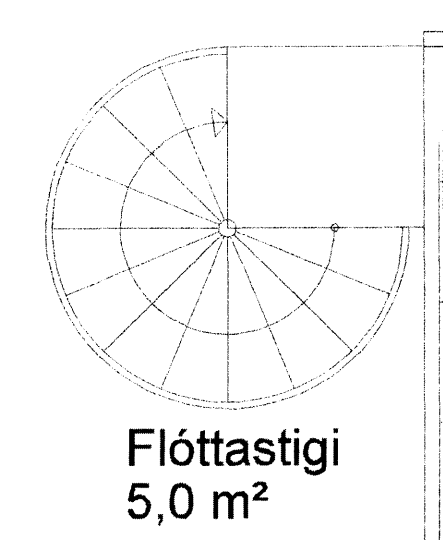


B I

1

2

3

[Signature]
KAPLAKRIKI
Kf. 110457-2789

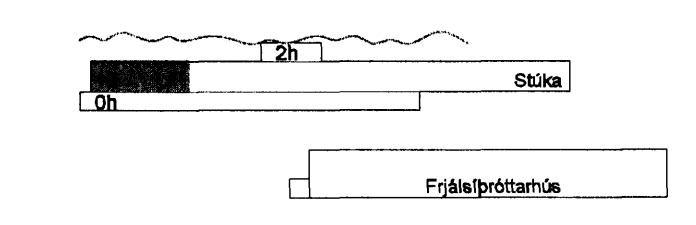

B	15.06.10	Myndavéltakart	BSQ/OG
A	14.01.10	Innertavélvörðunartart	BSQ/OG
Útg.	Dags.	Skýring	Hannaó/Yrjarló

VS
VERKFRÆDISTOFA

BÆJARHRAUN 20 · 220 HAFNARFJÖRÐUR · KENNIT. 710796-2899
vab@vab.is · Sími 655 8600 · Fax 565 8610 · www.vab.is

Artun sérhönnuðar Örn Guðmundsson Kf: 220961-2739 <i>[Signature]</i>				
Verkefni KAPLAKRIKI HAFNARFIRÐI				
Verktíu Rafkerfi Smáspenna 1.hæð Grunnmynd				
Hannaó	Teknaó	Yrjarló	Kvæði	Síða
RVK/HJ	RVK/HJ	RVK	1:50	/A1
Dags.	Verkefni	Tekning	Útgáfa	
06.10.08	06811	A R311	B	

V:\2008\06811\06811-KaplaKriki\FH\Sheets\RFK3(Smáspenna)\06811-R3-1.hæð-A.dwg