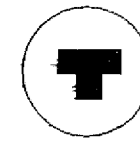
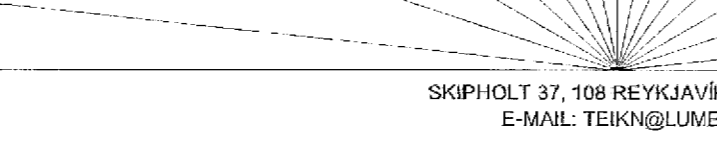


Inntök samþykkt 14/8 20 02.  
 f.h. HITAVEITU SUDURNESJA h.f.  
*Birgir Dasbjarb.*

GRUNNMYND 1. HÆÐ

4361


**HELGI KR. EIRÍKSSON RAFLAGNAHÖNNUN**  
*Helgi Kr. Eiríksson*  
 KT. 110156-2789


**SKIPHOLT 37, 108 REYKJAVÍK S:568-8388**  
 E-MAIL: TEIKN@LUMEX.IS

DAGS.	17.07.2002	SÍÐA NR.	1 AF 6	HANNAÐ	HKE	VERKEFNI	ERLUÁS 41
TEIKN. NR.	AR-01	TÖLVUHEITI	GRERLUAS41	TEIKNAD	PHS	RAFLÖGN	RAFLÖGN
VERKHLUTI	GRUNNMYND 1. HÆÐ	BREYTING A		YFIRFARID	HKE		
MKV.	1:50	BREYTING B					