


A Geymslugluggi ferður. UEF SS 27.08.2013

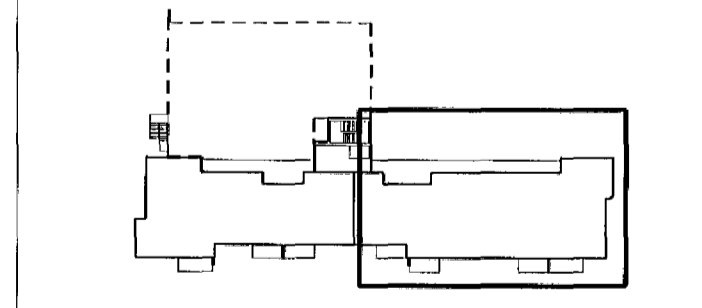

ARKITEKTAR SÍF  
SÍM 515 0309 FAX 515 0319  
www.ark.is

ARTUN ABALHÖNDLUNGAR

*Sigvaldur Sigurðsson*  
ARKITEKTAR

VERKJENI	SKIPALÓN 1 HAFNARFIRÐI	MIJL. 1: A1
FRÓÐGÆTUN	VERKTEIKNING	MIJL. 1: 50
HÉTTI TERNINGAR	UEF	SS
GRUNNMYND 1.HÆÐ	SS	SS
DATE	16.11.2012	OTIÁFA
VERKJENI	0779	ALGJAFI - NÚMÉR TERNINGAR
		20-04
		A