
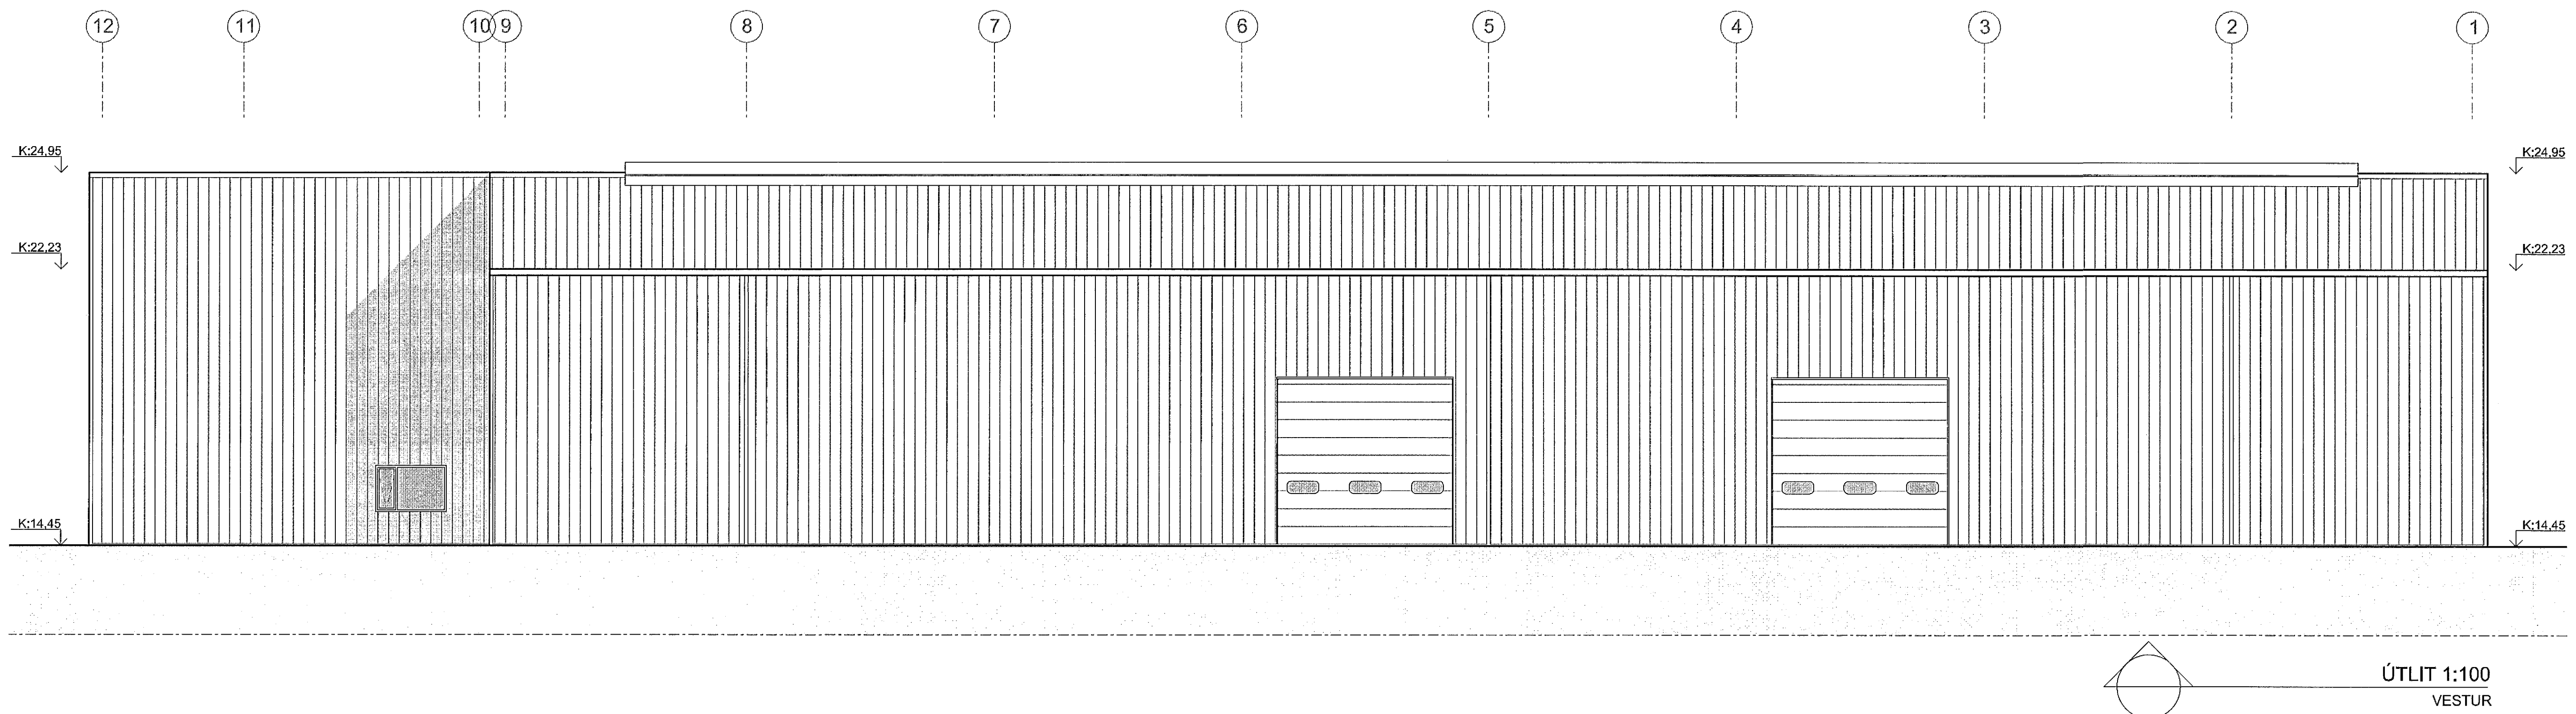


Upprunalegur hönnuður:
FORM + RYMI
Björgvín Snæbjörnsdóttir, Arkitekt F.A.I.

Þessi aðalteikning er unnin sem reyndarteikning,
*eins og byggt.

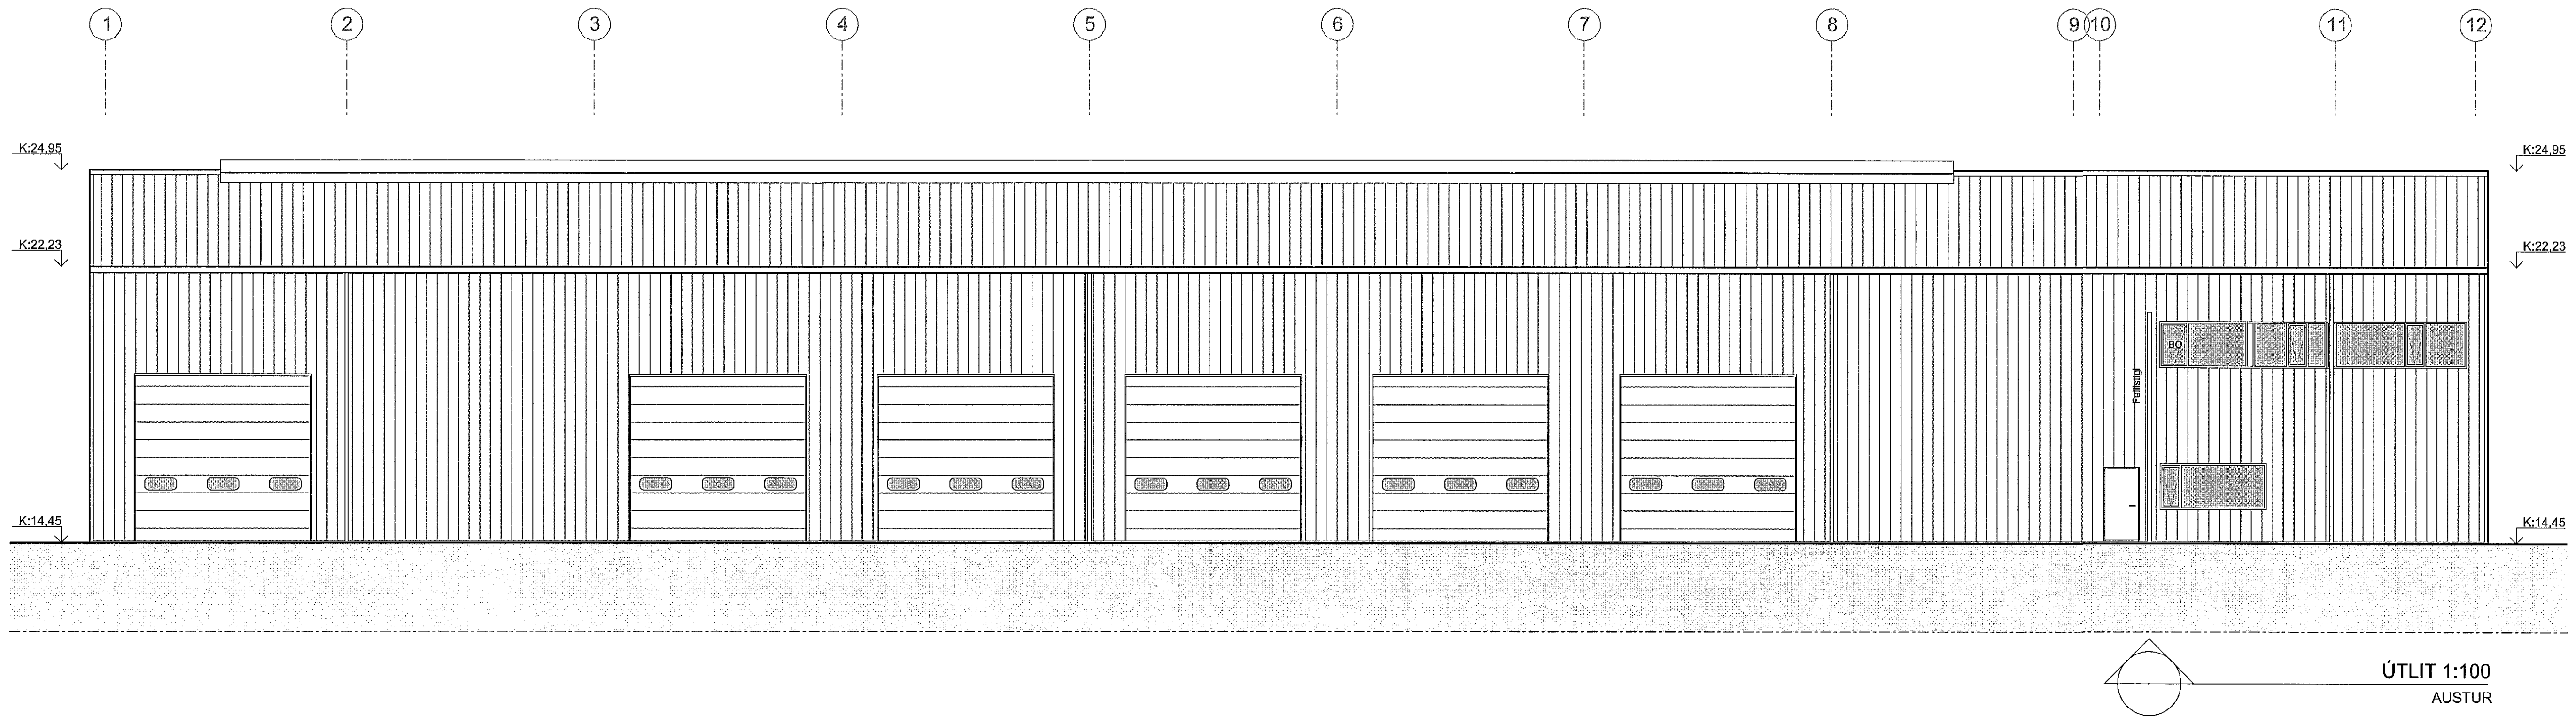

ÚTGAFA
ÚRKYTUNGAR

ASK ARKITEKTAR EHF.
SÍM 515 0300 FAX 515 0319
www.ask.is

ÁRTUN ABALHÖNNUNAR

Helgi Mír Halldórsson Arkitekt F.A.I. helgim@ask.is



VERKFRNI	1337	ÚTGAFA	10-06
ISHELLA 10 220 HAFNARFJÖRDUR	HEITTEIKNING ÚTLIT AUSTUR OG VESTUR	SKALA 1:100	FRMHI
ÚTGAFA	14.10.2013	ÚTGAFA	10-06

HEILBRIGÐISEFTIRLIT
HAFNARFJÖRDUR
OG KÓPAGOGSSVÆÐIS

20.11.2013
(Signature)