


GRUNNMYND VATNS 1:50



GRUNNMYND HITA 1:50

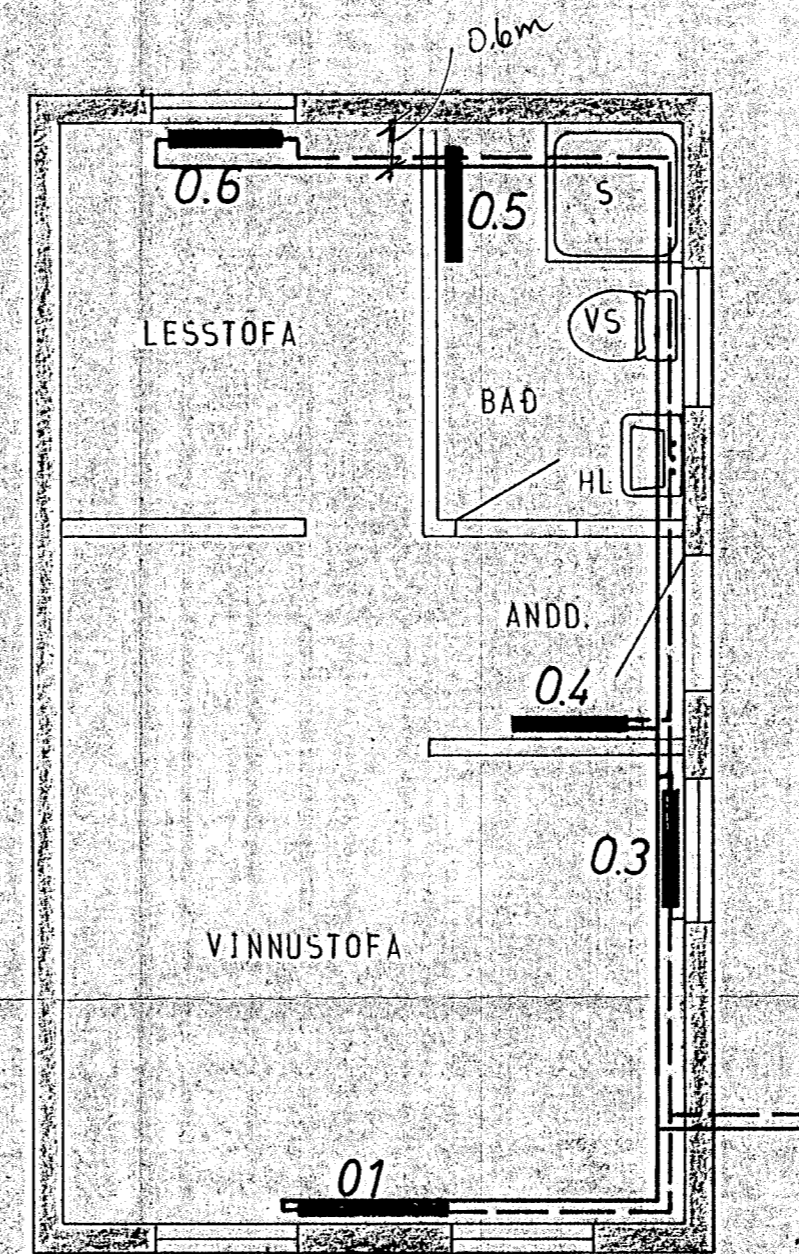

SKÝRINGAR SJÁ TEIKN. NR. 2.0
ÖFNASKRÁ SJÁ TEIKN. NR. 2.3

LÆKJARGATA 8, HAFNARFIRÐI	MÆLIKVARDI: 1:50	VERK 7916	TEIKN NR 2.2
VATNSLÖGN — HITALÖGN	Hannað: <i>SB</i> Teiknað: <i>GP</i>	Yfirrit: <i>SB</i> Samb:	DAGS OKT. '79
JÓHANN GUNNAR BERGÞÓRSSON VERKFR. MVFI STRANDGÖTU 11 — HAFNARFIRÐI — SÍMI 53315	BREYTT Sept 80		