
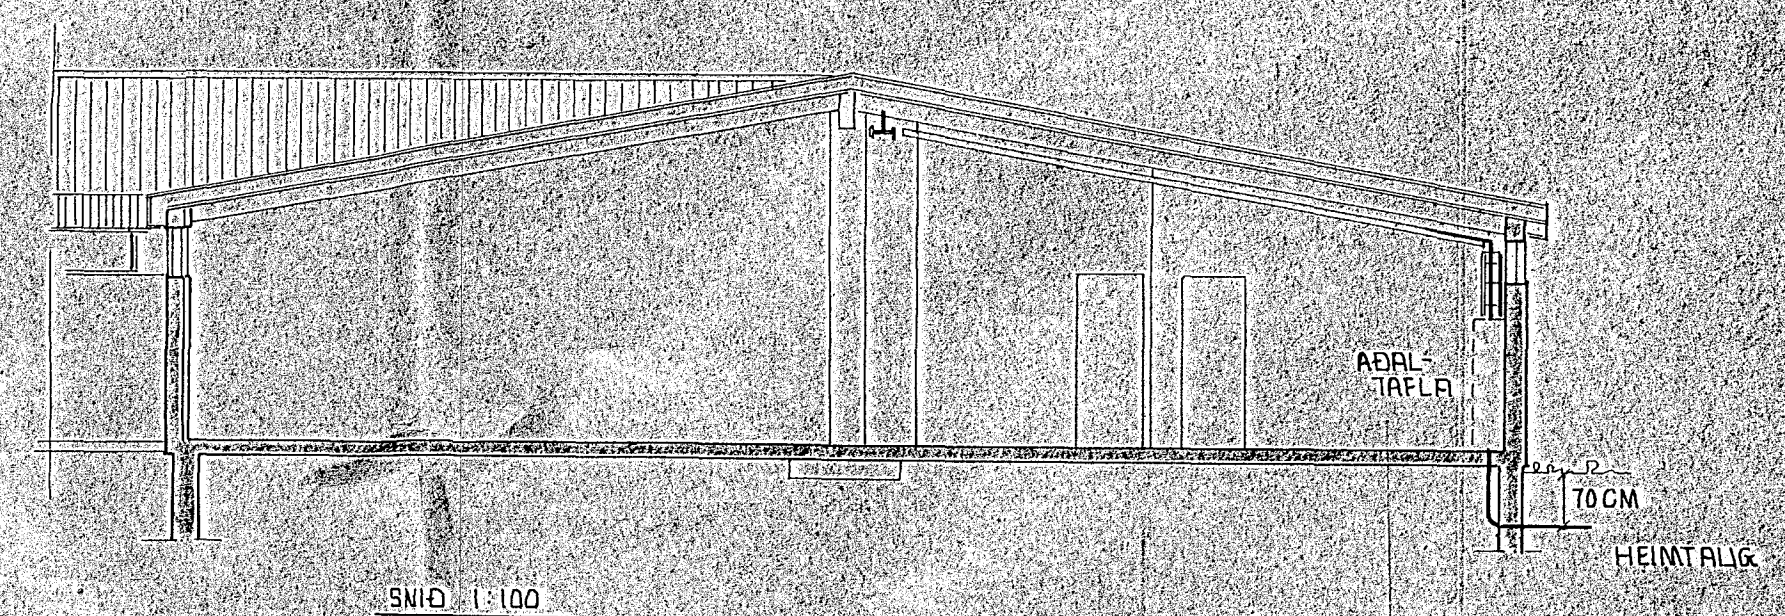


10.12.1986
 SINDYKKT
 VEONA FULNADARFAGANGS
Ólafur Ólafsson
 TÆKNIPJÓUSTAN SF
 Inntök samþykkt 10.11.1986
 TÆKNIPJÓUSTAN SF
 Ólafur Ólafsson

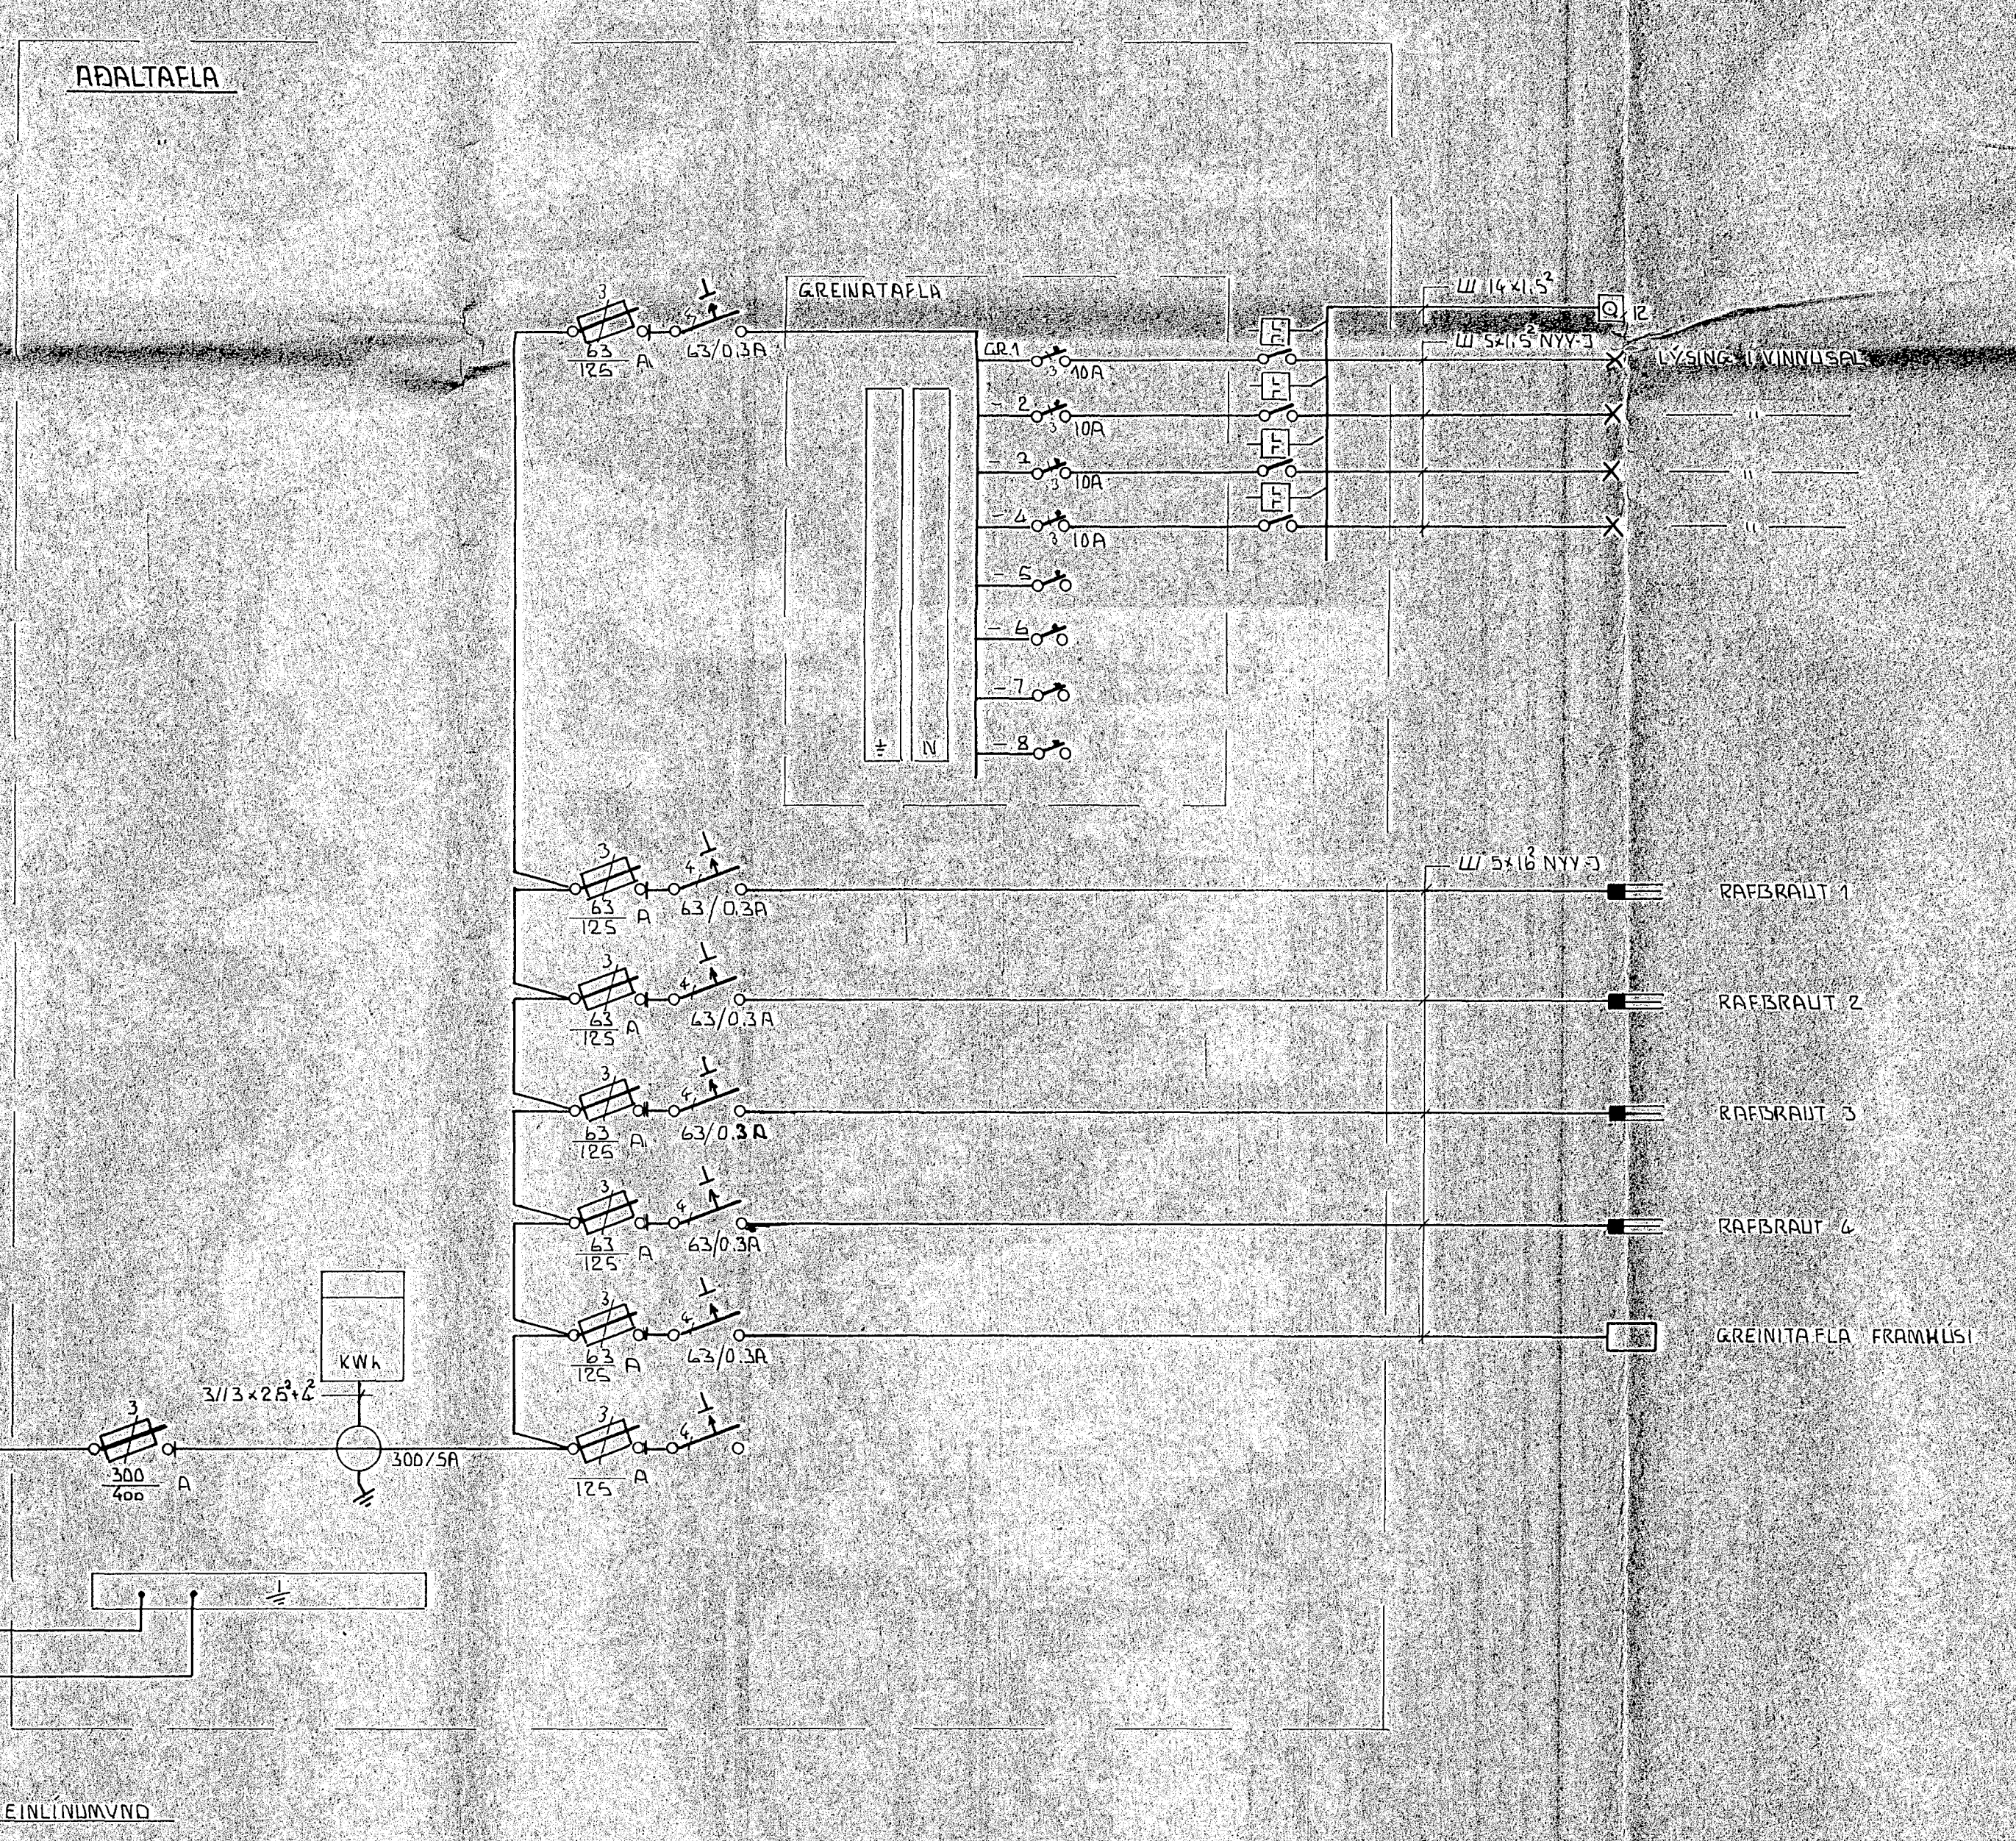

TEIKNING NR. 2462

		BÆJARHRAUN 24	
		GÖR HF	
		EINLÍNUNGVND AFSTÖÐUNGVND	
		SNID	
BR	DAGS	BREYTING	
TÆKNIPJÓUSTAN SF		LIANAD AK	KVARDI 1:100 1:500
LÁGMÖLA 5 - 105 REYKJAVÍK - Sími 52844		TEIKNAD AK	DAGS. SEPT 85
<i>Ólafur Ólafsson</i>		TEIKNAD	BL 1
		TEIKNAD	NR. AF