



DALSHRAUN 3

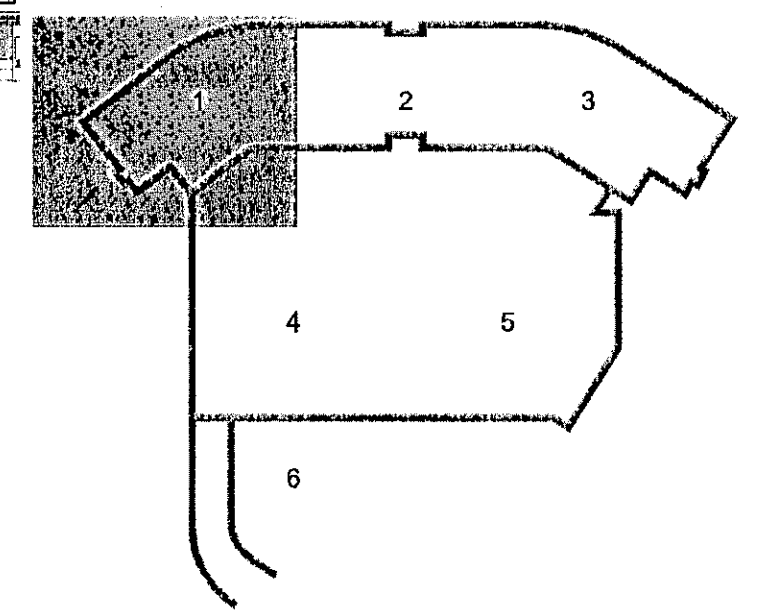

E	22.01.14	Reyndartekning	BSG/ÖG
D	23.09.13	Rafloagn & skrifstofum	BSG/ÖG
C	05.09.13	Merkingar v/ IVK og AKK	BSG/ÖG
B	08.08.13	Myndavélar	BSG/JAR
A	12.07.13	Rör vegna gólfboxa	BSG/ÖG
Útg. Dags.		Skýring	Hanna/Ýrifa/Þ

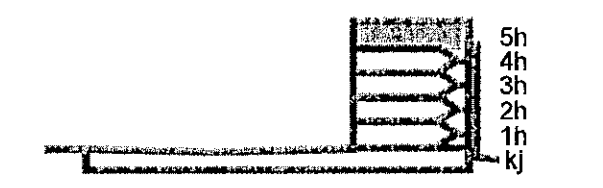

VERKFRÆÐISTOFA

BÆJARHRAUN 20 • 220 HAFNARFJÖRÐUR • KENNIT. 710796-2899
vab@vab.is • Sími 585 8600 • Fax 585 8610 • www.vsb.is

Áritun séðhórnúlar Örn Guðmundsson Kt: 220981 2739 • or@vab.is				
Verkefni DALSHRAUN 3 HAFNARFIRÐI				
Verkefni Rafkerfi Smáspenna 5.hæð Grunnmynd 1				
Hannað	Teiknað	Yfirfarið	Kvarði	Síða
JAR	JAR	OG	1:50	/ A1
Dags	Verkefni	Teikning	Útgáfa	
01.07.2013	07244	R3 051	E	