


TEKNISSKIPAN
DALSHRAUN 3
HAFNARFIRDI

DALSHRAUN 3

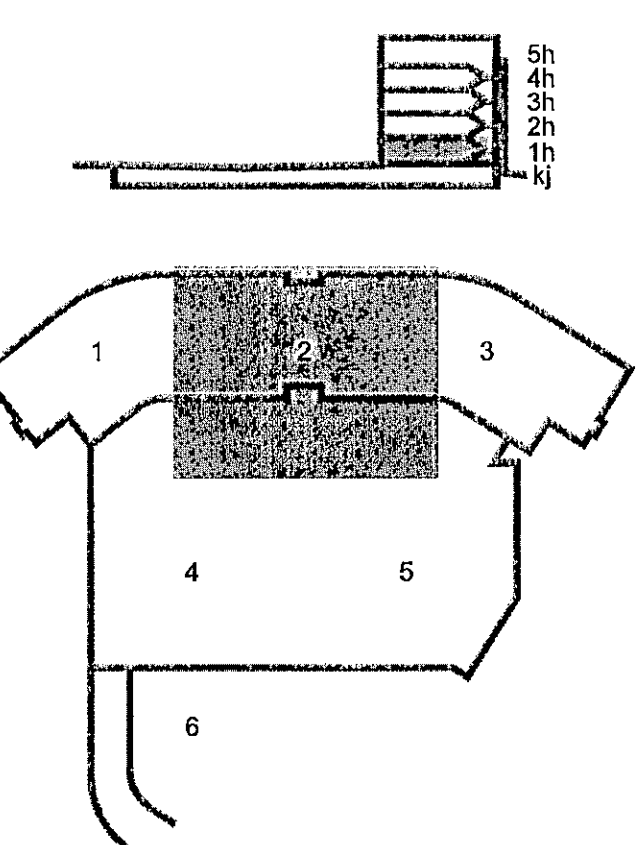

D	22.01.14	Reyndartekning	BSG/ÖG
C	05.09.13	Merkingar v/IVK og AKK	BSG/ÖG
B	08.08.13	Myndavélar	BSG/JAR
A	27.08.13	Ræfögn teiknað í skrifstofumí.	JAR/ÖG
Útg. Dags.		Skýring	Hanna/Ýfirfarð



VERKFRÆÐISTOFA

BÆJARHRAUN 20 • 220 HAFNARFJÖRÐUR • KENNIT. 710796-2899
vsb@vsb.is • Sími 585 8600 • Fax 585 8610 • www.vsb.is

Áritun sérhönnuðar Örn Guðmundsson Kt: 2209612739 • orn@vsb.is				
Verkiheiti DALSHRAUN 3 HAFNARFIRDI				
Verkiheiti Rafkerfi Smáspenna 1.hæð Grunnmynd 2				
Hannað	Teknað	Yfirfarð	Kvarði	Síða
VD	VD	BSG	1:50	/ A1
Dags.	Verkiheiti	Tekning	Útgáfa	
13.05.2008	07244	R3 012	D	