



VERKFRÆÐISTOFA  
DALSHRAUN 3

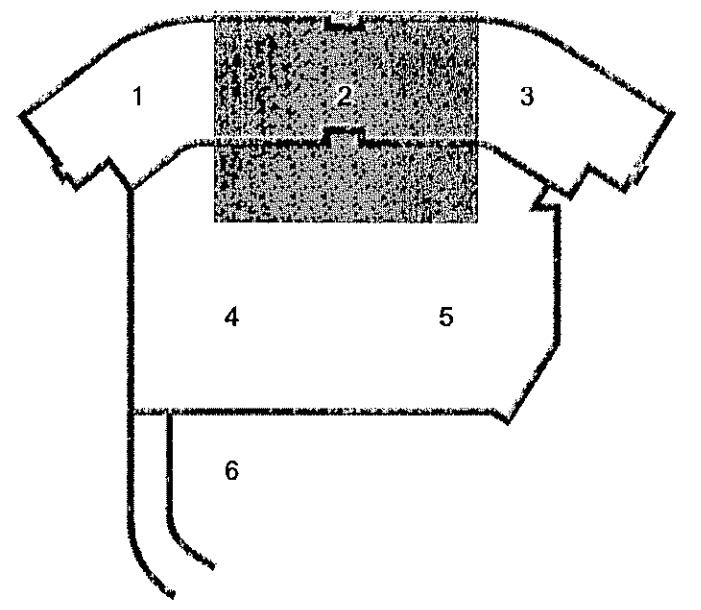

D	22.01.14	Reyndartekning	BSG/ÓG
C	27.08.13	Legnatelíðr, skýjarar ofan vó loft	BSG/ÓG
B	12.08.13	Ýmsar breytingar	JAR/JAR
A	09.07.13	Vegna innréttinga skrifstofurými Valtor	JAR/ÓG
Útg.	Dags.	Skýring	Hanna/Vyrfarið

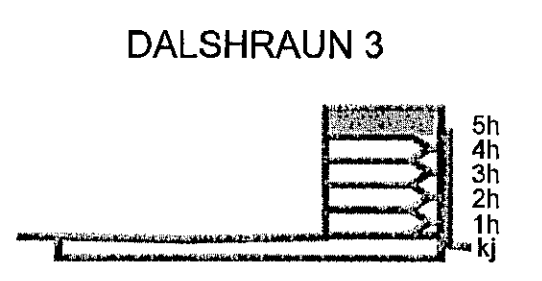

**VERKFRÆÐISTOFA**

BÆJARHRAUN 20 • 220 HAFNARFJÖRÐUR • KENNIT. 710796-2899  
vab@vab.is • Sími 585 8800 • Fax 585 8610 • www.vsb.is

Áritun sérhönnuðar  
Órn Guðmundsson  
Kt: 220961 2739 • orn@vab.is

Verkefni:  
**DALSHRAUN 3**  
**HAFNARFIRÐI**

Verkihluti:  
**Rafkerfi**  
**Brunaviðvörðunarkerfi 5.hæð**  
**Grunnmynd 2**

Hannað	Teknað	Yfirfarið	Kvarði	Síða
VD	VD	BSG	1:50	/ A1
Dags.	Verkefni	Tekning	Útgáfa	
03.06.2008	07244	R5 052	D	

V:\07244\07244\07244\DALSHRAUN 3\Skemmar\07244-R5-1.skd.dwg