


DALSHRAUN 3

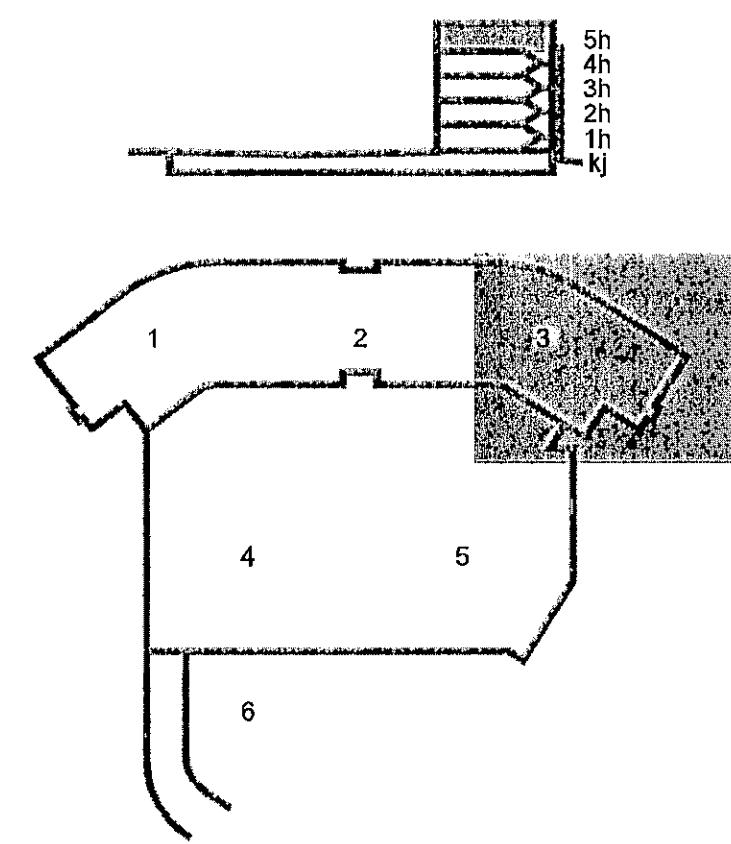

E	22.01.14	Reyndartekning	BSG/ÖG
D	06.09.13	Merkingar v/TVK og ANK	BSG/ÖG
C	08.08.13	Myndavélar. Stíllir og tengjar færðir	BSG/JAR
B	17.07.13	Rör og gét i gólf v/gólfboxa	BSG/ÖG
A	12.07.13	Rör vegna gólfboxa	BSG/ÖG
Útg. Dags.		Skýring	Hannað/Yfirfarð



VERKFRÆDISTOFA

BÆJARHRAUN 20 • 220 HAFNARFJÓRDUR • KENNIT. 710796-2899 vsb@vsb.is • Sími 585 8800 • Fax 585 8610 • www.vsb.is					
Áritun sérhönnuðar Örn Guðmundsson Kf: 220981 2739 • orng@vsb.is					
Verkefni DALSHRAUN 3 HAFNARFIRÐI					
Verkhúsi Rafkerfi Smáspenna 5.hæð Grunnmynd 3					
Hannað	Teknað	Yfirfarð	Kvarði	Síða	
JAR	JAR	ÖG	1:50	/ A1	-
Dags.	Verkefni	Tekning	Útgáfa		
01.07.2013	07244	R3 053	E		

V:\2007\07244\107244-Dalshraun_3\Sheets\A\07244-R3-5.hæð.0.dwg