

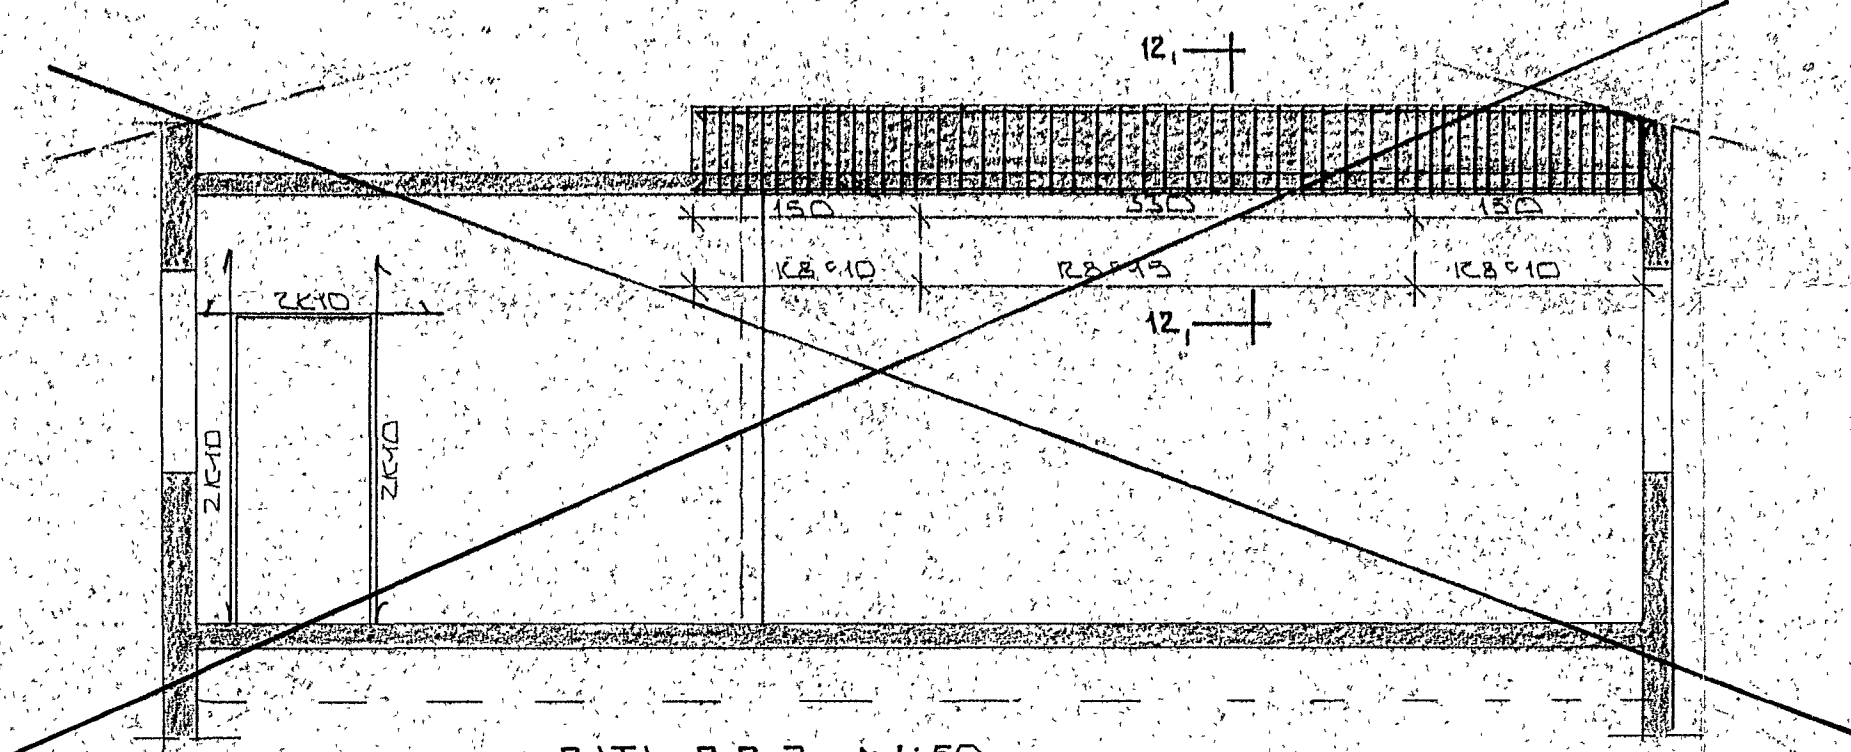
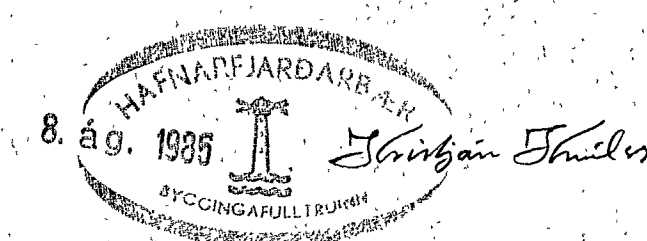
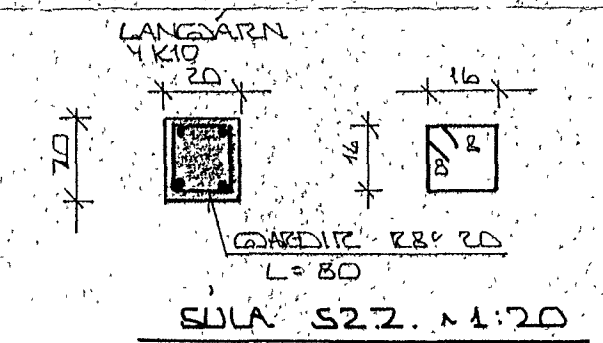


BITI B2.1. ~ 1:50

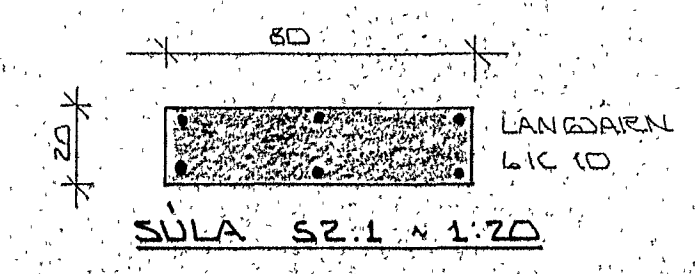

BITI B2.2. ~ 1:50

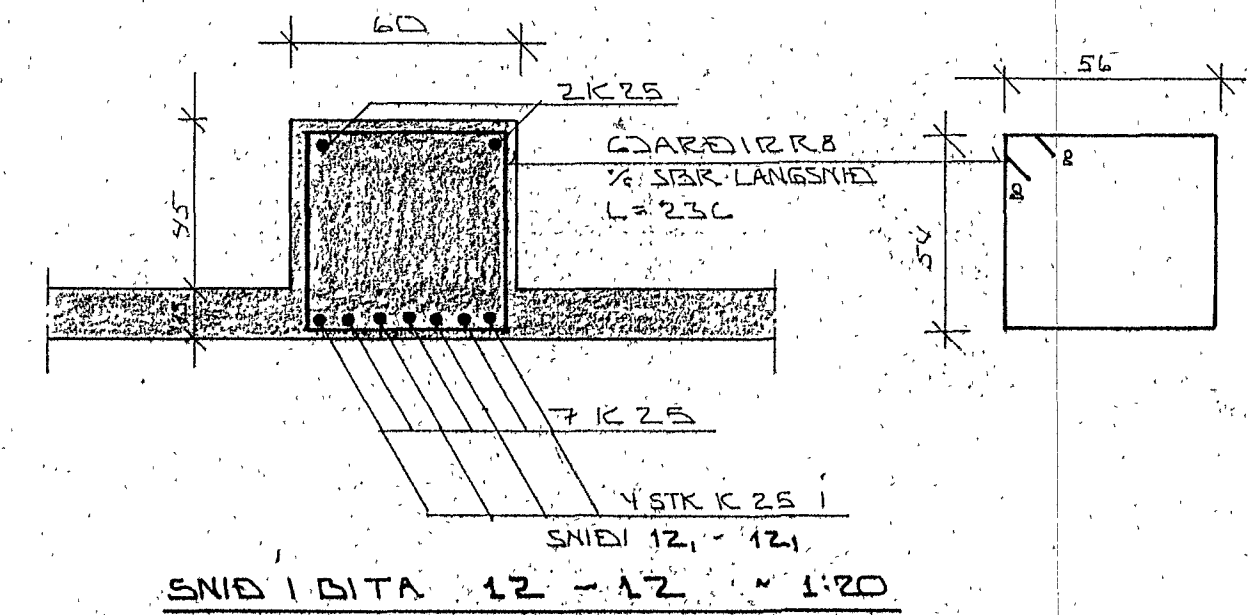

BR. NR.	DAGS	EDLI BREVTINGAR	SIGN.
STAPAHRJAIN 2 HAFNARFJÖRÐI			DAGS. FEBR. '85
JÄRNBENDING 2. HÆÐ - SÉRMYNDIR.			HANNAÐ
MÆLIKV. ~ 1:50 ~ 1:20			TEIKNADUR
SIGURÐUR ÞORLEIFSSON TEKNIFRÆÐINGUR F.T.F.I.			VERK NR. 834
STRANDGÖTU 11 HAFNARFJÖRÐI SIMI 54751			BLAD NR. 1-08