


STEYPLUGAÐI K-250
 JARN I EFRI BR PUNKTERUD
 ——— " NEDRI " HEILDREGIN
 ——— HER BEYGIST ANNAD HVERT
 JARN UPP I EFRI BRUN PLOTU

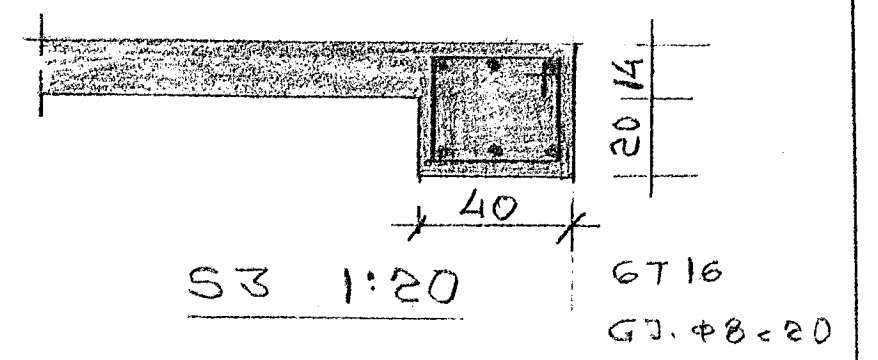

BREYTT 23-5-66 *DB*
 STRANDGATA 31 HAFNARF
 BLAD 5 LOFT YFIR KJALLARA
 HAFNARF MAI '66
Byggn. B. Steinhildsson
Gj. Steinhildsson
 BYGGINGAVERKFRÆÐINGAR